BEFORE YOU DIG, CALL 811
VIRGINIA ONE CALL CENTER
www.va811.org

THIS PORTION OF THESE DRAWINGS ARE BELIEVED TO BE A CORRECT REPRESENTATION OF ACTUAL FIELD CONDITIONS (WATER & SEWER), BUT ARE NOT WARRANTED AS SUCH.

J. Michael Stocks 12-3-2020

J. MICHAEL STOCKS, PE DATE:

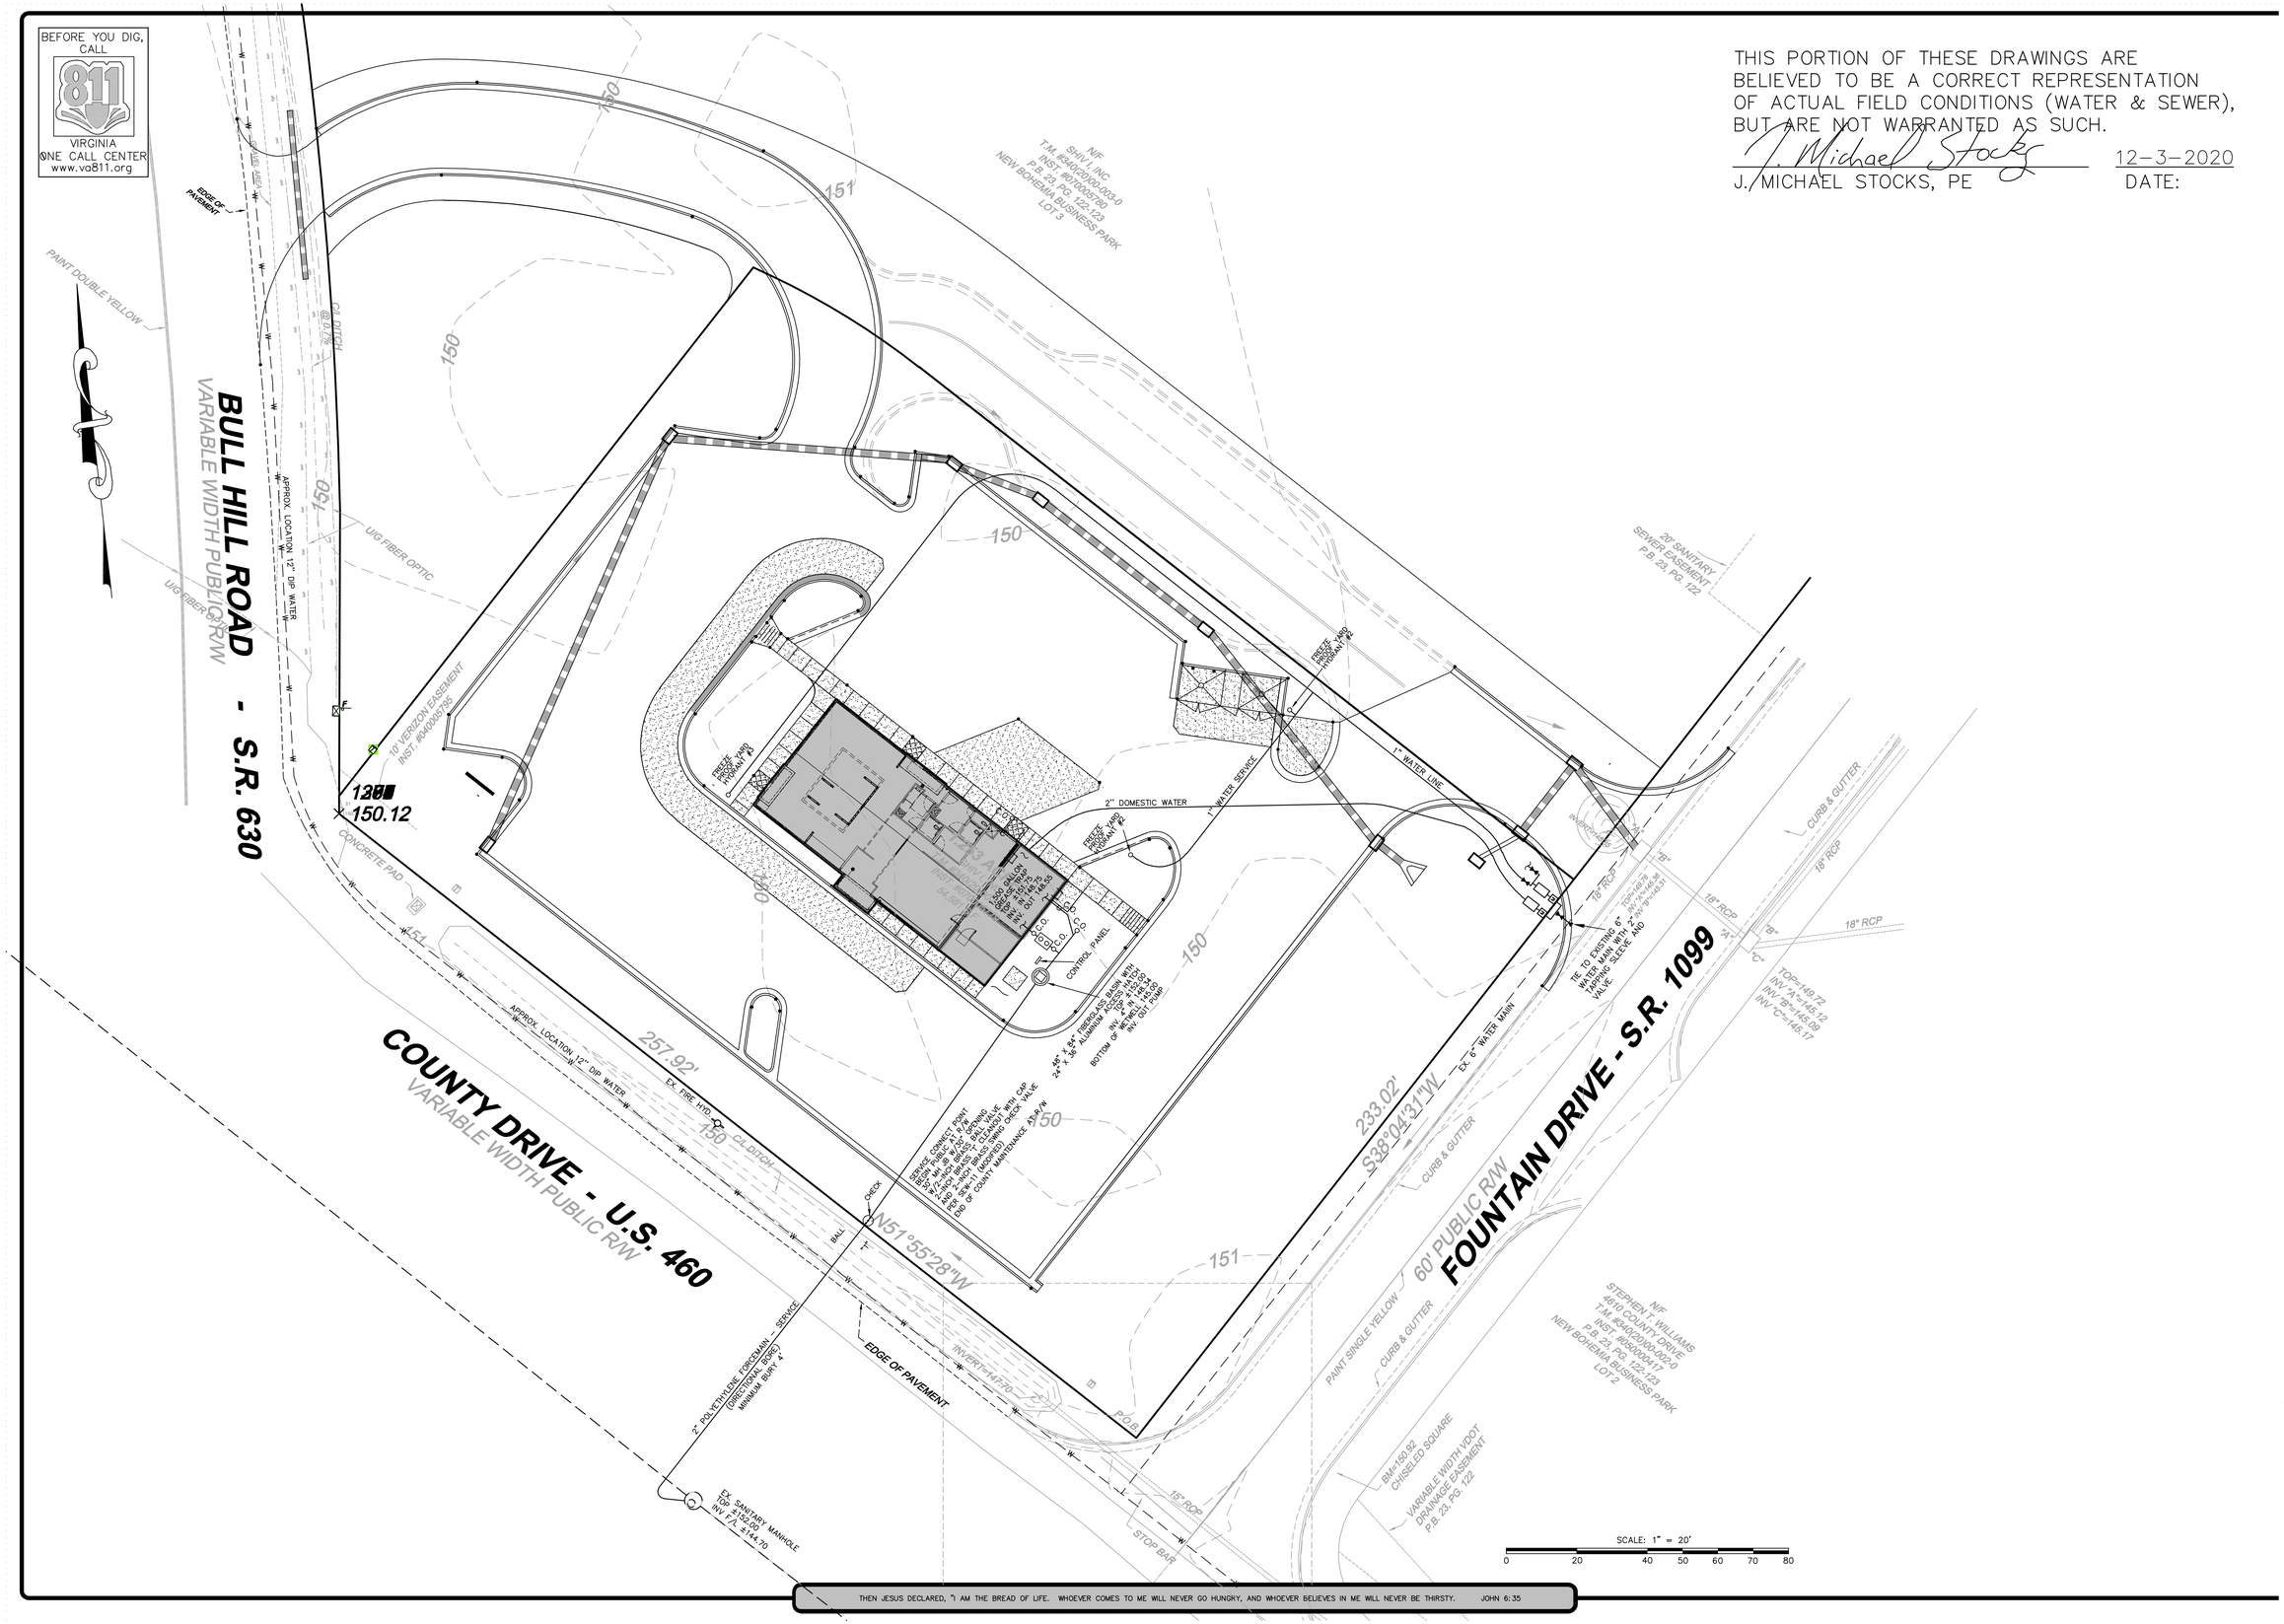

THEN JESUS DECLARED, "I AM THE BREAD OF LIFE. WHOEVER COMES TO ME WILL NEVER GO HUNGRY, AND WHOEVER BELIEVES IN ME WILL NEVER BE THIRSTY. JOHN 6:35

STOCKS ENGINEERING
801 EAST WASHINGTON STREET
NASHVILLE, N.C. 27856
WWW.STOCKSENGINEERING.COM
P.O. BOX 1108
PHONE: (252) 459-8196

BLN-C-1874

Hardee's CHARBROILED THICKBURGER

BODDIE-NOELL ENTERPRISES, INC.
P.O. BOX 1908
ROCKY MOUNT, N.C. 27802-1908
(252) 937-2800

HARDEE'S at PRINCE GEORGE COUNTY, VA.

COMMONWEALTH OF VIRGINIA
J. MICHAEL STOCKS
Lic. No. 053508
PROFESSIONAL ENGINEER
J. Michael Stocks
8/19/19

UTILITY AS-BUILT

REVISIONS
9/12/19 Sewer Revisions
12/6/19 PRINCE GEORGE REVIEW
2/13/20 PRINCE GEORGE REVIEW
2/28/20 VDOT COMMENTS
6/22/20 3/4" IRRIGATION
8/6/20 WATER SERVICE MOVED

FILE NO.	2017-013
HORZ. SCALE:	1"=20'
VERT. SCALE:	NONE

CE-04