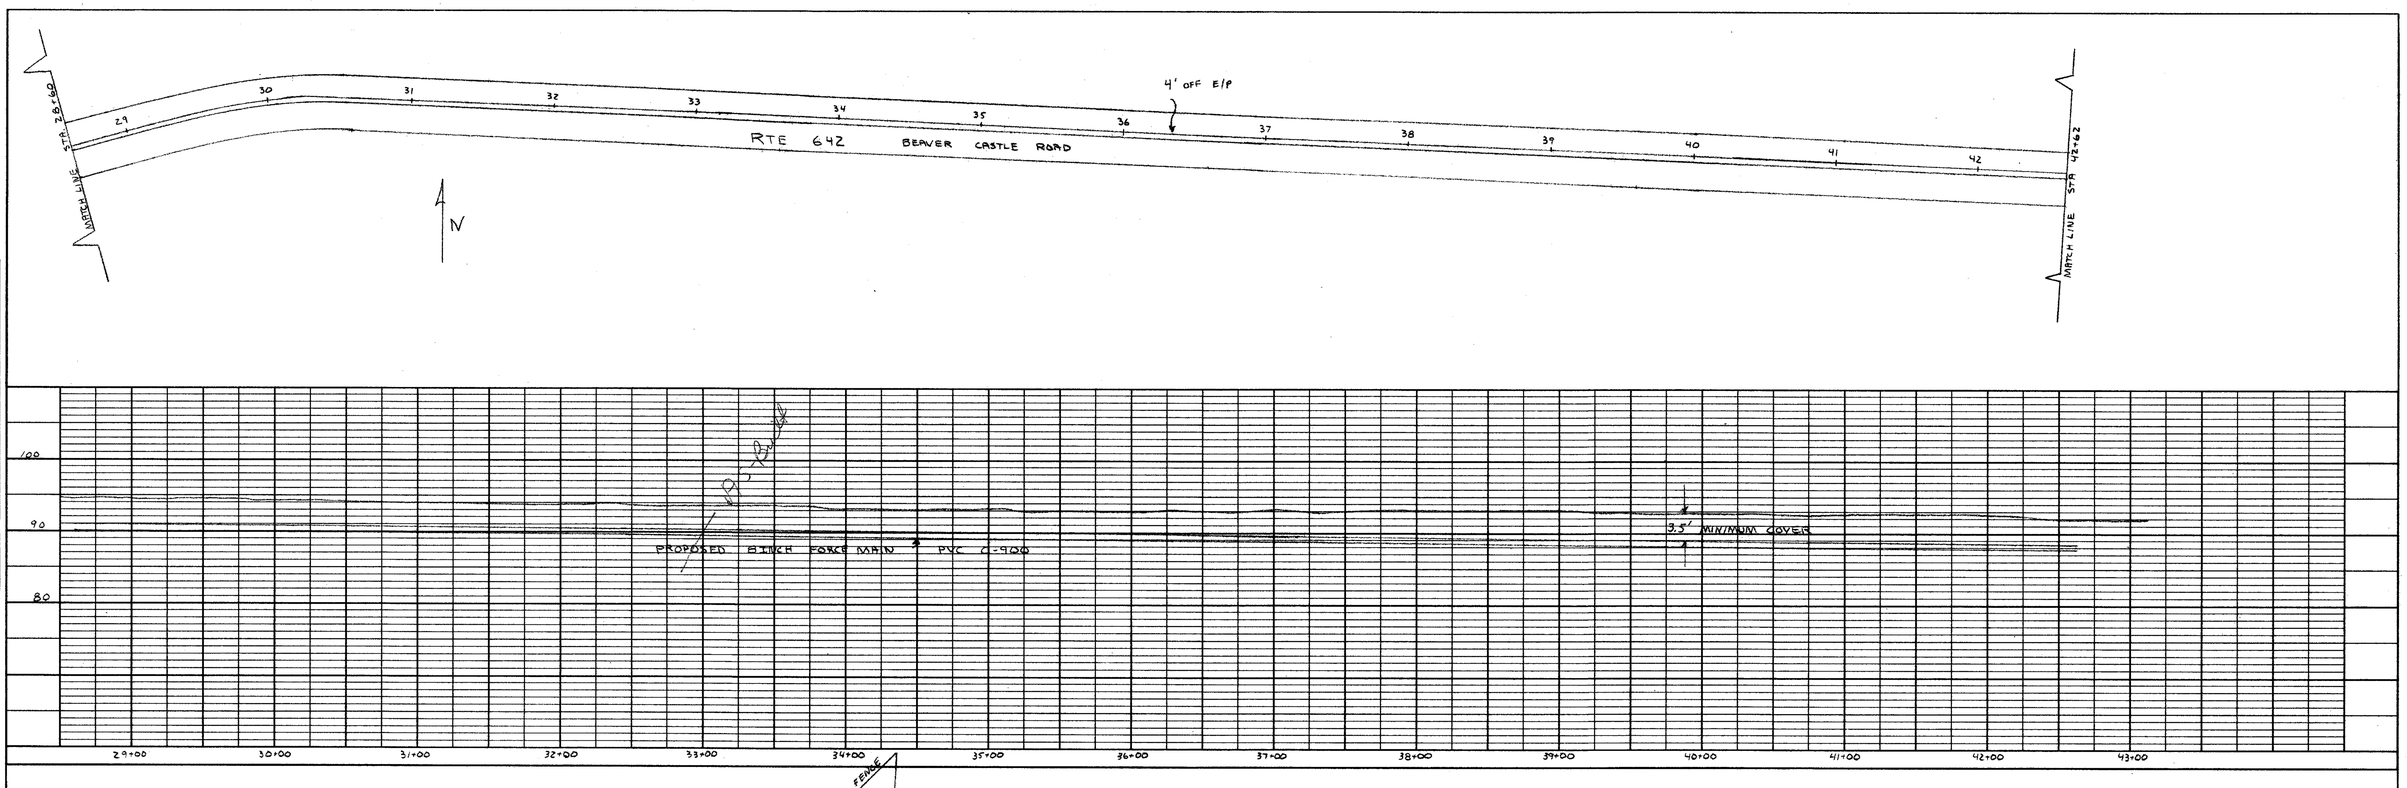

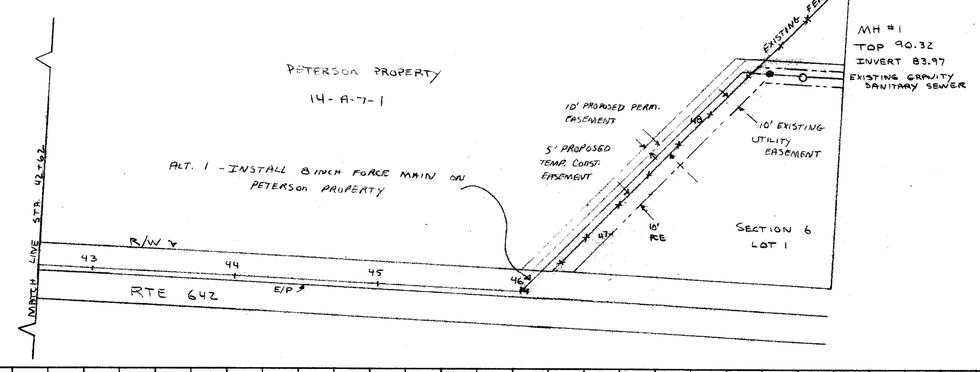

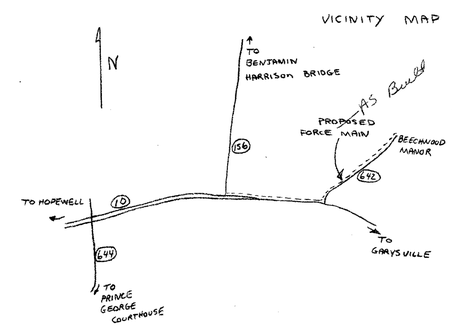

As-Built
9/90

COMMONWEALTH OF VIRGINIA
STEPHEN E. MCBRIDE
(LICENSE) No.
#14359
PROFESSIONAL ENGINEER

BEAVER CASTLE ROAD FORCE MAIN		
BY SEM	APD.	REV.
CKD. SEM	SCALE 1" = 50'	DATE 7-19-90
PRINCE GEORGE COUNTY, VIRGINIA Office of the County Engineer		SHEET 2 OF 2

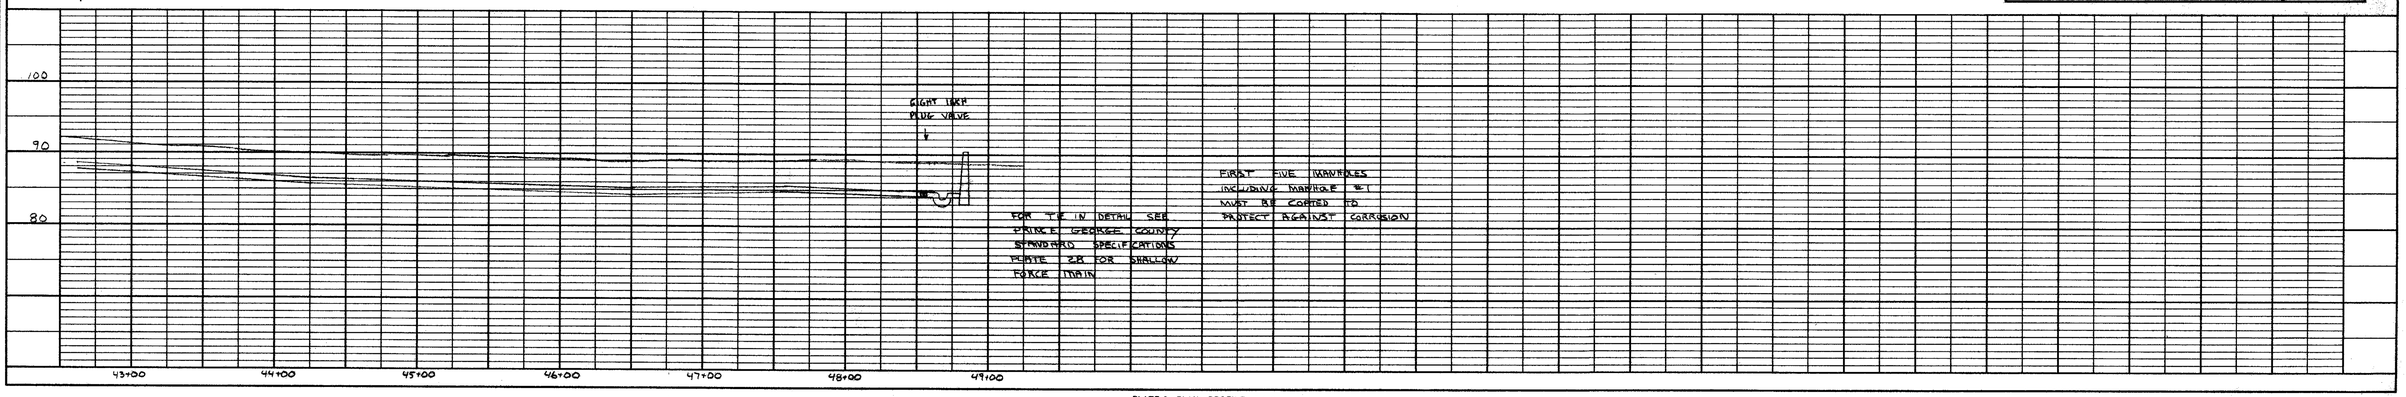

FOR TIE IN DETAIL SEE PRINCE GEORGE COUNTY STANDARD SPECIFICATIONS PLATE 2B FOR SHALLOW FORCE MAIN

FIRST FIVE MANHOLES INCLUDING MANHOLE #1 MUST BE COATED TO PROTECT AGAINST CORROSION

PLAN
SURVEYED.
PLOTTED.
ALIGNMENT CHECKED.
RT. OF WAY CHECKED.
NOTE BOOK
NO.
BY
DATE

PROFILE
SURVEYED.
PLOTTED.
GRADES CHECKED.
BL & NOTED.
STRUCTURE NOTATNS CHK'D
NOTE BOOK
NO.
BY
DATE