FB 509-10

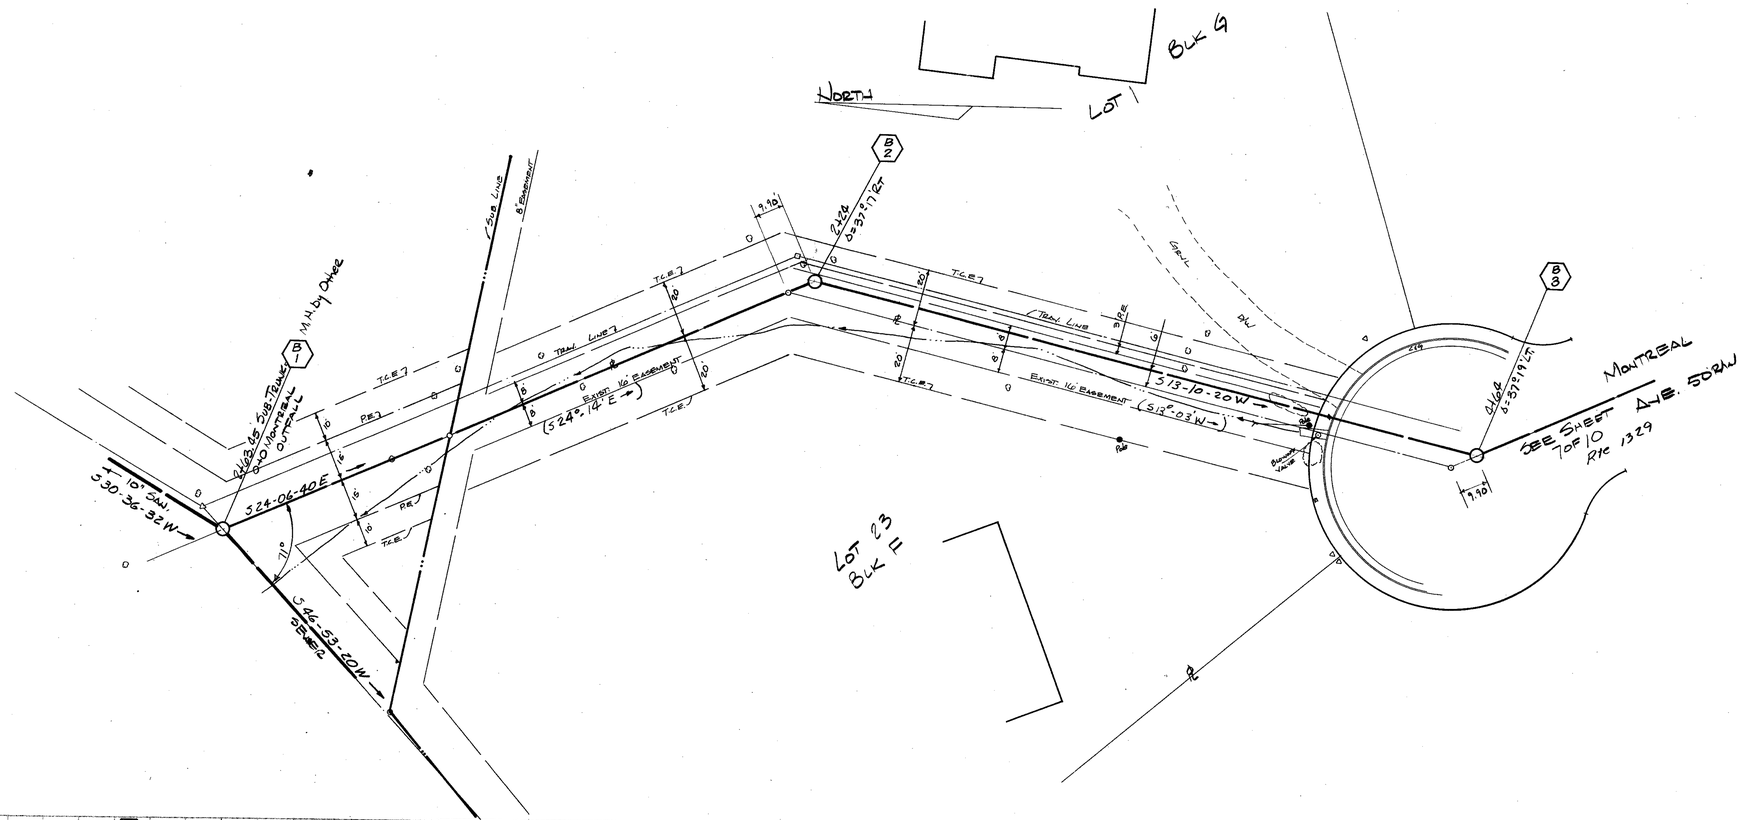


SUBDIVISION BEARINGS ARE IN PARENTHESIS
SEWER LINE BEARINGS ARE WITHOUT PARENTHESIS

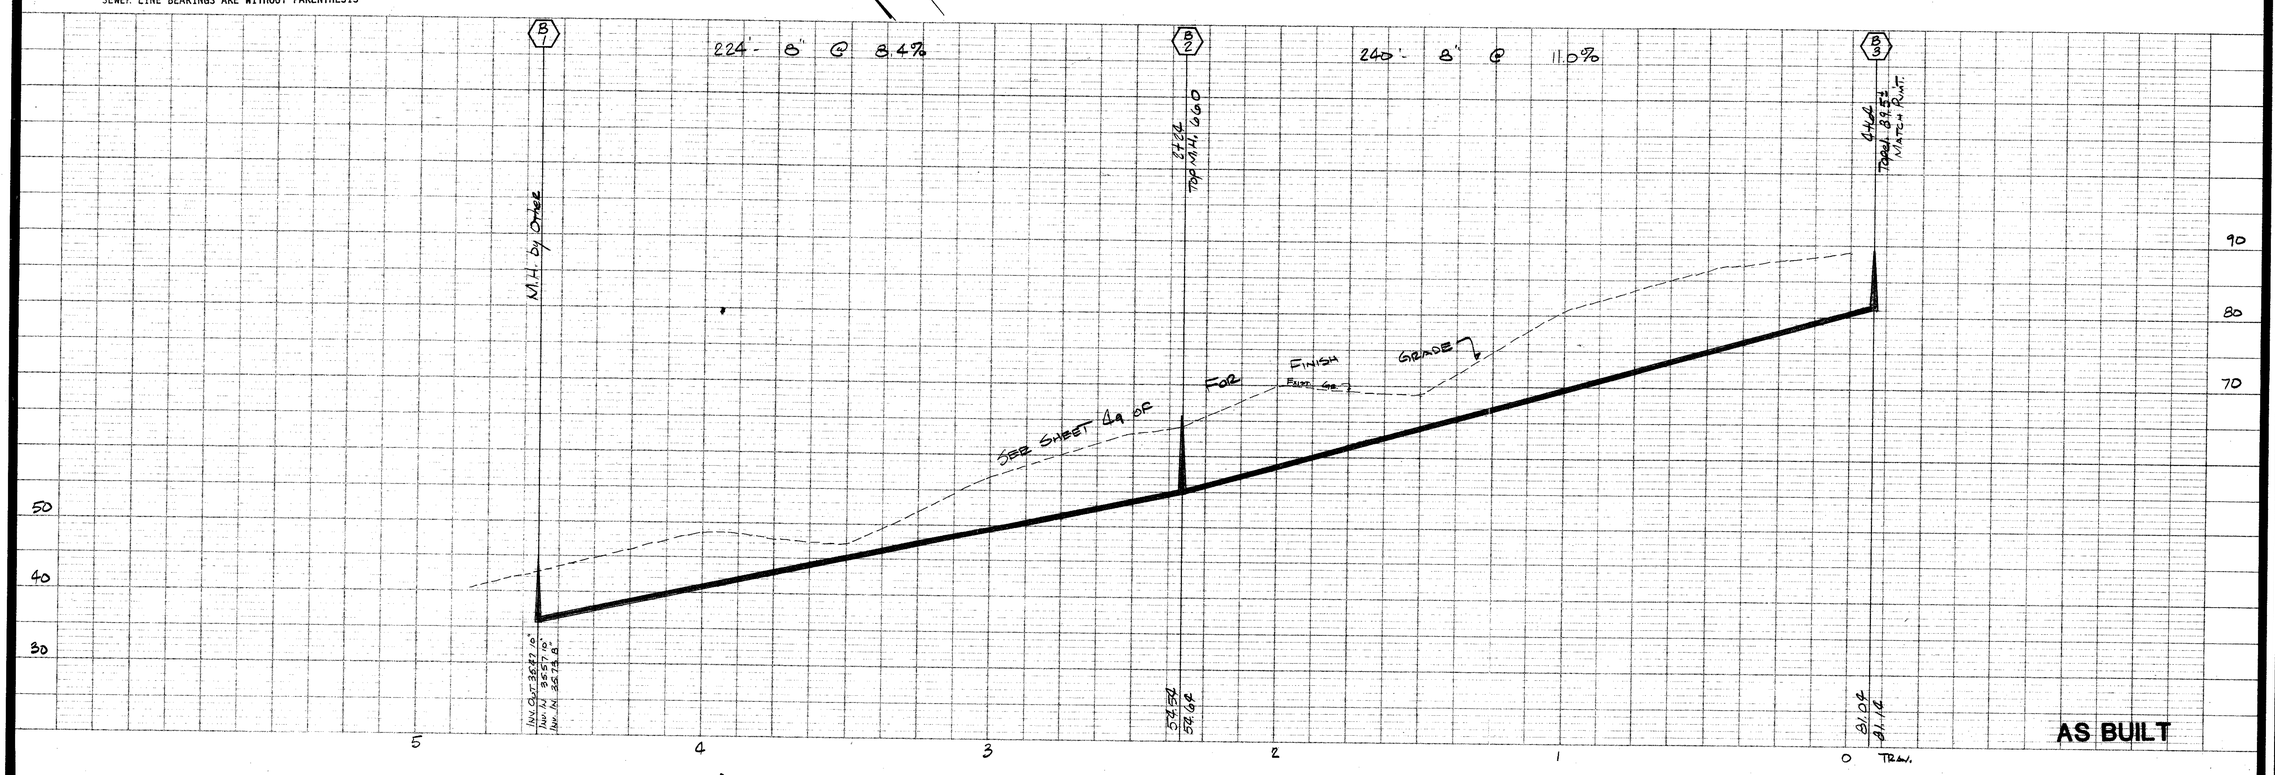


AS BUILT

N36742

J. K. TIMMONS & ASSOCIATES, INC.
ENGINEERS · SURVEYORS · PLANNERS
711 NORTH COURTHOUSE RD. (804) 794-3500 RICHMOND, VIRGINIA 23235
8803 STAPLES MILL RD. (804) 262-7396 RICHMOND, VIRGINIA 23228

J. K. TIMMONS & ASSOCIATES, INC. · CONSULTING ENGINEERS

REVISIONS

COMMONWEALTH OF VIRGINIA
WALTER M. ALTMAN III
LICENSE NO
11039
PROFESSIONAL ENGINEER

STAMP
As Noted
SCALE
JMA
DRAWN BY
3-20-85
DATE DRAWN
JMA
DESIGNED
WMA
CHECKED
SHEET NUMBER
8407-06
JOB NUMBER

Montreal Outfall