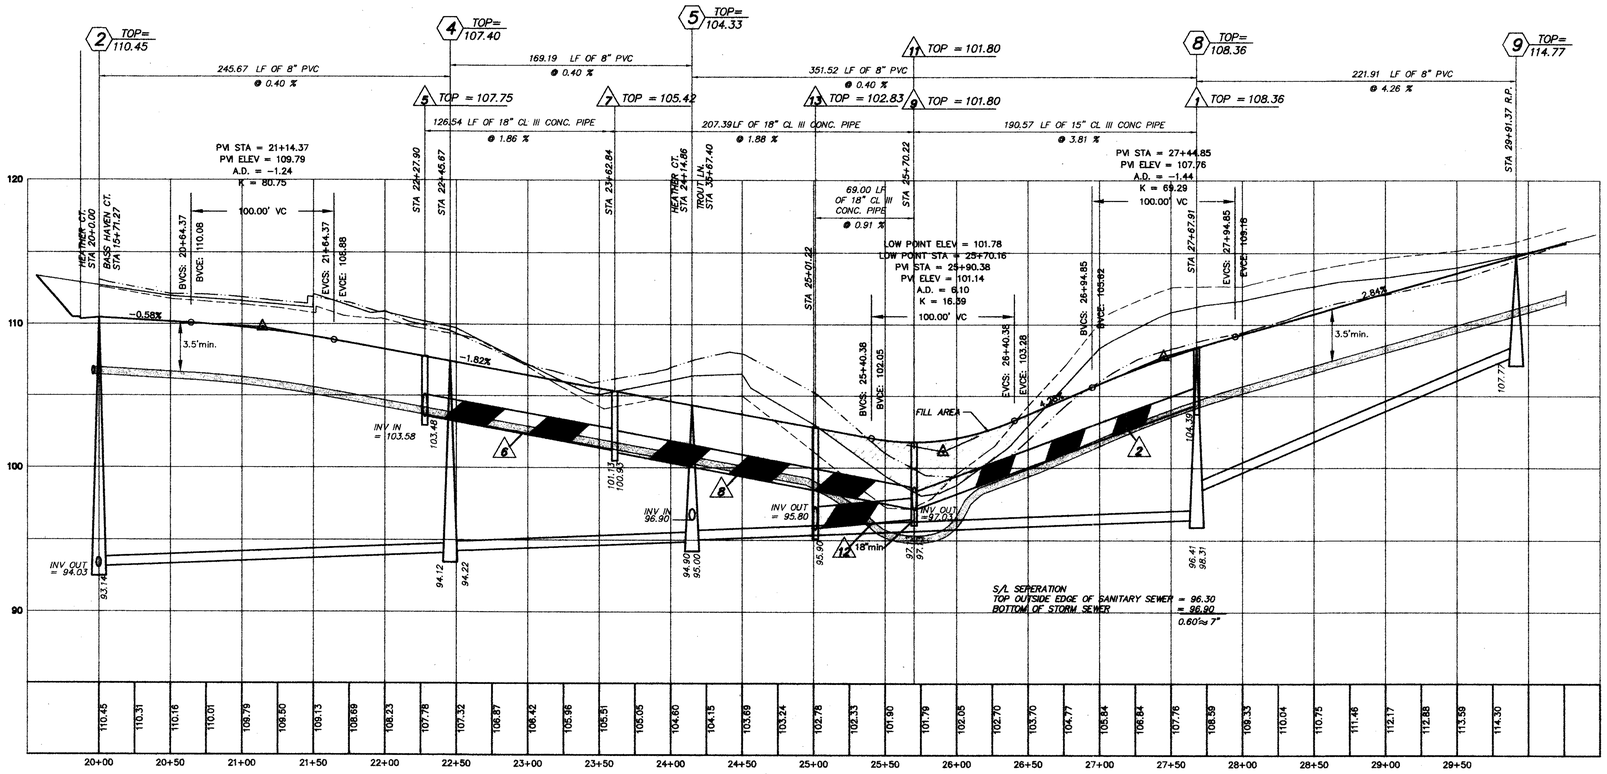

~~HEATHER COURT~~

NICOLAS

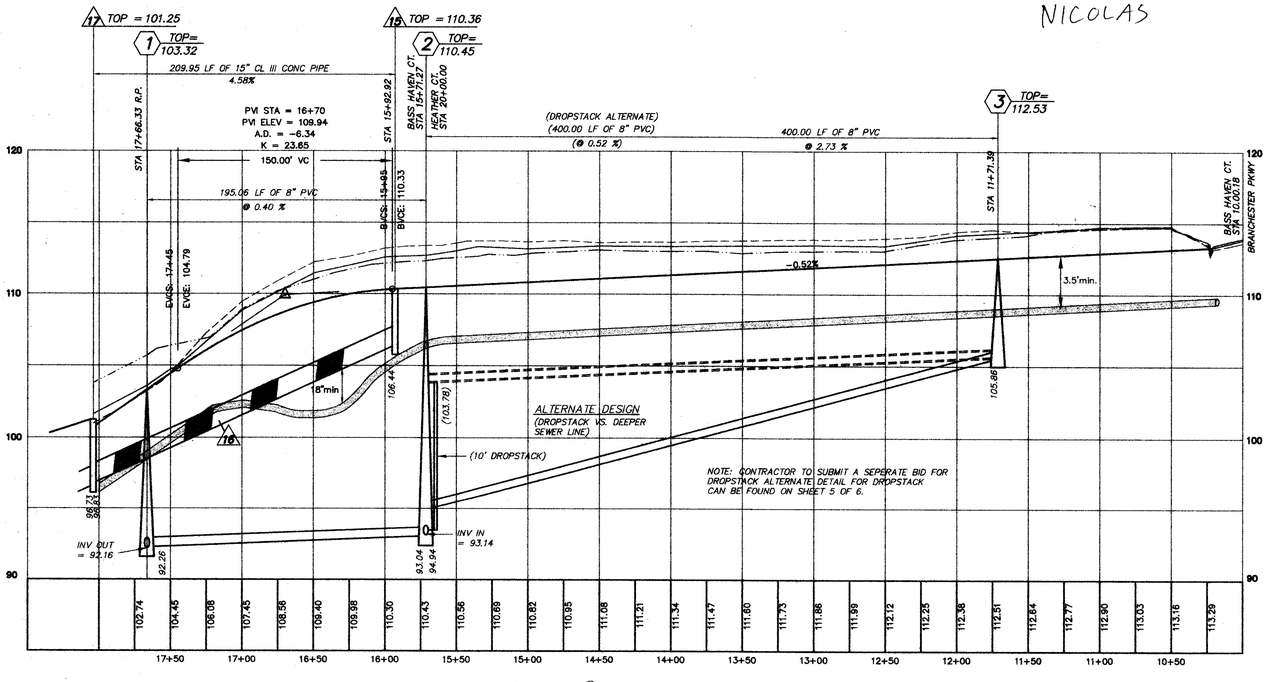

BLAIR

~~BASS HAVEN COURT~~

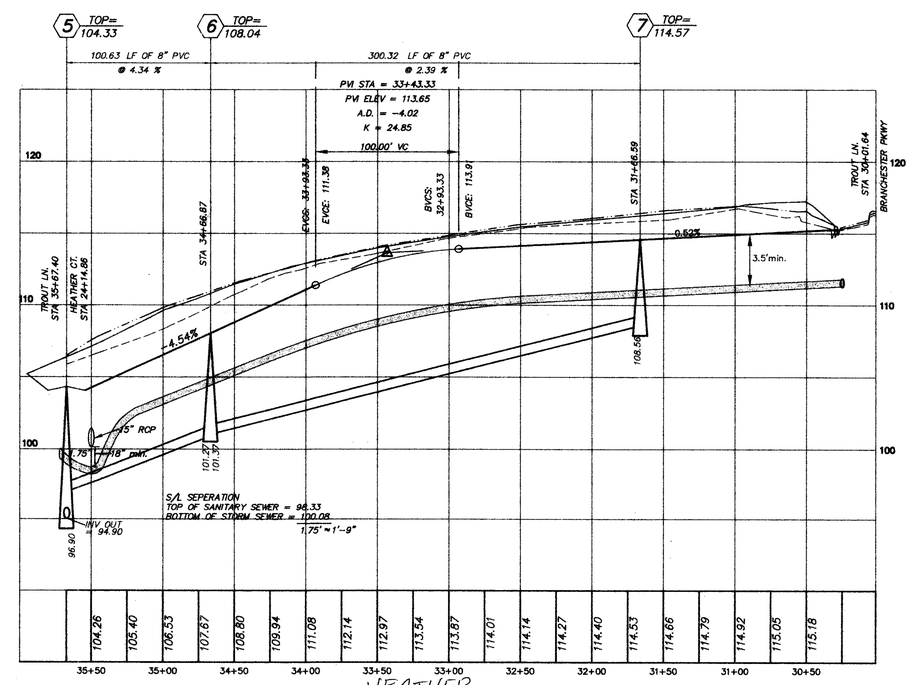

HEATHER

~~TROUT LANE~~

KEY	
25' RIGHT	
EXIST. GRADE	
PROP. GRADE	
25' LEFT	

SCALE
HORIZONTAL: 1"=50'
VERTICAL: 1"=5'

FINAL

THIS DRAWING PREPARED AT THE PRINCE GEORGE OFFICE

COMMONWEALTH OF VIRGINIA
DERRICK A. JOHNSON
No. 24761
PROFESSIONAL ENGINEER

CORPORATE HEADQUARTERS: 711 N. COURTHOUSE ROAD, RICHMOND, VIRGINIA 23236-4495, TELEPHONE: (804) 794-7539, FAX: (804) 794-7539
HENRICO OFFICE: 8603 STAPLES MILL ROAD, HENRICO, VIRGINIA 23228-1914, TELEPHONE: (804) 262-3500, FAX: (804) 286-7219
PRINCE GEORGE OFFICE: 4411 CROSSINGS BLVD., PRINCE GEORGE, VIRGINIA 23875-1455, TELEPHONE: (804) 732-7300, FAX: (804) 732-7301
HANOVER OFFICE: 5601 MECHANICSVILLE TURNPIKE, MECHANICSVILLE, VIRGINIA 23111-4623, TELEPHONE: (804) 746-9370, FAX: (804) 731-0798

ENGINEERS * ARCHITECTS * SURVEYORS * LANDSCAPE ARCHITECTS * ENVIRONMENTAL SCIENTISTS * GEOGRAPHIC INFORMATION SYSTEMS CONSULTANTS * CONSTRUCTION MANAGERS

TIMMONS Founded 1953

DATE	REVISION DESCRIPTION
2-20-96	OWNER REVISIONS

DATE	8-21-95
DRAWN BY	S.T.P
DESIGNED BY	S.T.P
CHECKED BY	D.A.J
SCALE	AS SHOWN

BRANCHESTER LAKES – SECTION 13

BLAND DISTRICT * PRINCE GEORGE COUNTY, VIRGINIA

ROAD PROFILES

JOB NO. 16391-05

SHEET NO. 4 OF 6