1. ASPHALT PAVED DITCHES TO BE REPLACED WITH 4" THICK S-5 BITU CONC TO BE SAME CROSS SECTION AND DEPTH AS EXISTING DITCH.
2. ALL AREAS DISTURBED OUTSIDE SPECIFIED MAXIMUM PAY LINES TO BE REPLACED BY CONTRACTOR AT NO ADDITIONAL COST.
3. ALL DISTURBED DITCH AND SHOULDER AREAS TO BE REPLACED TO THE SAME CROSS SECTION AS EXISTING
4. ALL PAVEMENT CUTS TO BE SAW CUT
5. WHERE THE EXISTING PAVEMENT DEPTH EXCEEDS SPECIFIED DEPTH THE CONTRACTOR SHALL MATCH EXISTING. COMPENSATION EXTRA SHALL BE AT CONTRACT UNIT PRICE.

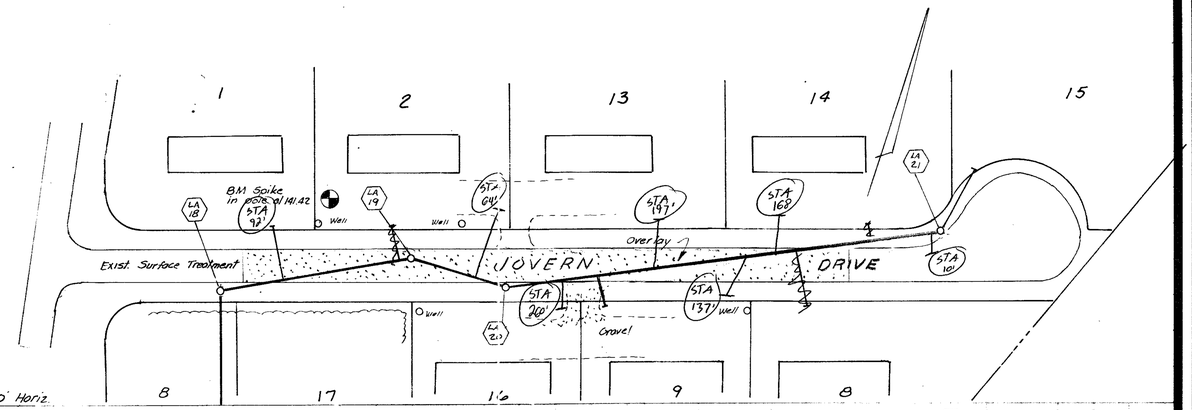

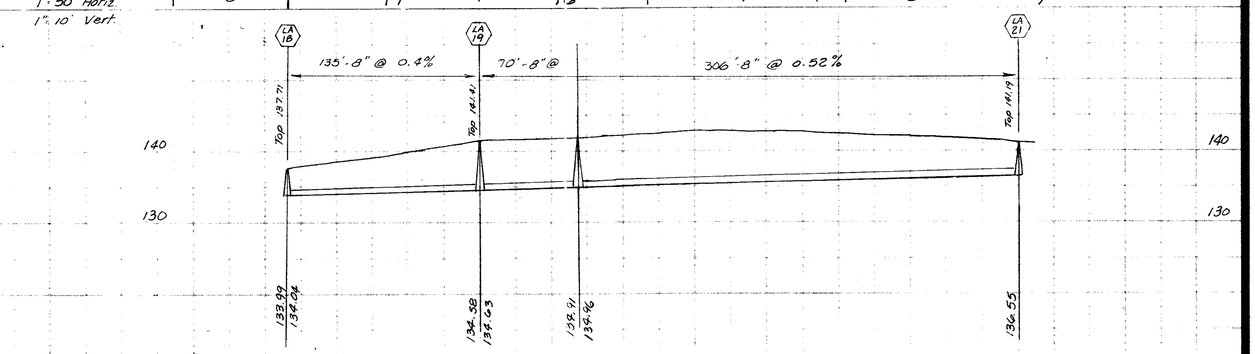

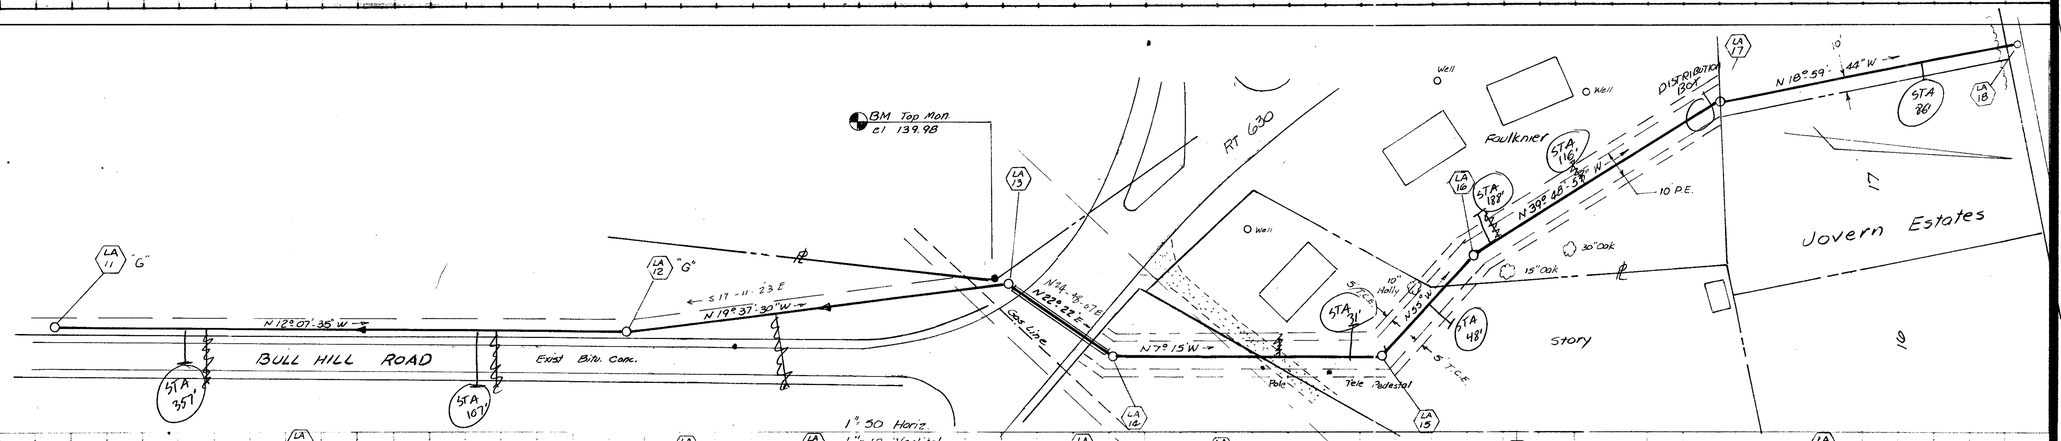

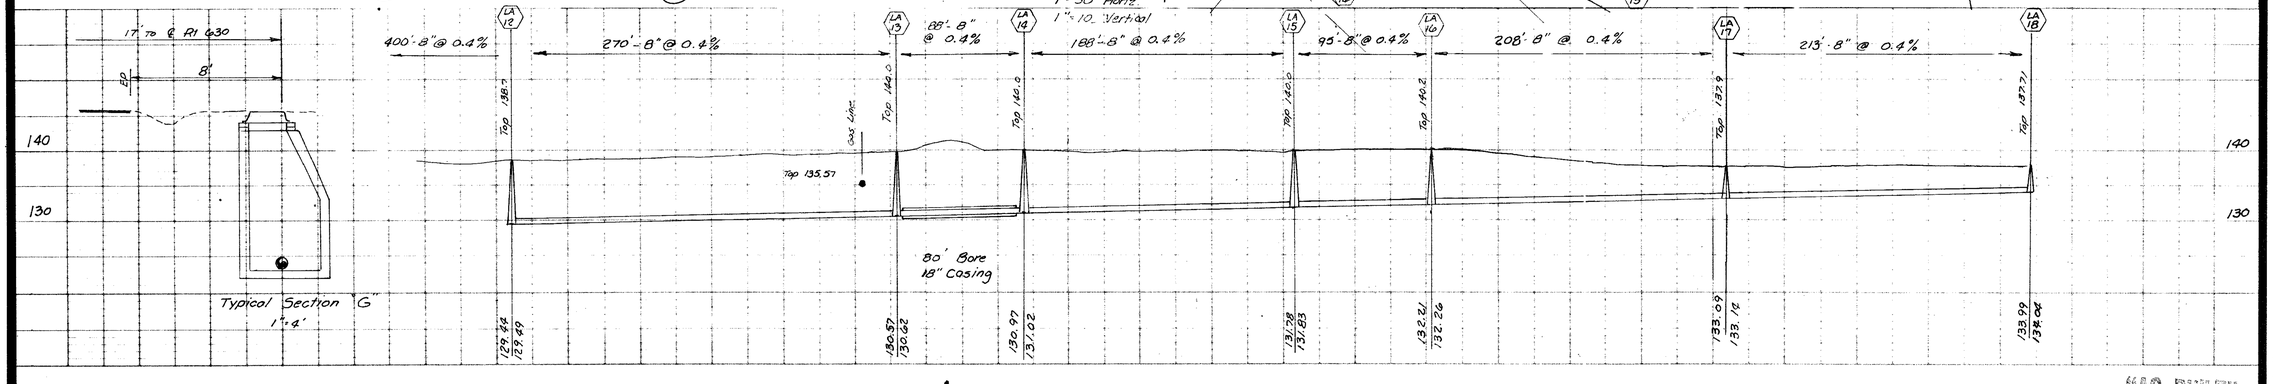

"AS-BUILT"

J. K. TIMMONS & ASSOCIATES, INC.
ENGINEERS · SURVEYORS · PLANNERS

711 NORTH COURTHOUSE RD. (804) 794-3500 RICHMOND, VIRGINIA 23235
8803 STAPLES MILL RD. (804) 262-7396 RICHMOND, VIRGINIA 23228

COMMONWEALTH ACRES
LEE ACRES SEWER IMPROVEMENTS

JOVERN ESTATES

8-22-85
10-11-85
5-13-86
REVISIONS

COMMONWEALTH OF VIRGINIA
WALTER M. ALTMAN III
LICENSE NO 11039
PROFESSIONAL ENGINEER

STAMP
As Shown
SCALE
WMA
DRAWN BY
5-13-86
DATE DRAWN
WMA
DESIGNED
CHECKED
12 of 13
SHEET NUMBER
8504-10
JOB NUMBER