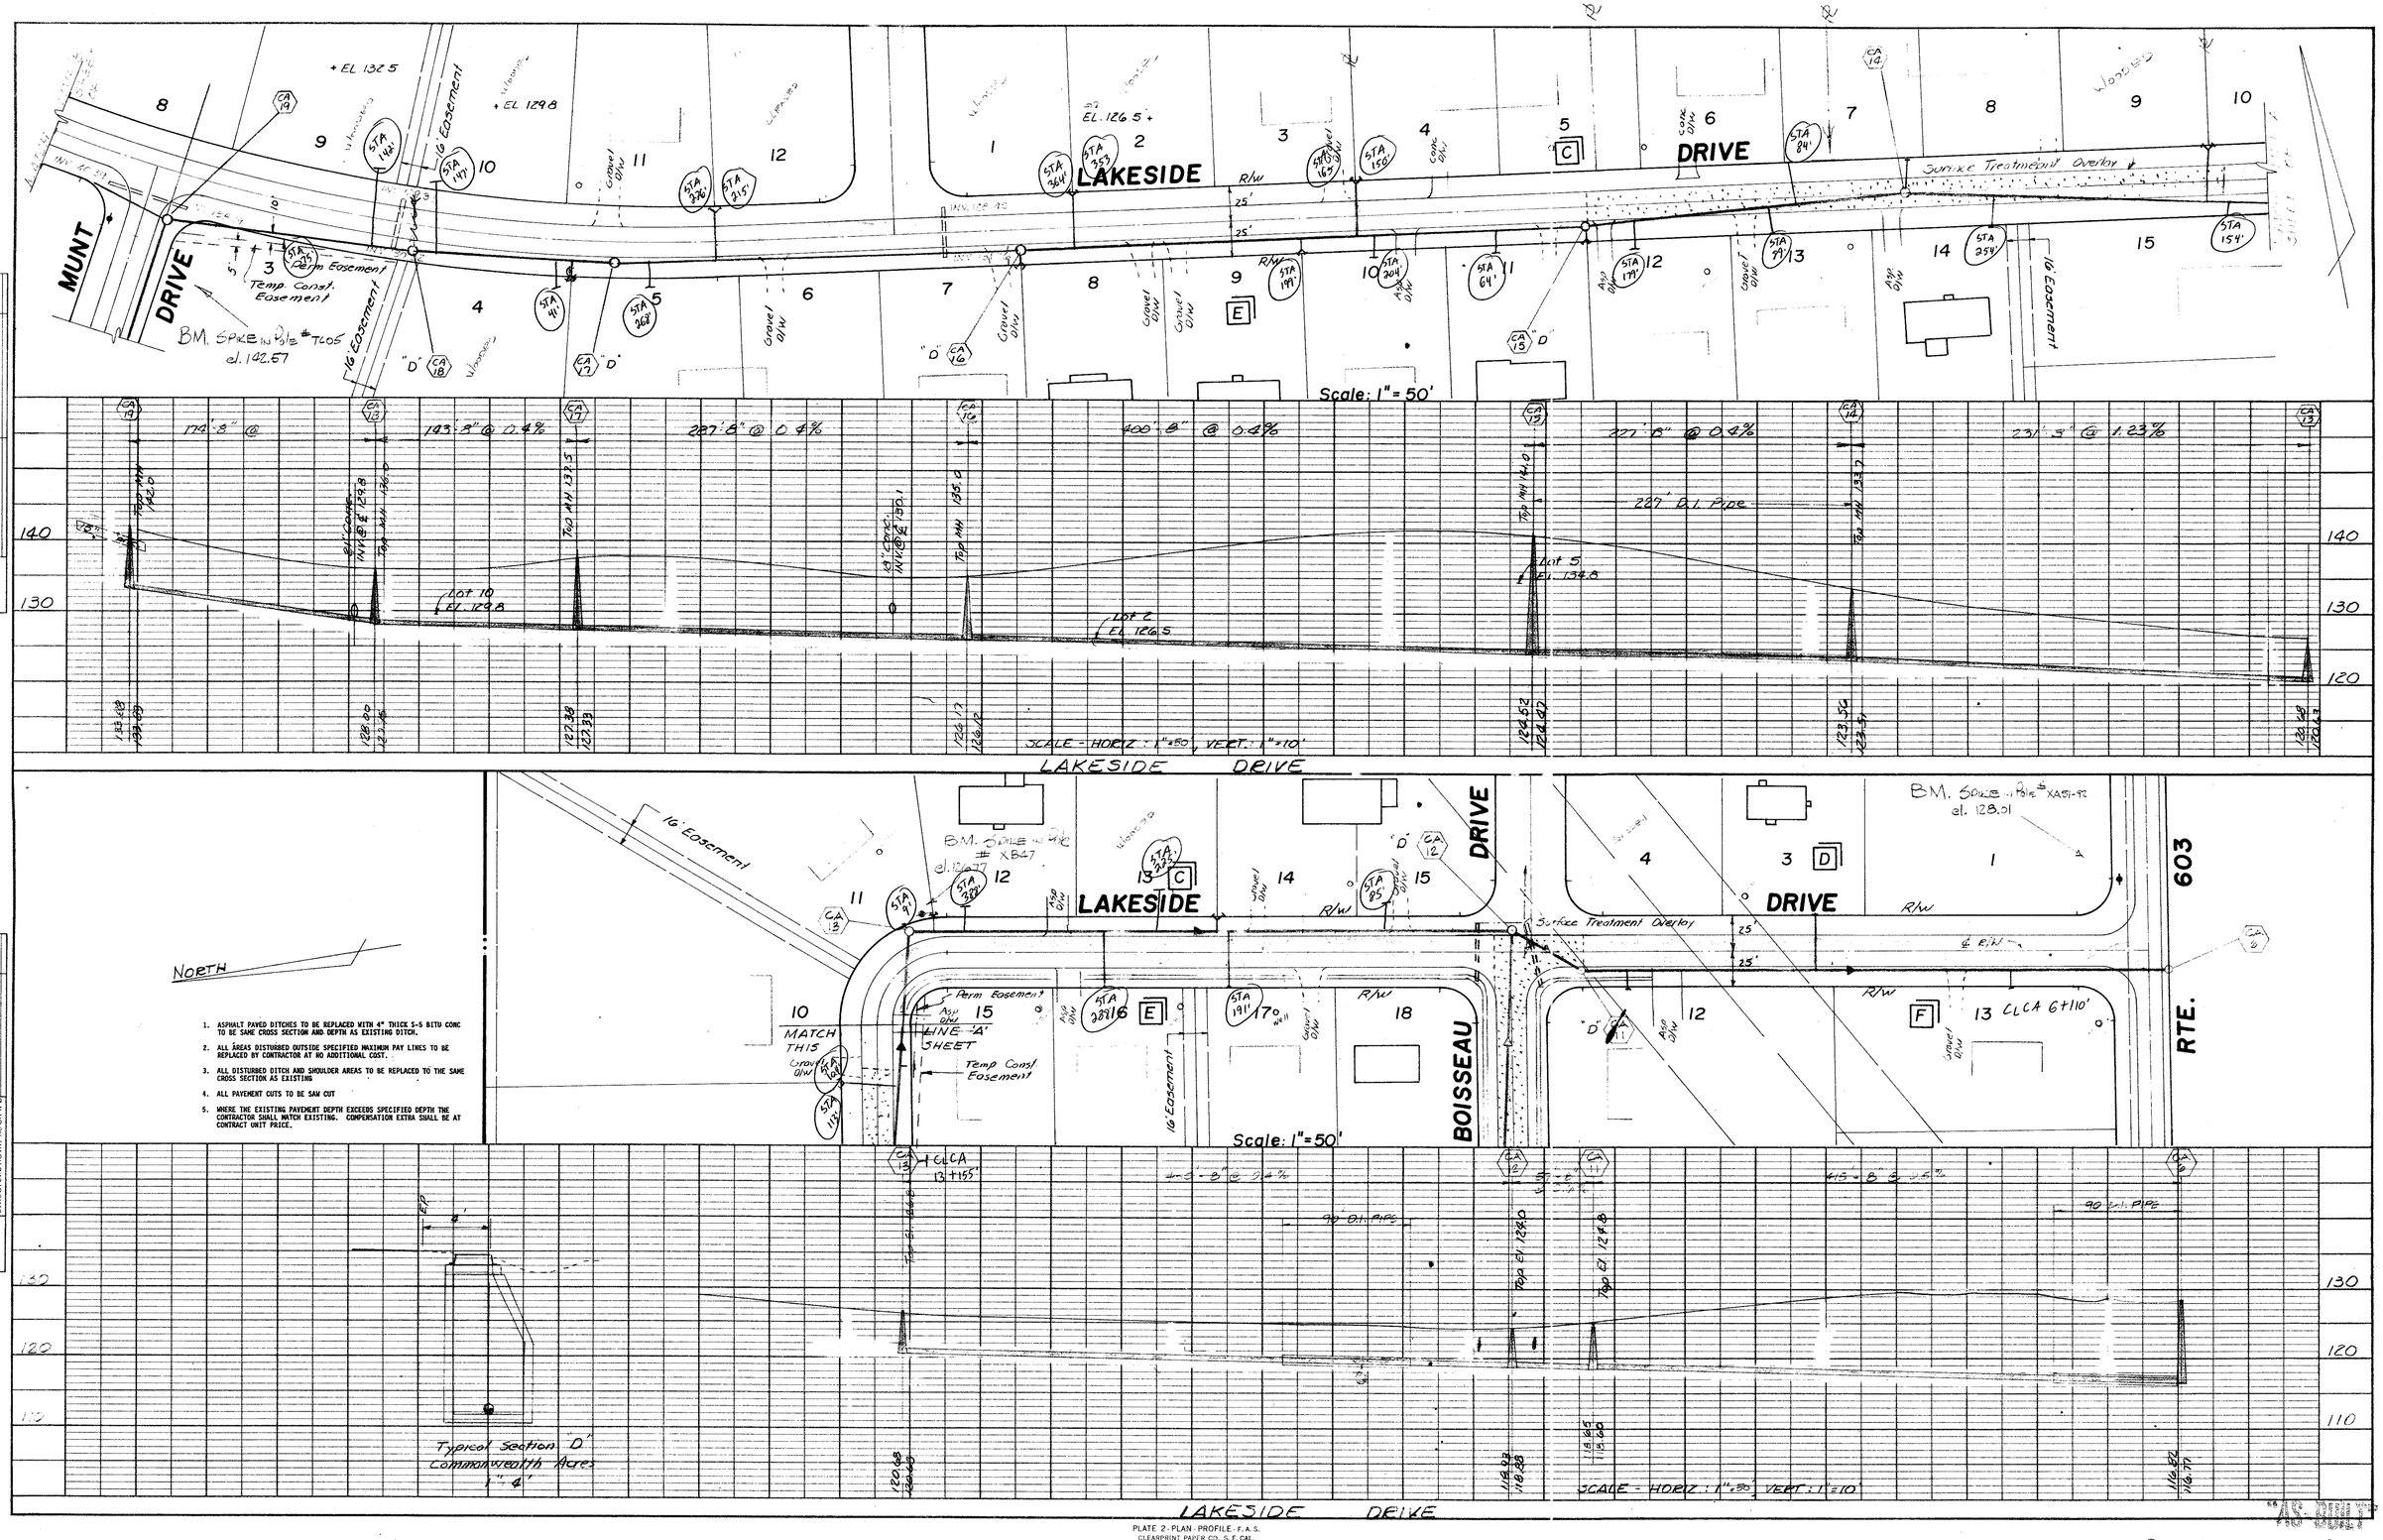

PLAN — SURVEYED, PLOTTED, ALIGNMENT CHECKED, RT. OF WAY CHECKED — NOTE BOOK — NO. — BY — DATE

PROFILE — SURVEYED, PLOTTED, GRADES CHECKED, B.M. & NOTED, STRUCTURES NOTATIONS CH'K'D — NOTE BOOK — NO. — BY — DATE

PLATE 2 - PLAN - PROFILE - F. A. S.
CLEARPRINT PAPER CO., S. F. CAL.
No. 1000H-2

"AS-BUILT"

Rev 1-26-86 Rev 8-22-85 State Req.
Rev 10-11-85

Commonwealth Acres

Sheet 5 of 13