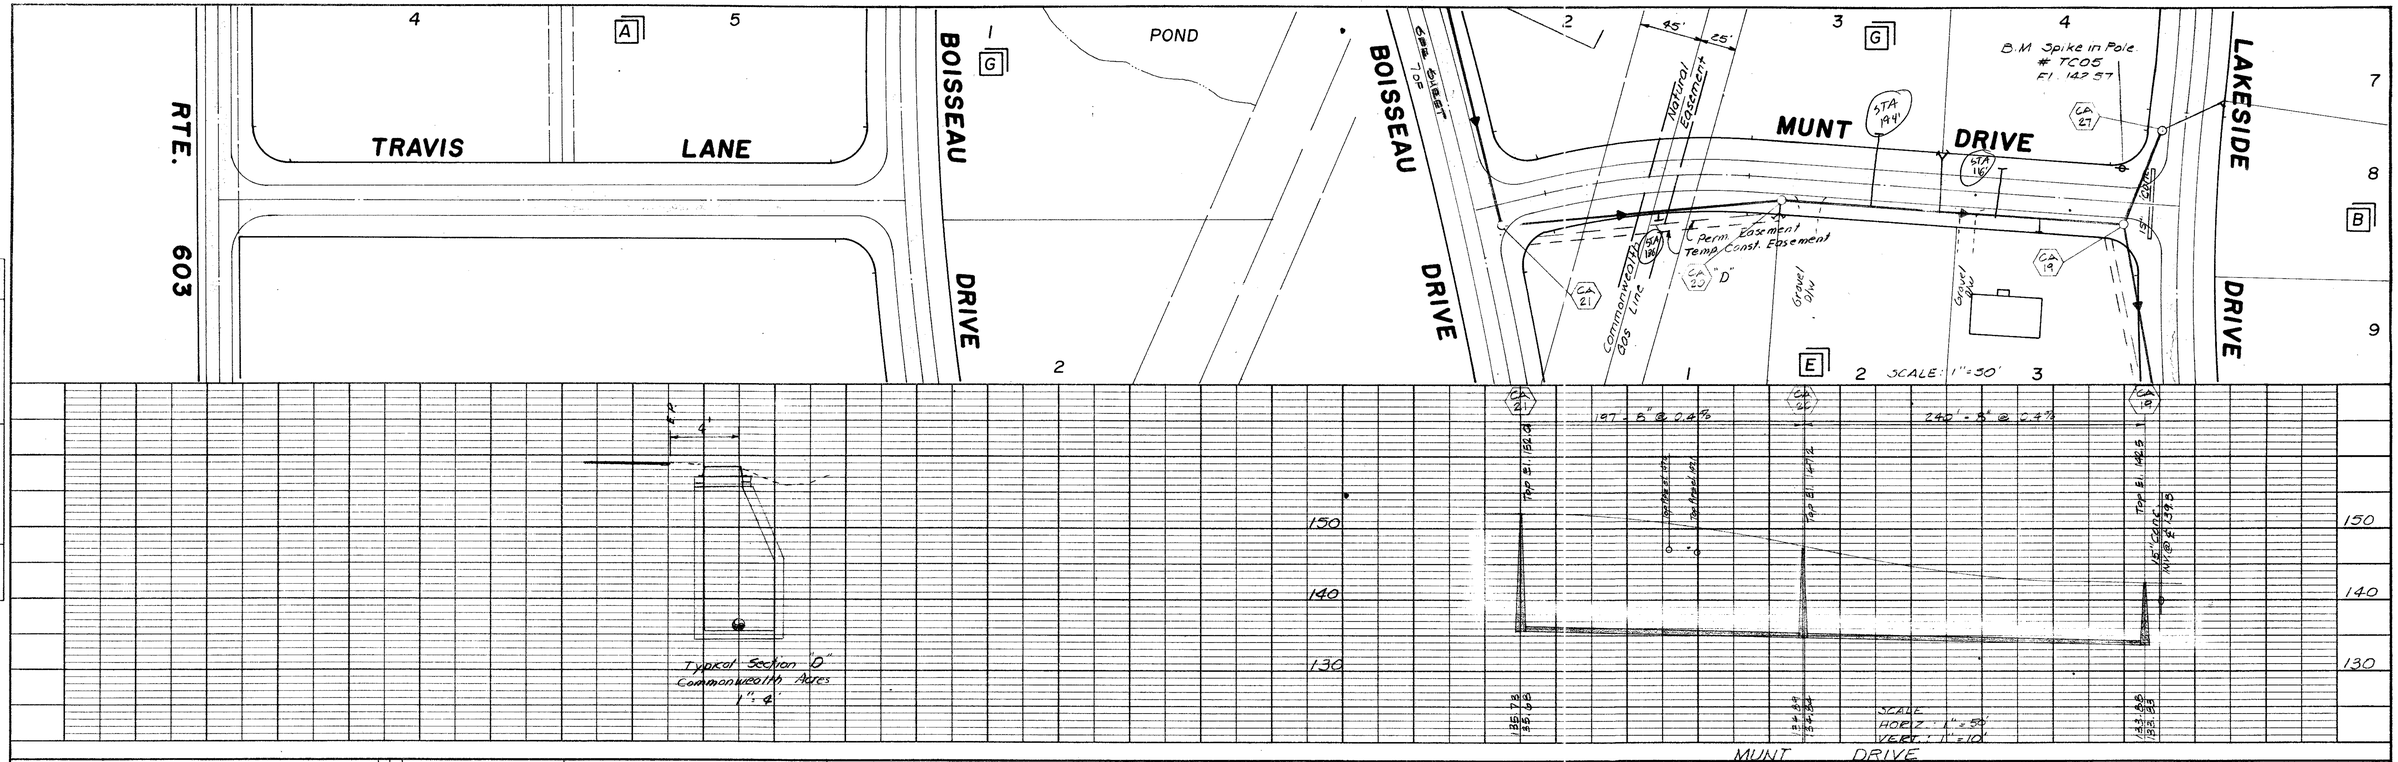

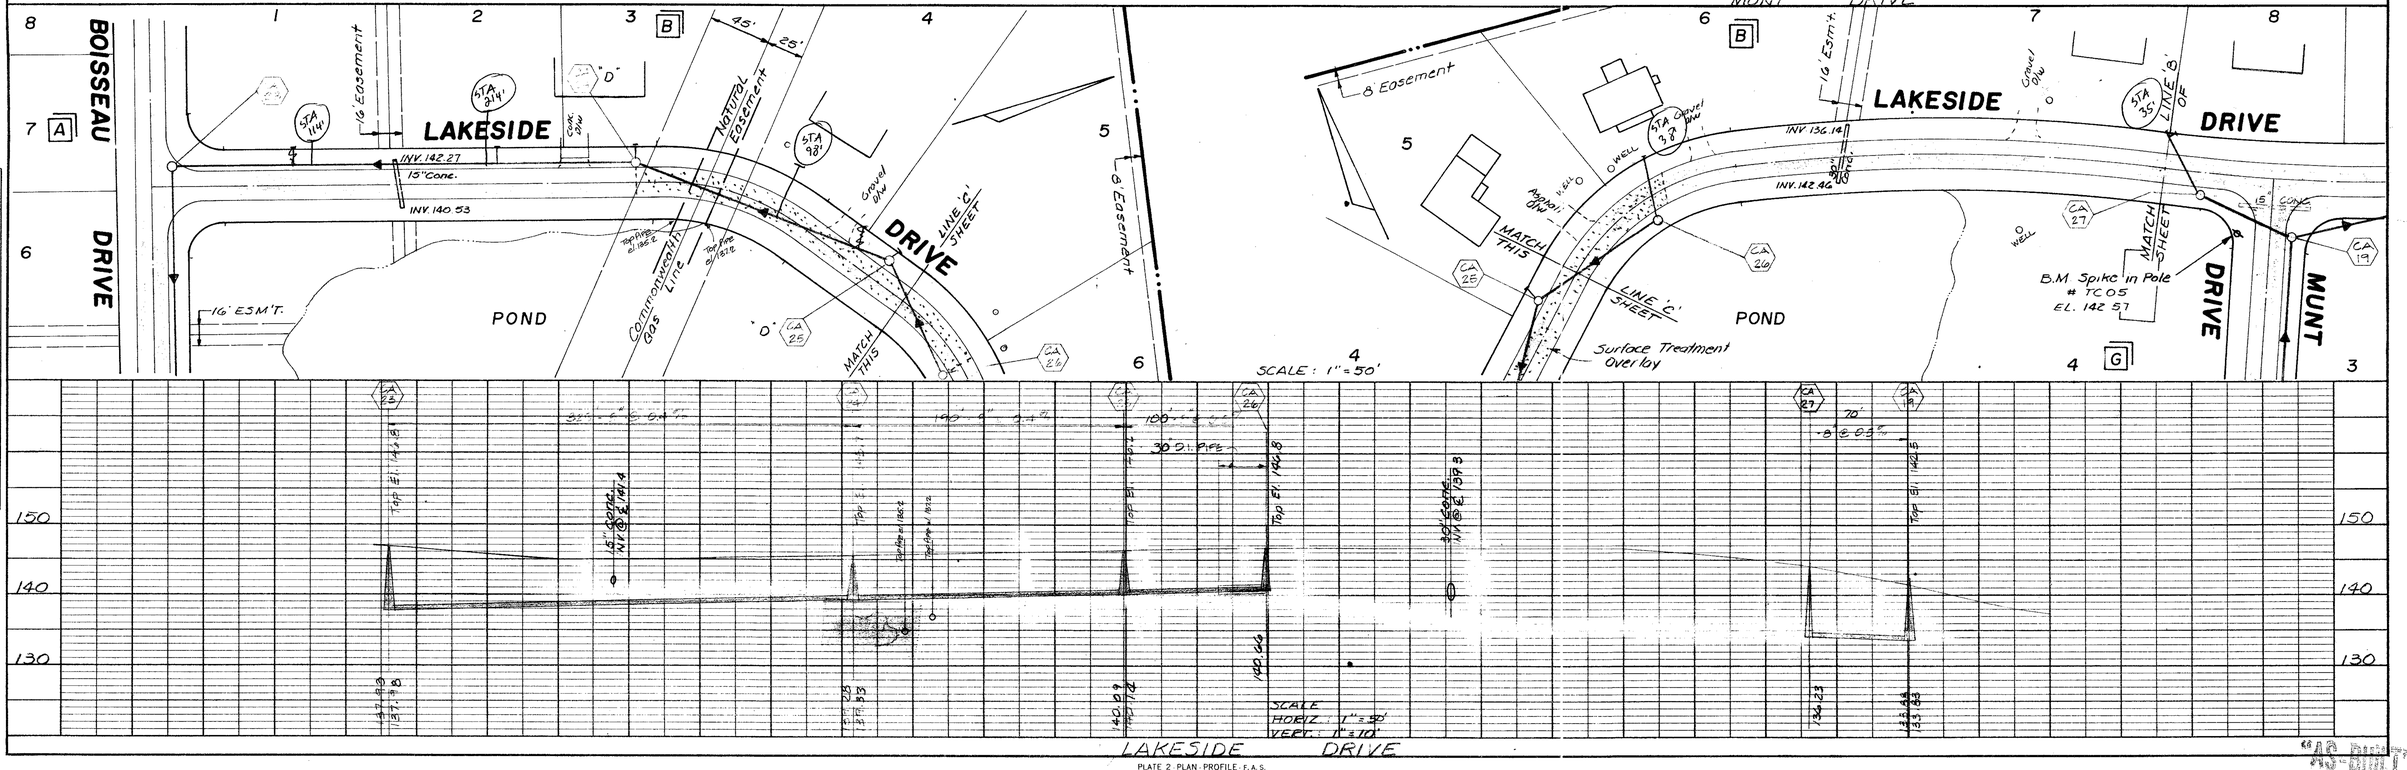

PLATE 2: PLAN - PROFILE - F.A.S.
CLEARPRINT PAPER CO., S.F. CAL.
No. 1000H-2

"AS-BUILT"
RBV 8-22-85 STATE CER.
REV 10-11 85

Commonwealth Acres

Sheet 6 of 13