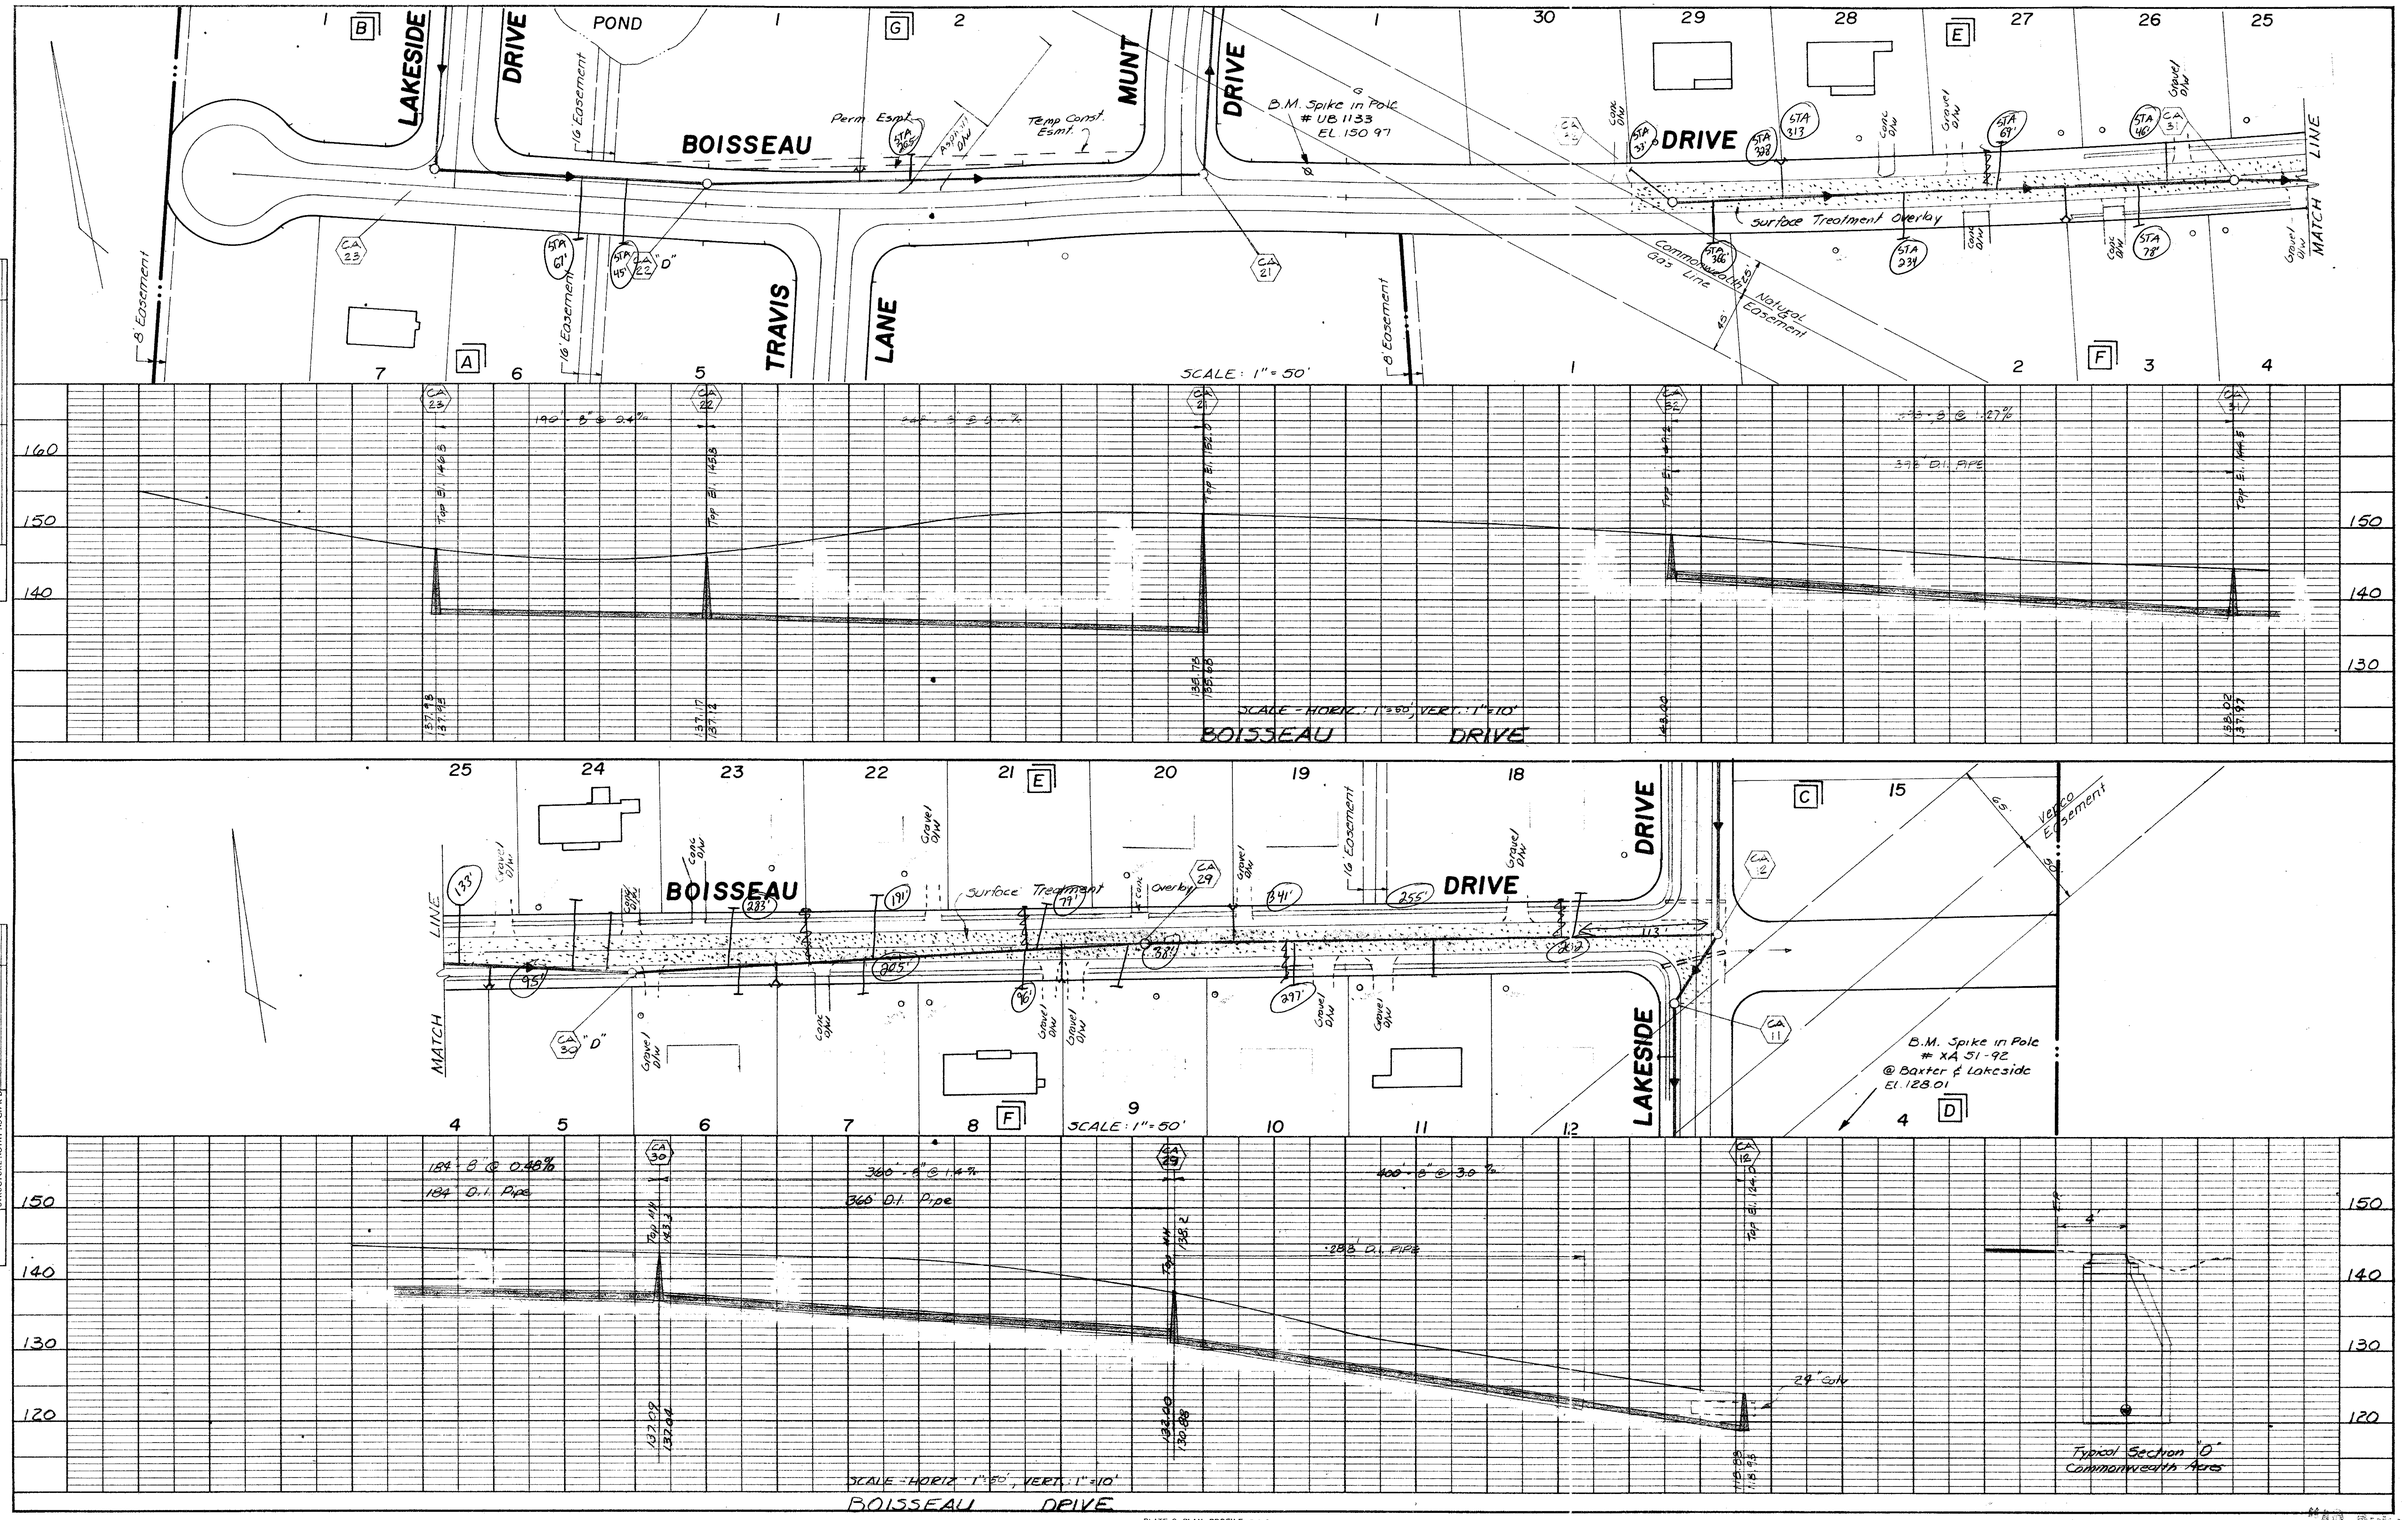

PLATE 2 - PLAN - PROFILE - F. A. S.
CLEARPRINT PAPER CO., S. F. CAL.
No. 1000H-2

Rev. 8-22-85
Rev. 10-11-85

"AS BUILT"

Commonwealth Acres

Sheet 7 of 13