△1 18" TO 21" TRUNK LINE

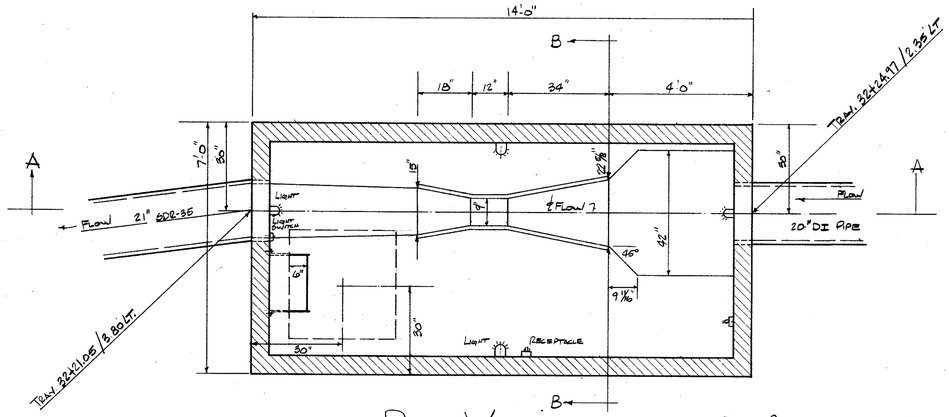

PLAN VIEW 1"=2'

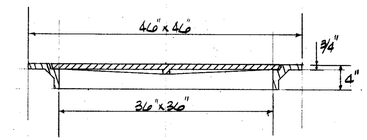

FRAME & COVER
(NEENAH R-6660-PH) 1"=1.0'

FLOW RECORDER TO BE SUPPLYED by
REGIONAL WASTEWATER TREATMENT PLANT
CITY OF HOPEWELL

PARSHALL FLUME by
FISCHER-PORTER
TYPE 10F1940-9"
WARMINSTER FIBERGLASS
REINFORCED-PLASTIC FLUME
WEIGHT 85lbs.

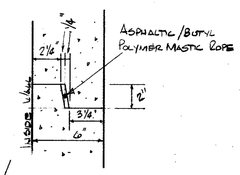

JOINT DETAIL
NTS

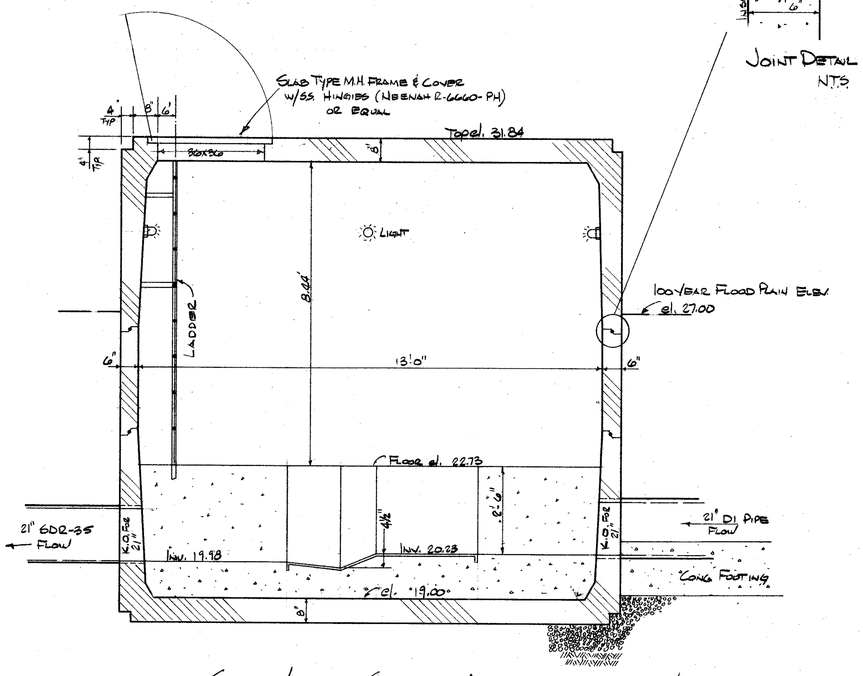

SIDE VIEW - SECTION A-A
1"=2'

VAULT by CLEAR FLOW
88-01-C11-1

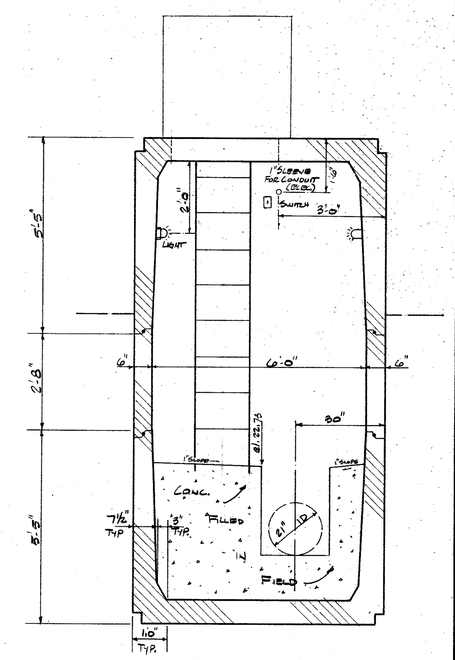

END VIEW - SECTION B-B
1"=2'

AS BUILT

J. K. TIMMONS & ASSOCIATES, INC.
ENGINEERS · SURVEYORS · PLANNERS
711 NORTH COURTHOUSE ROAD
RICHMOND, VIRGINIA 23235
TELEPHONE: (804) 794-3500
8803 STAPLES MILL ROAD
RICHMOND, VIRGINIA 23228
TELEPHONE: (804) 262-7396
411 EAST BROADWAY
HOPEWELL, VIRGINIA 23860
TELEPHONE: (804) 458-8685

△1 52486

REVISIONS

COMMONWEALTH OF VIRGINIA
WALTER M. ALTMAN III
LICENSE NO
11699
PROFESSIONAL ENGINEER

STAMP: As Noted
SCALE: JMA
DRAWN BY: March 4-85
DATE DRAWN: JMA
DESIGNED: WMA
CHECKED:
SHEET NUMBER: 8407-06
JOB NUMBER

T-9 Metering Vault Details

Sheet 10 of 11