SANITARY SEWER IMPROVEMENTS

MANCHESTER RUN TRUNK LINE

BLAND DISTRICT

PRINCE GEORGE CO., VIRGINIA

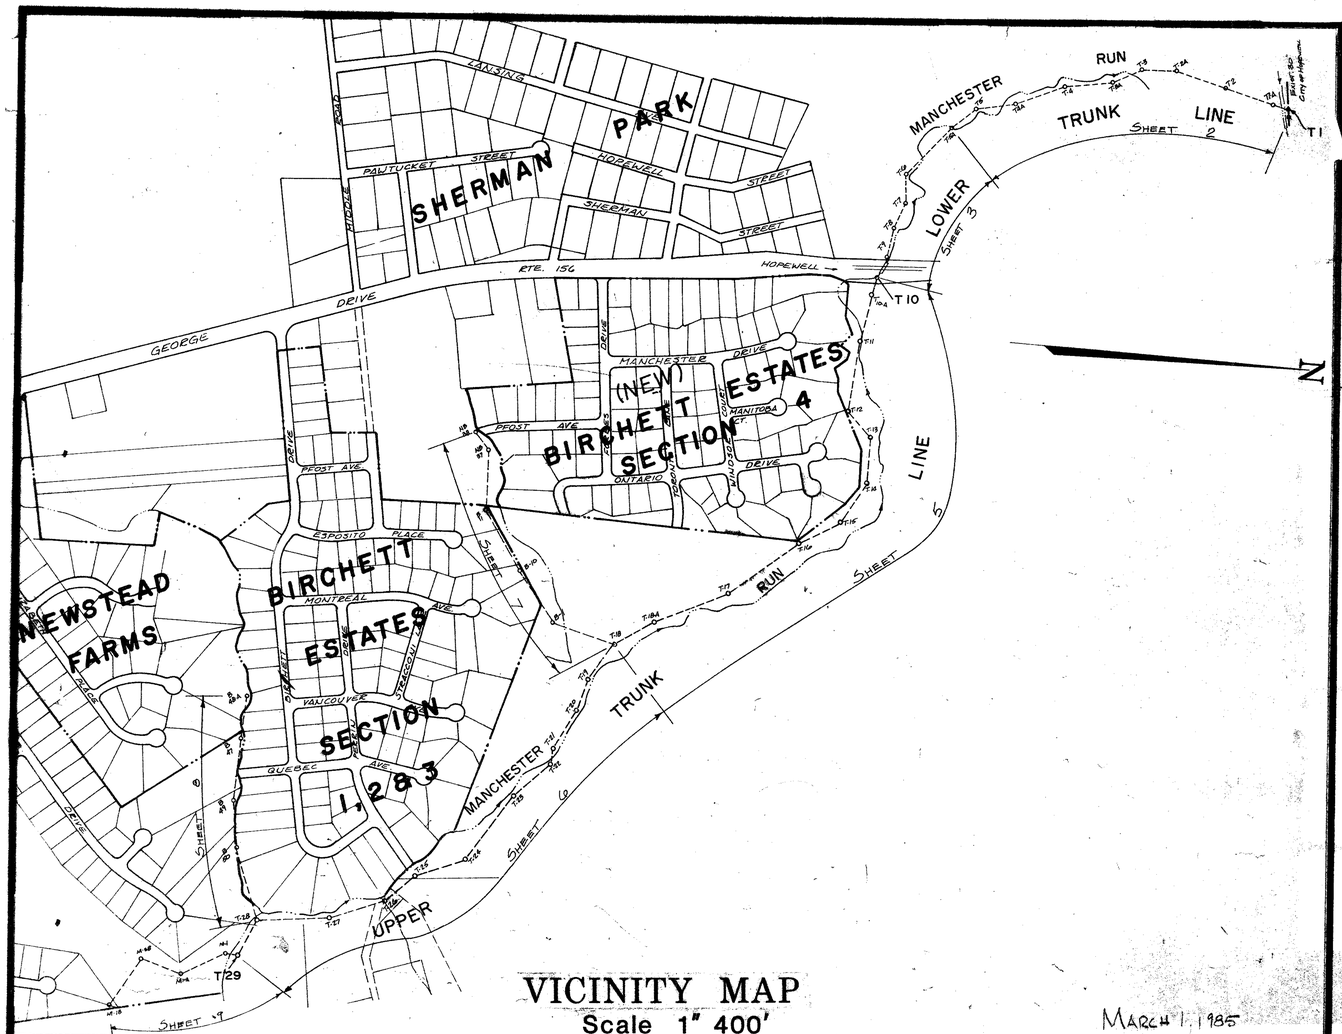

VICINITY MAP
Scale 1" 400'

MARCH 1, 1985

INDEX

SHEET NO.	DESCRIPTION
1	COVER SHEET
2	LOWER TRUNK LINE
3	" " " and DITCH RELOCATION
4	T-9 to T-10 DETAIL
5	UPPER TRUNK LINE
6	UPPER TRUNK LINE
7	New BIRCHETT-BIRCHETT Sub. Trunk 1
8	BIRCHETT-NEWSTEAD-FARMS Sub. Trunk 2
9	MANCHESTER MILL Sub. Trunk 3
10	T-9 METERING VAULT DETAILS
11	ACCESS ROAD PLAN

J. K. TIMMONS & ASSOCIATES INC.
ENGINEERS - SURVEYORS - PLANNERS
411 E. BROADWAY
HOPEWELL, VIRGINIA
458-8685

COMMONWEALTH OF VIRGINIA
WALTER M. ALTMAN III
LICENSE NO 11039
PROFESSIONAL ENGINEER

REVISIONS
△ 5-29-85 PER COUNTY REQ.
3-7-86 PER VDH&T REQ

AS BUILT