△ 18" TO 21" TRUNK LINE

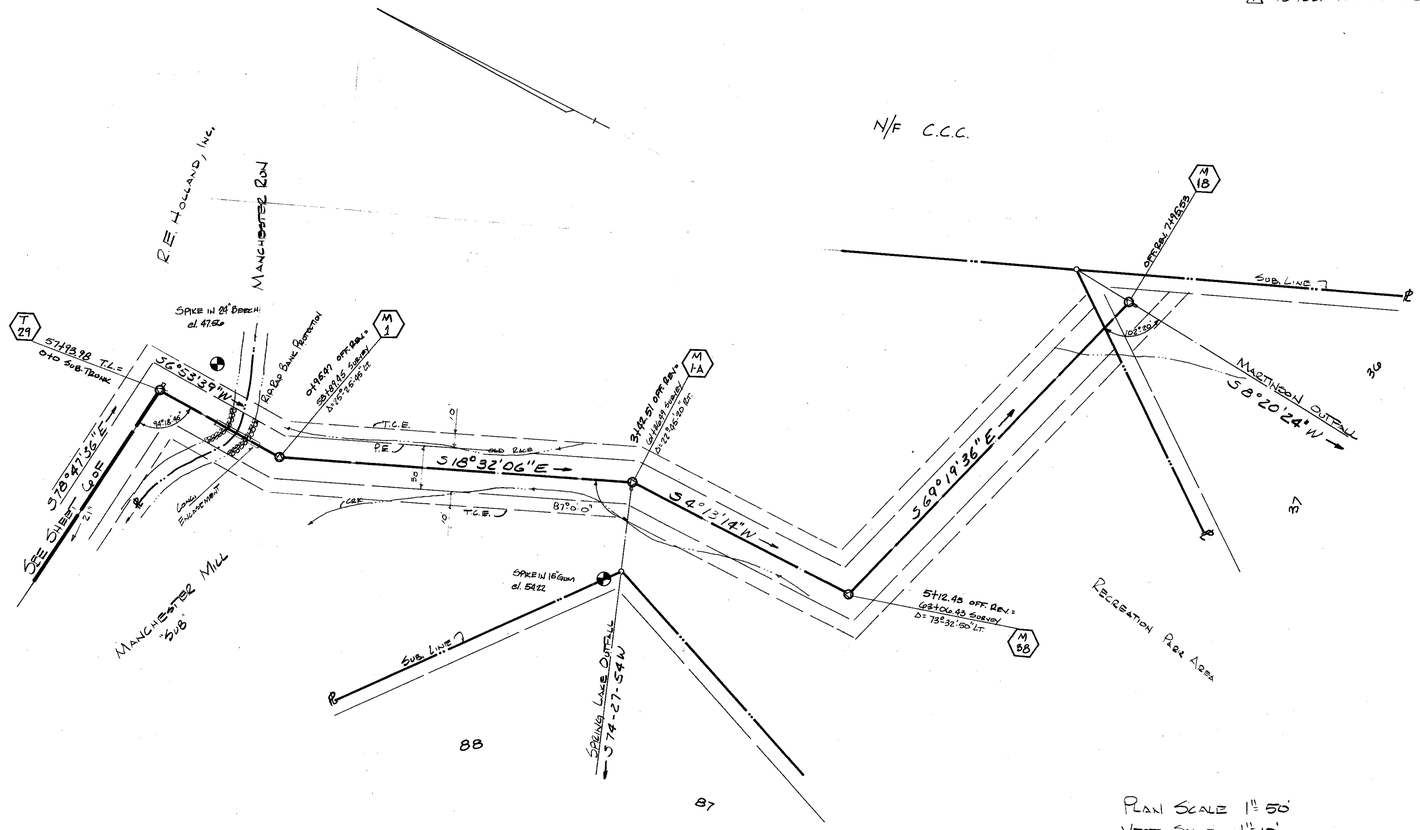

SUBDIVISION BEARINGS ARE IN PARENTHESIS
SEWER LINE BEARINGS ARE WITHOUT PARENTHESIS

PLAN SCALE 1" = 50'
VERT. SCALE 1" = 10'

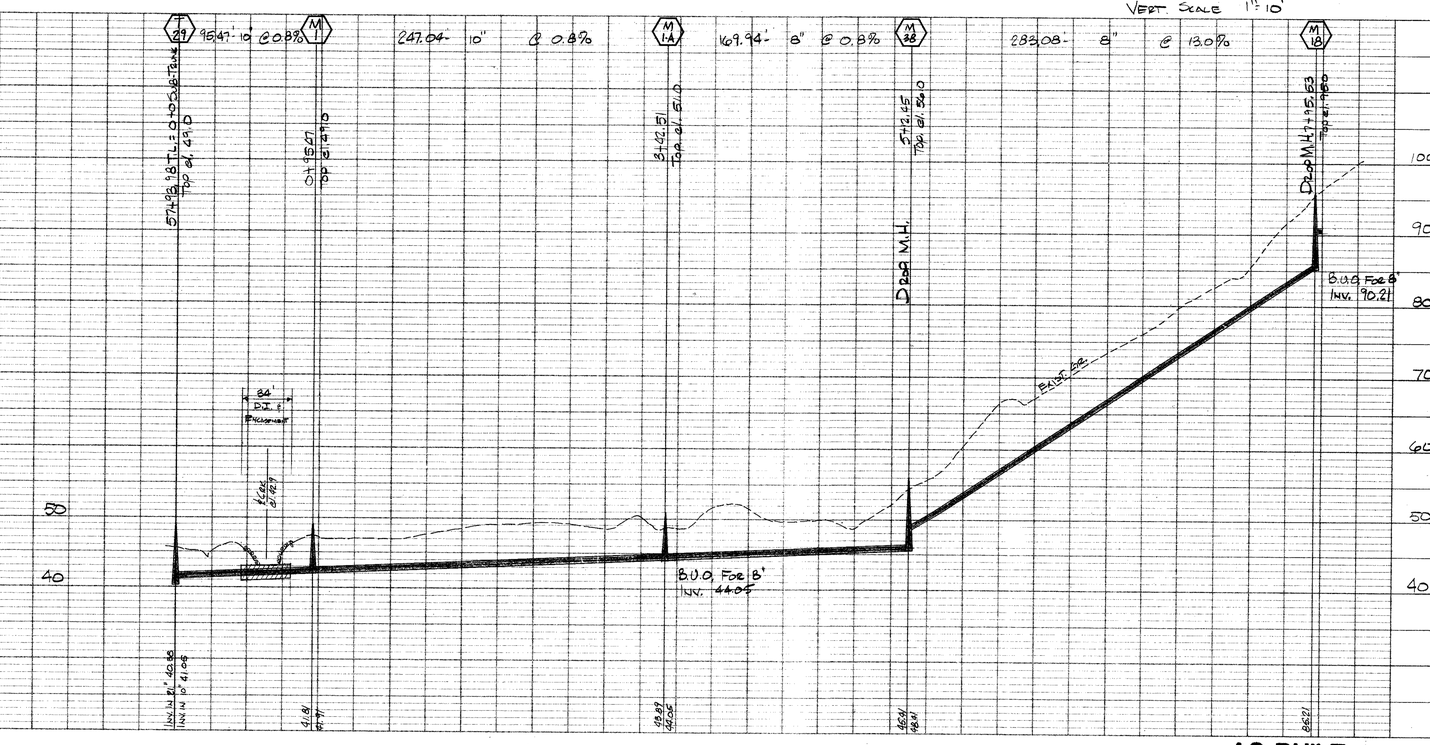

AS BUILT

J. K. TIMMONS & ASSOCIATES, INC.
ENGINEERS · SURVEYORS · PLANNERS

711 NORTH COURTHOUSE ROAD
RICHMOND, VIRGINIA 23235
TELEPHONE: (804) 794-3500

8803 STAPLES MILL ROAD
RICHMOND, VIRGINIA 23228
TELEPHONE: (804) 262-7398

411 EAST BROADWAY
HOPEWELL, VIRGINIA 23860
TELEPHONE: (804) 458-8885

△ 5-24-85

REVISIONS

COMMONWEALTH OF VIRGINIA
WALTER M. ALTMAN III
LICENSE NO
11039
PROFESSIONAL ENGINEER

STAMP: As Noted
SCALE: JMA
DRAWN BY: Feb 28-85
DATE DRAWN: JMA
DESIGNED: WMA
CHECKED: 9 of
SHEET NUMBER: 8407-06
JOB NUMBER

Manchester Mill Sub Trunk # 3

Sheet 9 of 11

N64920