SANITARY SEWER IMPROVEMENTS

NEW BIRCHETT ESTATES

BLAND DISTRICT

PRINCE GEORGE CO., VIRGINIA

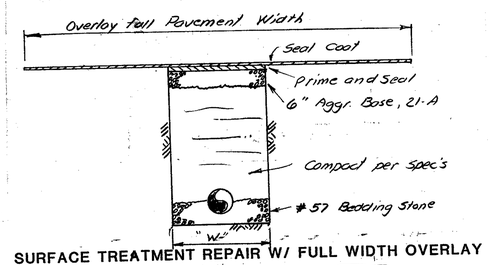

SURFACE TREATMENT REPAIR W/ FULL WIDTH OVERLAY

Where Required shown by

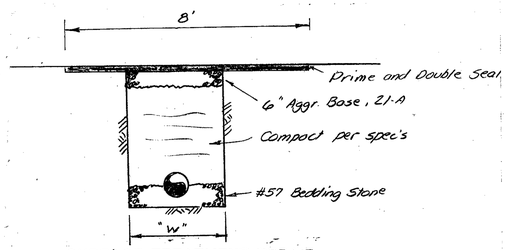

SURFACE TREATMENT REPAIR

Note: All Streets are Surface Treatment

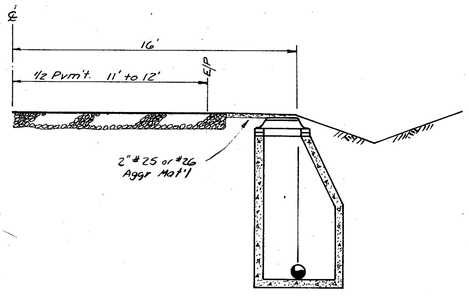

TYPICAL MANHOLE LOCATION

Note: Location Unless Shown Otherwise

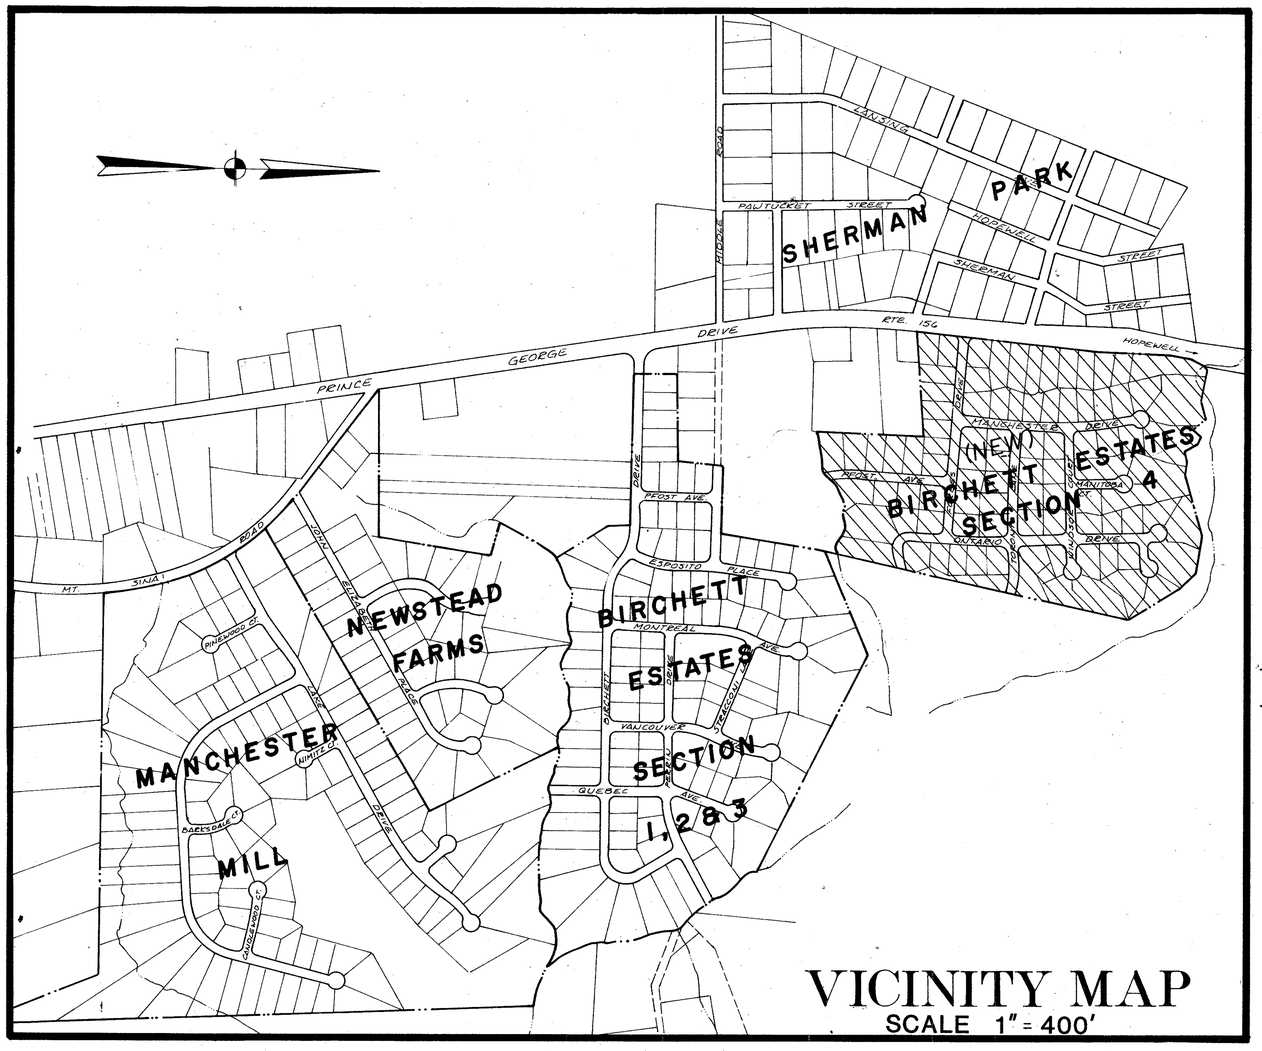

VICINITY MAP

SCALE 1" = 400'

INDEX

SHEET NO.	DESCRIPTION
1	COVER SHEET
2	OVERALL PROJECT
3	RTE. 156 OUTFALL
4	MANCHESTER DR. OUTFALL
5	MANITOBA OUTFALL
6	~~ONTARIO OUTFALL (NORTH)~~ OMIT
7	WINDSOR OUTFALL
8	TORONTO & ONTARIO (SOUTH) OUTFALL
9	COLLECTOR SYSTEM
10	COLLECTOR SYSTEM

J. K. TIMMONS & ASSOCIATES INC.

ENGINEERS - SURVEYORS - PLANNERS

411 E. BROADWAY

HOPEWELL, VIRGINIA

458 - 8685

COMMONWEALTH OF VIRGINIA
WALTER M. ALTMAN III
LICENSE NO 11039
PROFESSIONAL ENGINEER

REVISIONS

DATE	
△ 5-31-85	PER COUNTY REQ.
2 3-7-86	PER VDH&T REQ.

AS BUILT

Cover Sheet