* THIS LATERAL MUST EXTEND TO THE STAKE LOCATED APPROX AS SHOWN.

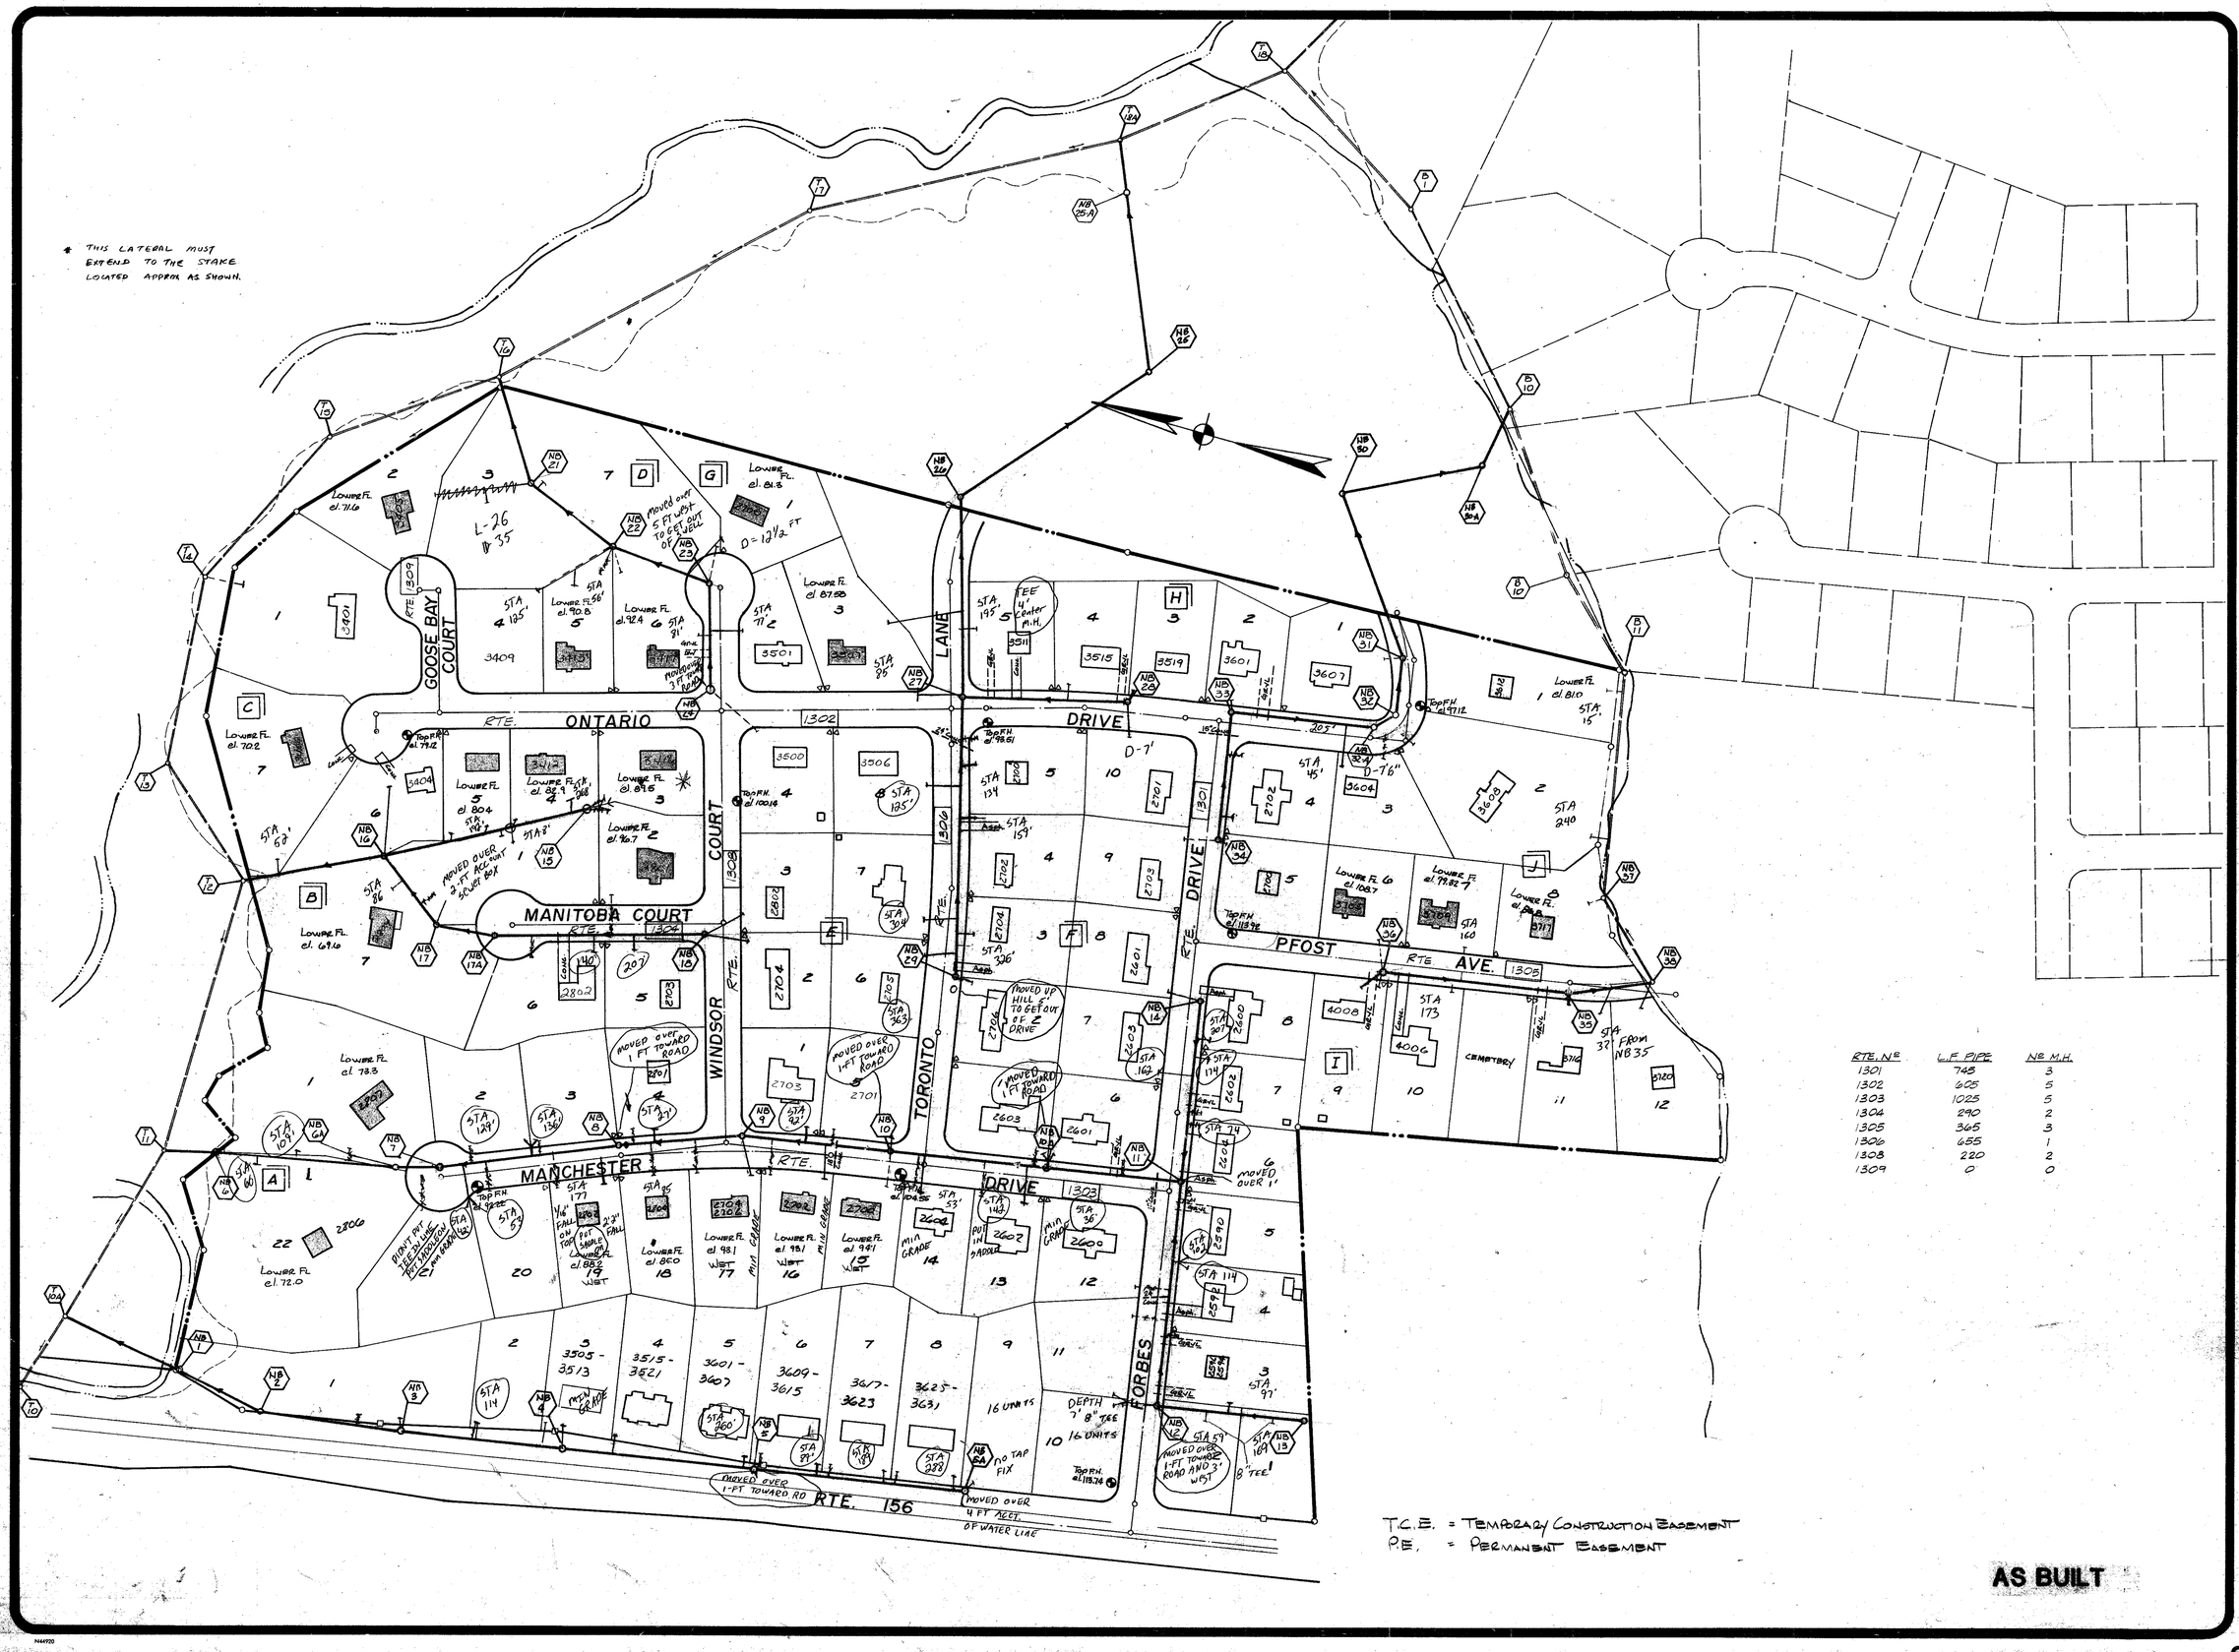

RTE. Nº	L.F. PIPE	Nº M.H.
1301	748	3
1302	605	5
1303	1025	5
1304	290	2
1305	365	3
1306	655	1
1308	220	2
1309	0	0

T.C.E. = TEMPORARY CONSTRUCTION EASEMENT
P.E. = PERMANENT EASEMENT

AS BUILT

J. K. TIMMONS & ASSOCIATES, INC.
ENGINEERS · SURVEYORS · PLANNERS

711 NORTH COURTHOUSE ROAD
RICHMOND, VIRGINIA 23235
TELEPHONE: (804) 794-3500

8803 STAPLES MILL ROAD
RICHMOND, VIRGINIA 23228
TELEPHONE: (804) 262-7386.

411 EAST BROADWAY
HOPEWELL, VIRGINIA 23860
TELEPHONE: (804) 458-8685

11/26/85
7/18/86

REVISIONS

COMMONWEALTH OF VIRGINIA
WALTER M. ALTMAN III
LICENSE NO 11026
PROFESSIONAL ENGINEER

STAMP

1" = 100'

SCALE

DRAWN BY

DATE DRAWN

DESIGNED

CHECKED

SHEET NUMBER
8407-06
JOB NUMBER

Overall Project

Sheet 2 of 10