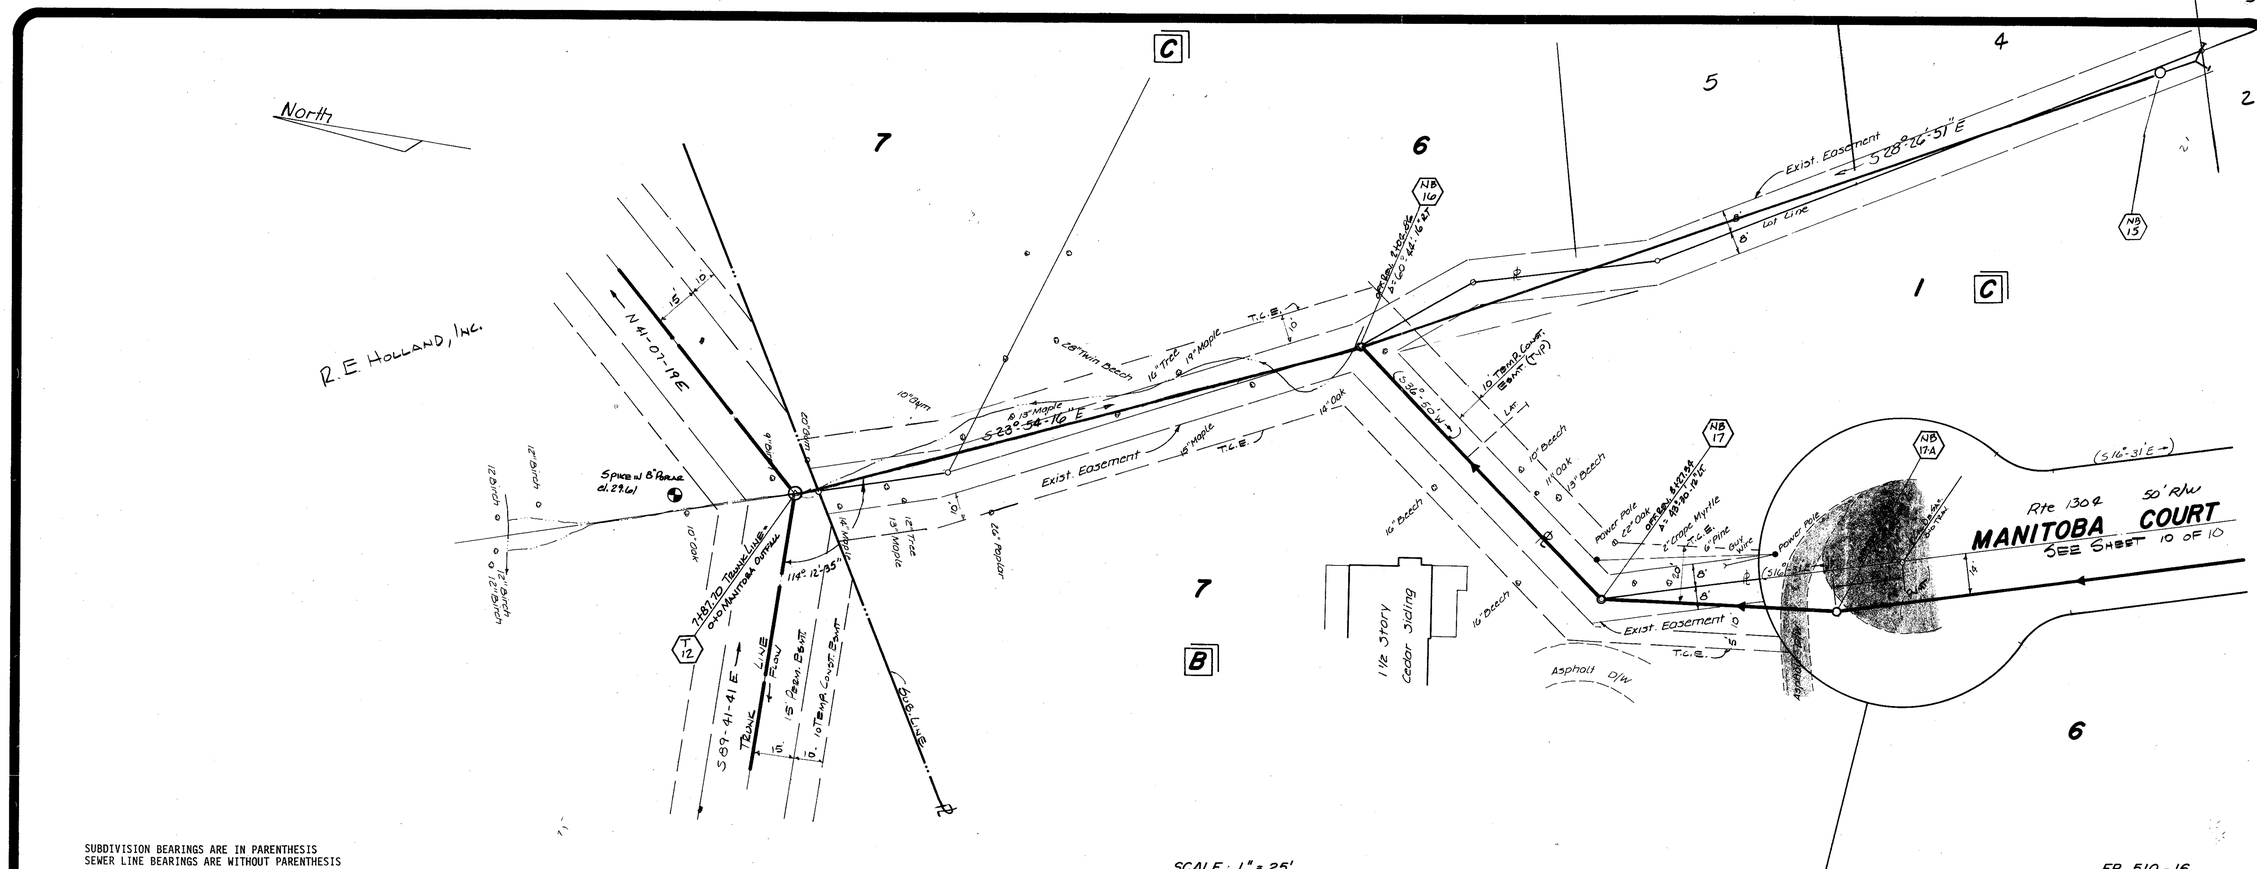

SUBDIVISION BEARINGS ARE IN PARENTHESIS
SEWER LINE BEARINGS ARE WITHOUT PARENTHESIS

SCALE: 1" = 25'

FB. 510-16

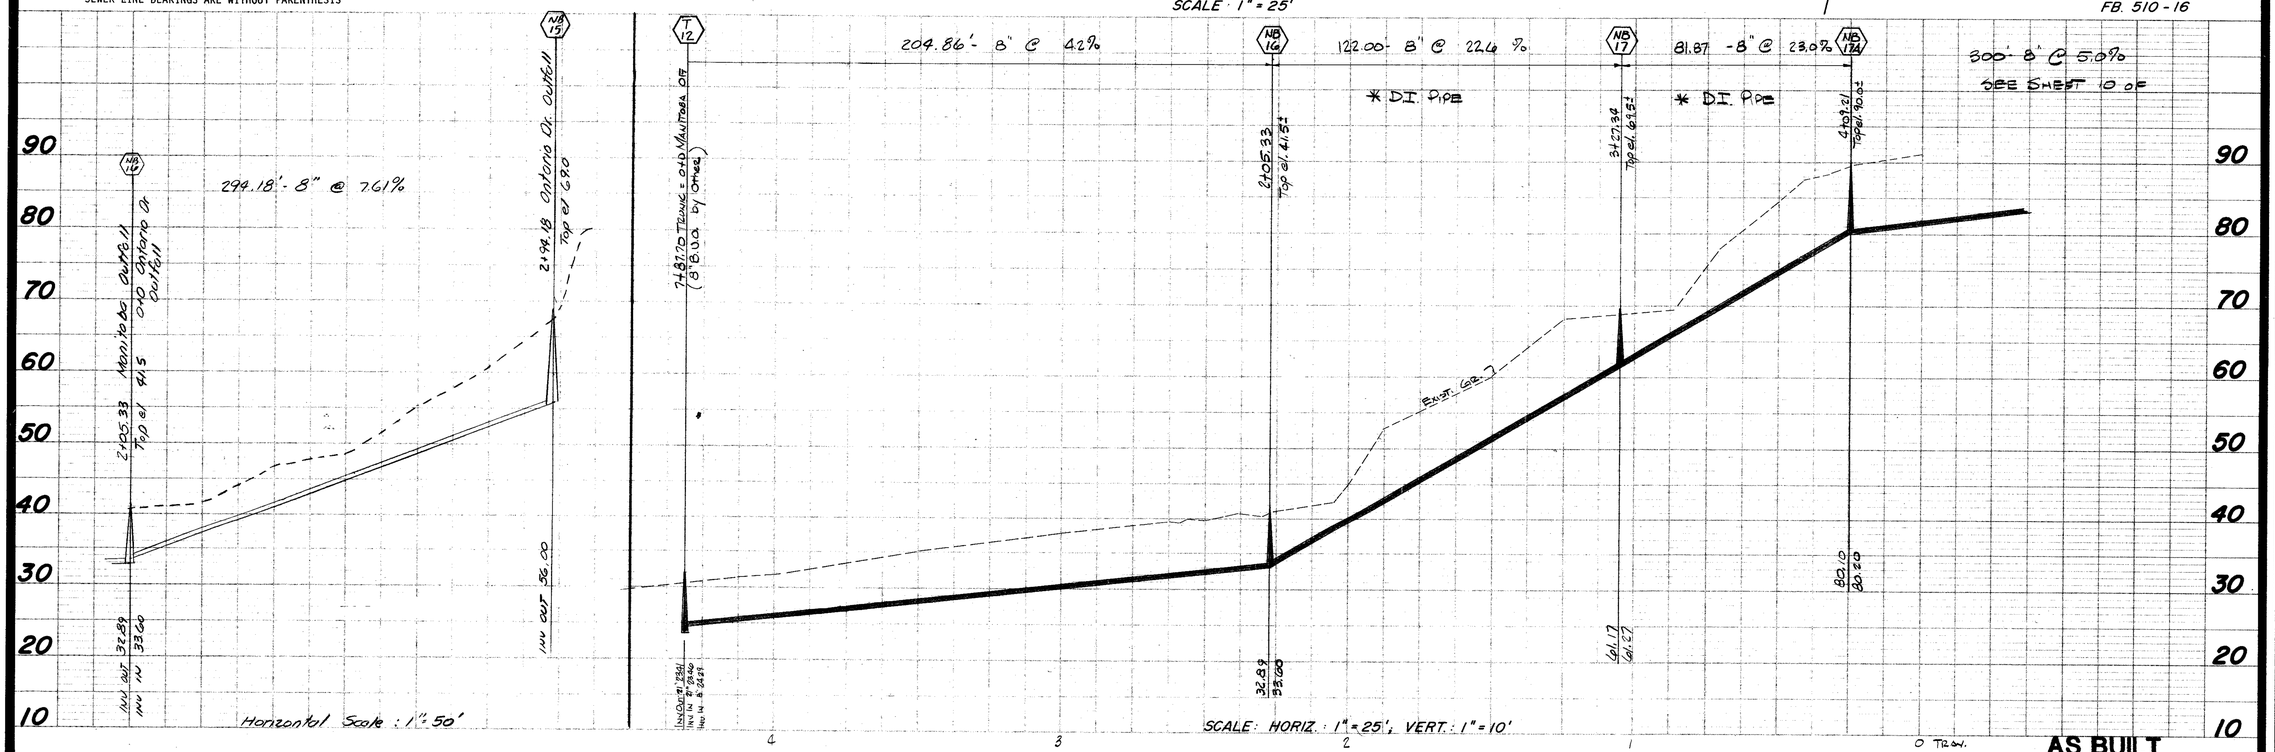

AS BUILT

J. K. TIMMONS & ASSOCIATES, INC.
ENGINEERS · SURVEYORS · PLANNERS
711 NORTH COURTHOUSE RD. (804) 794-3500 RICHMOND, VIRGINIA 23235
8803 STAPLES MILL RD. (804) 262-7396 RICHMOND, VIRGINIA 23228

MANITOBA OUTFALL

7/18/86

REVISIONS

COMMONWEALTH OF VIRGINIA
WALTER M. ALTMAN III
LICENSE NO 11039
PROFESSIONAL ENGINEER

STAMP: AS NOTED
SCALE: G.F.C.
DRAWN BY:
DATE DRAWN: J.M.A.
DESIGNED: W.M.A. III
CHECKED:
SHEET NUMBER: 8407-06
JOB NUMBER

Manitoba Outfall

Sheet 5 of 10