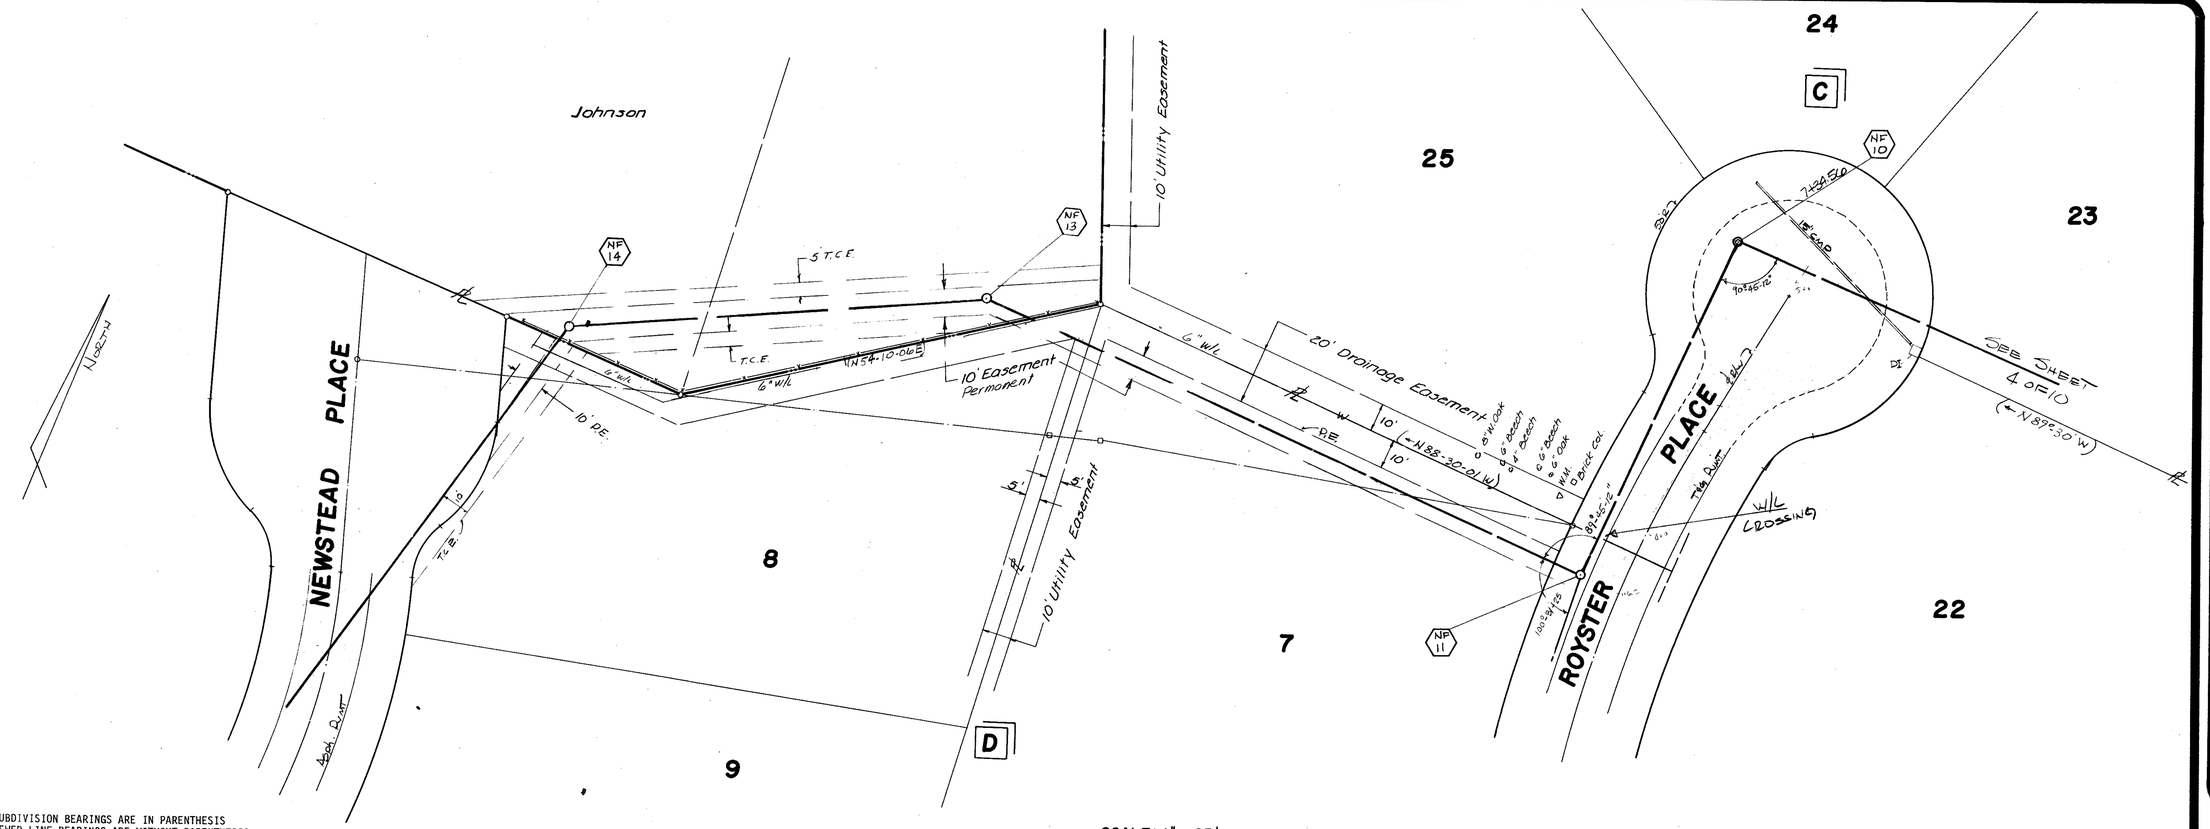

SUBDIVISION BEARINGS ARE IN PARENTHESIS
SEWER LINE BEARINGS ARE WITHOUT PARENTHESIS

SCALE: 1" = 25'

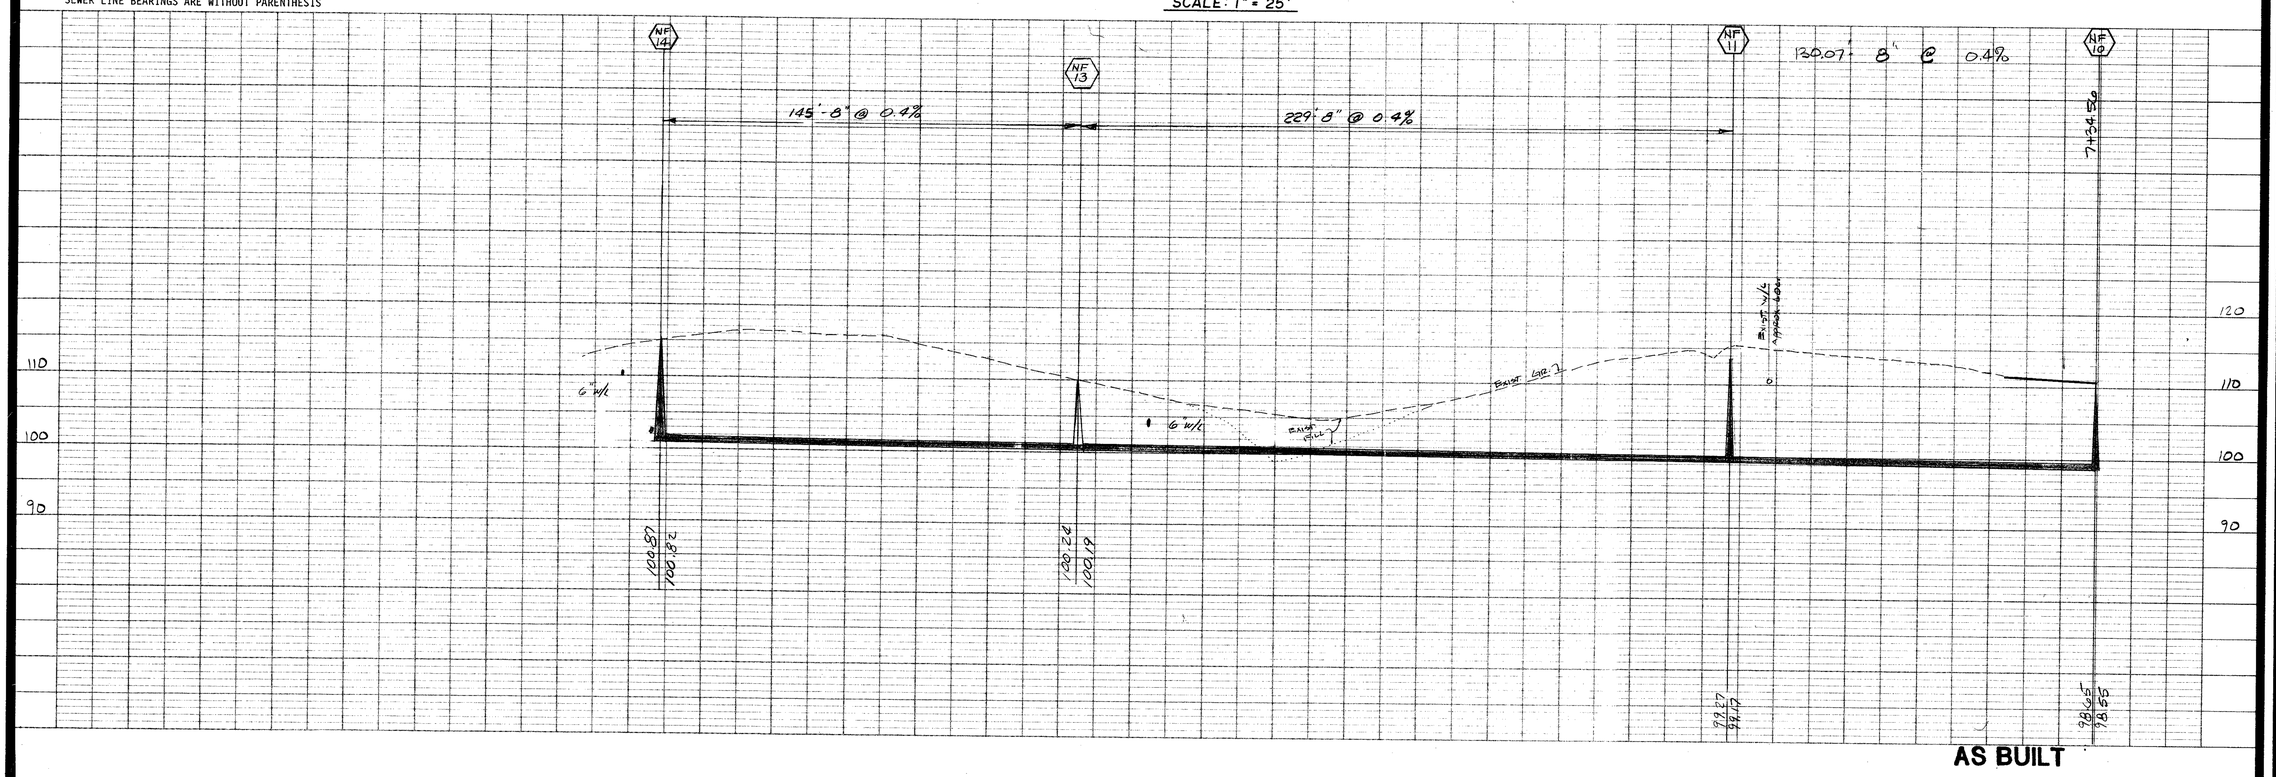

AS BUILT

J. K. TIMMONS & ASSOCIATES, INC.
ENGINEERS · SURVEYORS · PLANNERS

711 NORTH COURTHOUSE ROAD
RICHMOND, VIRGINIA 23235
TELEPHONE: (804) 794-3560

8803 STAPLES MILL ROAD
RICHMOND, VIRGINIA 23228
TELEPHONE: (804) 262-7396

411 EAST BROADWAY
HOPEWELL, VIRGINIA 23860
TELEPHONE: (804) 458-8585

12/2/85

REVISIONS

COMMONWEALTH OF VIRGINIA
WALTER M. ALTMAN III
LICENSE NO
11039
PROFESSIONAL ENGINEER

STAMP
AS NOTED

SCALE
J. M. A.

DRAWN BY

DATE DRAWN
J. M. A.

DESIGNED
W. M. A. III

CHECKED

SHEET NUMBER
8407-06

JOB NUMBER

Newstead Place Outfall

Sheet 5 of 10