COUNTY OF

PRINCE GEORGE VIRGINIA

PUDDLEDOCK AREA SEWER EXTENSION

PROJECT Nº : E06086-853-D

GENERAL VICINITY MAP

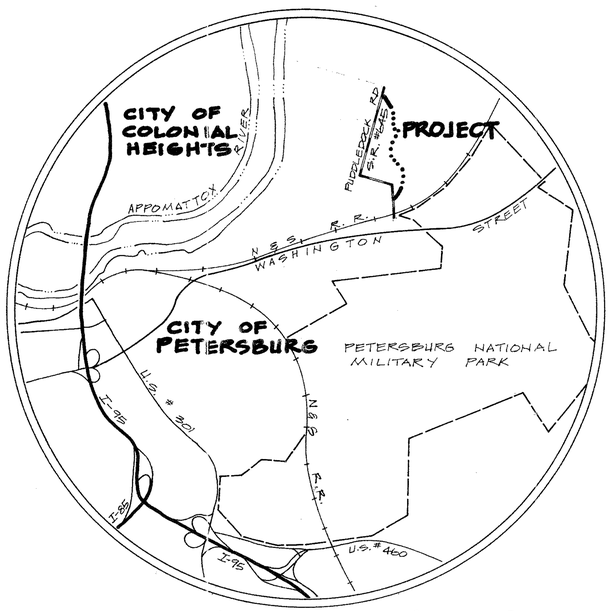

PROJECT VICINITY MAP

Construction completed 6/87 SEM

"AS-BUILT"

CERTIFICATION

NO.	DATE	REVISIONS

COVER SHEET

PUDDLEDOCK AREA SEWER SYS.
PRINCE GEORGE COUNTY

B & B Consultants, Inc.
CONSULTING ENGINEERS-SURVEYORS-LABORATORY ANALYSTS
CHASE CITY & SOUTH HILL, VIRGINIA

COMMISSION NO.
DESIGNED BY
DRAWN BY BOAZ
CHECKED BY
ISSUE DATE AUG. 13, 1986

SHEET NO.

OF SHEETS

SOUTHERN PHOTO - GREENSBORO H3733