Water only

INDEX

SHEET	DESCRIPTION
A	COVER SHEET
B	GENERAL NOTES & ESTIMATED QUANTITIES
C	TYPICAL SECTIONS
D	TYPICAL DETAILS
E	METER VAULT
1	RTE. 645
1A	DITCH CROSSING
2	RTE. 645 & CONN. RTE. 685
3	RTE. 645 & CONN. RTE. 684; RTE. 685
4	RTE. 684 & CONNECTIONS
5	DIRT ROAD

PLAN OF PROPOSED WATER SYSTEM PUDDLEDOCK ROAD PRINCE GEORGE COUNTY

FROM: N. C. L. PETERSBURG
TO: INT. RTE. 684

LOCATION MAP

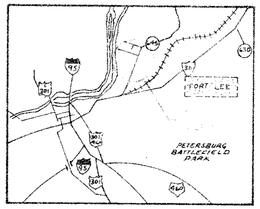

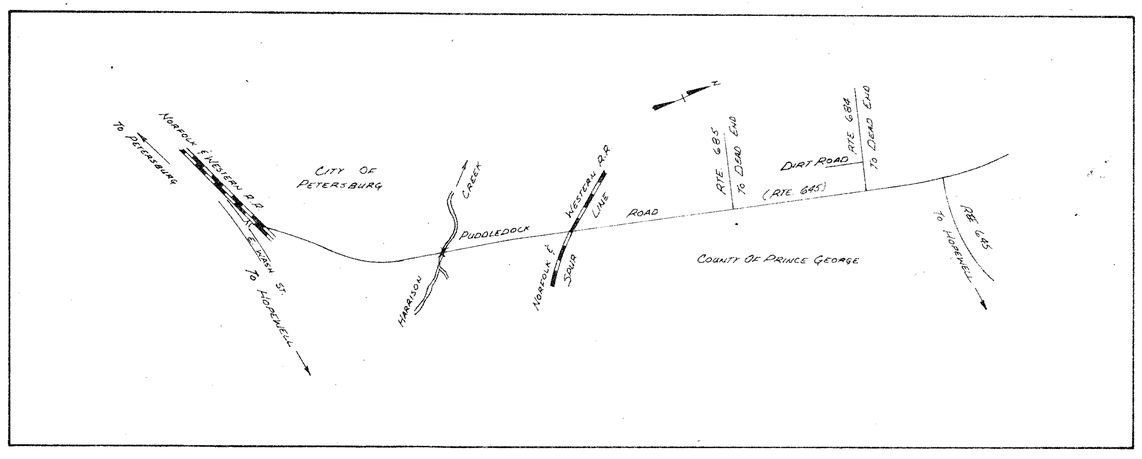

RECORD COPY

16 JUN 1975

DIVISION OF ENGINEERING
DEPARTMENT OF PUBLIC WORKS
PETERSBURG, VIRGINIA

COVER SHEET

WATER SYSTEM
PUDDLEDOCK ROAD

SCALE NO SCALE	NOTE BOOK	DRAWING NO.
DATE 3-26-75	PAGE	F-3-74
DRAWN BY D.C.M.	BY	

SHEET A