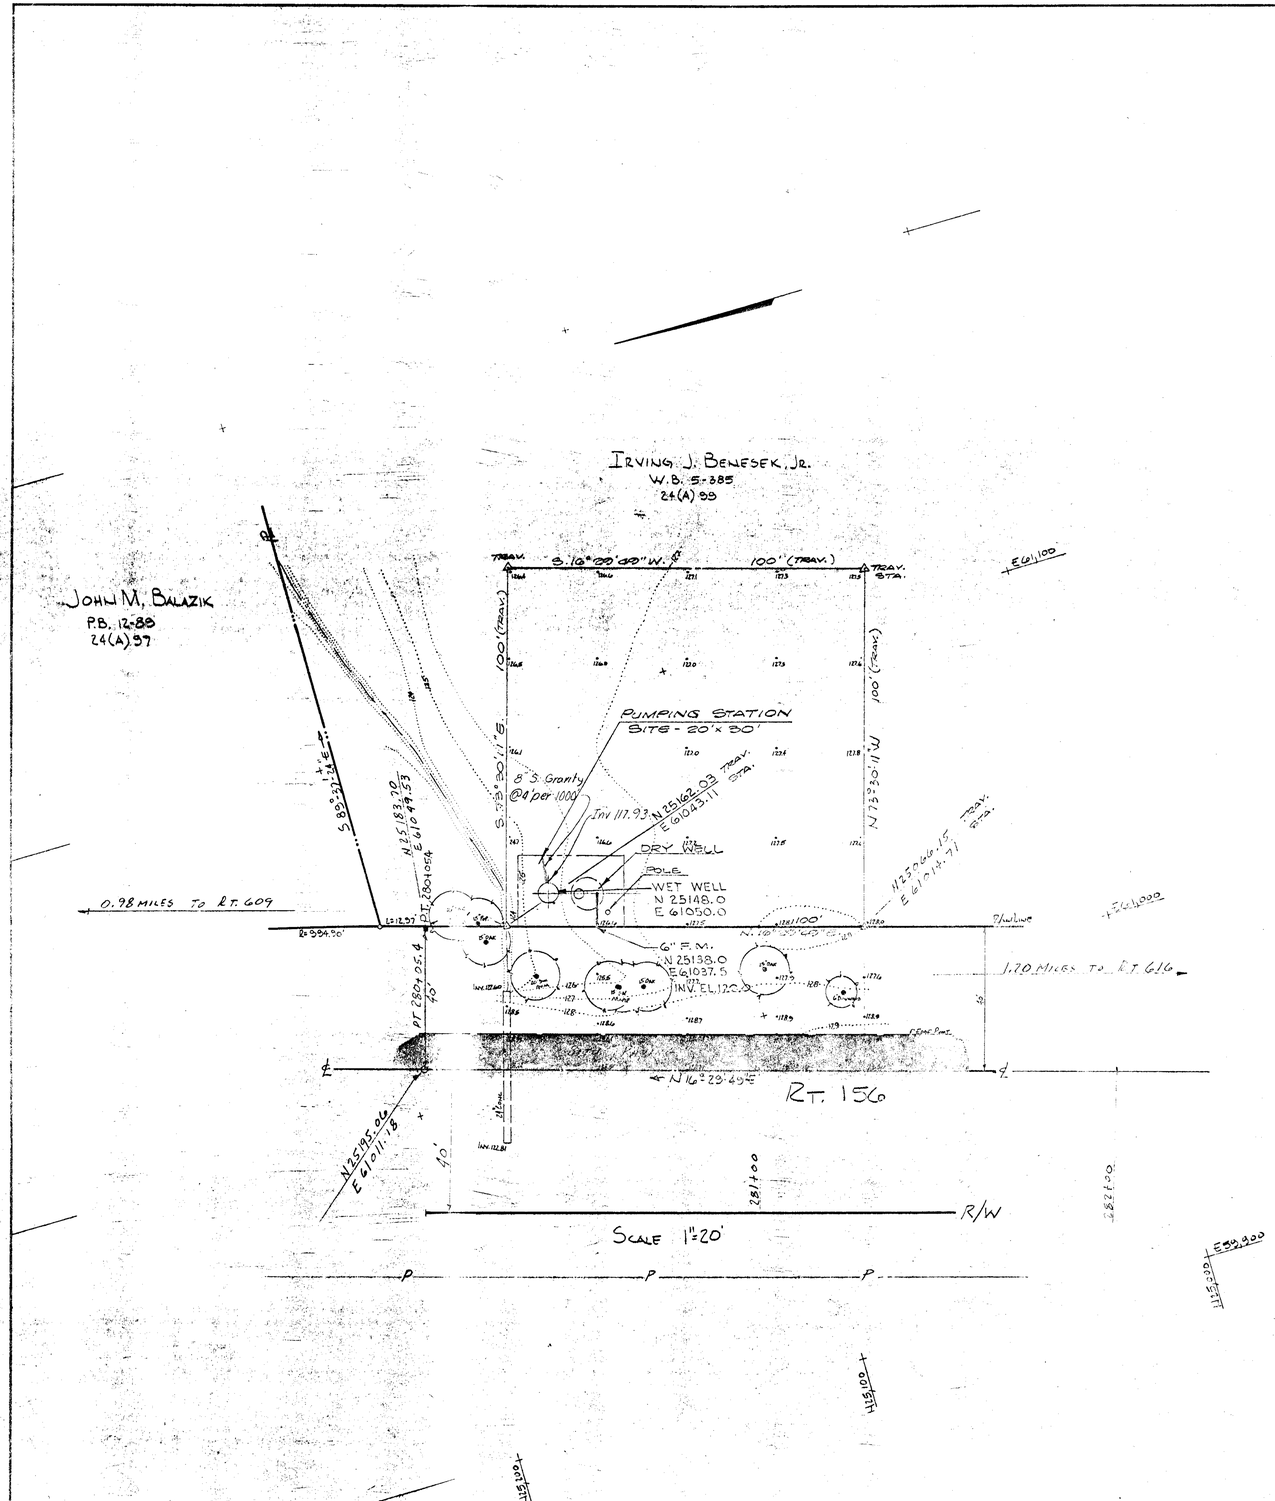


AS BUILT

| NO. | DATE | APPR. | REVISION | NO. | DATE | APPR. | REVISION |
|---|---|---|---|---|---|---|---|
| 1 | 2-23-77 | | Revised Location Of 8" Gravity Sewer | | | | |

JOHN L. COMBS
CERTIFICATE No. 6000
COMMONWEALTH OF VIRGINIA
REGISTERED PROFESSIONAL ENGINEER

| | | DATE |
|---|---|---|
| CHECKED | | |
| DESIGNED | | |
| PROJ. ENG. | | |
| PROJ. MGR. | | |
| APPROVED | | |
| APPROVED | | |

PUMPING STATION NO. 4
PLOT PLAN
SANITARY SEWER SYSTEM
PRINCE GEORGE COUNTY VIRGINIA

ROY F. WESTON
ENVIRONMENTAL SCIENTISTS AND ENGINEERS
LEWIS LANE • WEST CHESTER • PENNSYLVANIA • 19380

PREPARED BY WEST CHESTER OFFICE

| DRAWN | DATE | SCALE | W. O. NO. | DWG. NO. |
|---|---|---|---|---|
| K. LANYON | 8-17-76 | AS NOTED | 1535-01 | 7 OF 8 |

SHEET NO.