
ROSMSON

(More of QWilliams 2.13.03 *UTILITIES ARE APPROVED SUBJECT TO

WATER AND WASTEWATER CONTRACTS BEING APPROVED BY BOARD OF SUPERVISORS.

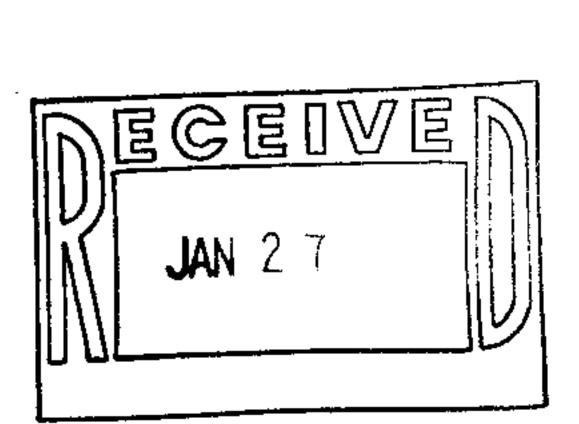

Ravenswood Industrial Park Phase One

Ravenswood Drive Prince George County, Virginia

Subdivision and Site Construction Plan General Notes:

- All materials and construction within the public right of way shall be in accordance with current Virginiia. Department of Transportation's specifications and standards.
- 2. Land Use Permits (CE-7P) must be obtained from the Virginia Department of Transportation prior to beginning any construction within the existing state maintained right of way (including access).
- 3. VDOT is to receive written notification 48 hours prior to commencing with initial construction activities.
- 4. Prior to any construction, the contractor shall consult the engineer and verify the approval of the plans by all applicable federal, state and local agencies.
- Preliminary design of the pavement structure for all subdivision streets shall be in accordance with the current edition of The Pavement Design Guide for Subdivision and Secondary Roads in Virginia. The completed design worksheet appendix IV shall be included with the initial plan submittal for each proposed pavement section. utilizing the predicted soil support value shown in appendix I of The Pavement Design Guide.
- . The contractor shall verify the elevations of all points of connection or proposed work to existing curbs, sanitary lines, water lines, etc., prior to construction.
- Upon discovery of soils that are unsuitable for foundations, subgrades, or other roadway construction purposes. the contractor shall immediately contact a geotechnical engineer and VDOT. These areas shall be excavated below plan grade as directed by the geotechnical engineer, backfilled with suitable material and compacted in accordance with current VDOT specifications.
- 8. All storm sewer design and construction to be in accordance with VDOT I & I LD-94 (D) 121.13.
- 9. All storm sewer pipe shall be reinforced tongue and groove concrete pipe in accordance with ASTM-C-76. Pipe within the right of way shall be a minimum CL-III or greater in accordance with current VDOT standards and
- 10. All pre-cast units shall be VDOT approved. Certification and VDOT stamp will be required on all units.
- All concrete shall be class A3-AE (air entrained 3,000 PSI).
- 12. All entrances are to be designed and constructed in accordance with current VDOT standards. Residential lot access shall be provided per the following criteria:
- * All driveway entrance culverts are to be 15" diameter x 20' long pipe and shall conform to PE-1 private entrance standards unless otherwise directed by the Resident Engineer. No entrance culverts are to be installed within five (5) feet of a property corner.
- * VDOT standard CG-9D entrances shall be installed in curb and gutter neighborhoods. Contact VDOT for inspection 48 hours prior to entrance installation.
- 13. The developer is responsible for furnishing and installing stop signs at street intersections.
- 14. Design changes, specified materials changes and/or field changes from the approved plans need to be re-submitted to VDOT prior to proceeding with the work. A letter of explanation shall accompany the revised plans and/or drainage calculations, which must be submitted, to VDOT for review and approval by the Resident Engineer
- 15. Contractor shall verify location and elevation of all underground utilities shown on plans in areas of construction prior to starting work. Contact engineer immediately if location or elevation is different from that shown on plan. If there appears to be a conflict, and/or upon discovery of any utility not shown on this plan, call Miss Utility of Central Virginia at 1-800-552-7001. The developer shall be responsible for the relocation of any utility within existing and/or proposed right of way required by the development.
- 16. All streetlights shall be located a minimum of 9.5' from the edge of pavement on curb and gutter streets and/or located a minimum of 5.5' behind the ditch line on open ditch streets.e
- 7. All roadside ditches shown as paved on plans are to be paved in accordance with the standard typical section as shown on the plans. Generally, all ditches with slopes exceeding 5 % or less than 0.75% shall be paved unless otherwise directed by the Resident Engineer. Any additional paving of the ditches, other than those shown on the road plans will be determined prior to acceptance of the roads into the VDOT secondary road system.
- 18. VDOT approval of construction plans does not preclude the right to require additional facilities as deemed necessary for acceptance of the roads into the VDOT Secondary Road System.
- 19. VDOT approval of these plans will expire five (5) years from the date of approval.
- 20. VDOT shall have performed the required field inspection (proof roll) prior to placement of the aggregate base course(s). Contact VDOT for subgrade inspection 48 hours prior to scheduling placement of aggregate bas
- 1. A prime coat seal between the aggregate base and bituminous concrete will be required at a rate of 0.30 gallons per square yard (REC-250 Prime Coat) per VDOT standards and specifications.
- 22. The scheduling of aggregate base installation and subsequent paving activities shall accommodate forecast weather conditions per Section 315 of The Road and Bridge Specifications.
- 23. VDOT shall have approved the aggregate base course(s) for depth, template and performed the required field inspection (proof roll) prior to placement of any surface course(s). Contact VDOT for inspection of the aggregate base course(s) 48 hours prior to application of the surface course(s).
- 24. An actual copy of the complete CBR report is to be submitted to VDOT in conjunction with final pavement designs. All pavement design recommendations shall be performed in accordance with the current edition of The Pavement Design Guide for Subdivision and Secondary Roads in Virginia.
- 25. A geotechnical engineer is to ascertain cause and certify recommended method of repair for all pavement structural failures prior to state acceptance.
- 26. All vegetation and organic material is to be removed from the right of way limits prior to conditioning of the subgrade.
- 27. All materials shall be in accordance with the VDOT Road and Bridge Specifications and Road and Bridge
- 28. Dry gutter is not allowed in VDOT right of way.
- 29. The developer will be responsible for the design costs of any traffic signal installation and/or modification under an account receivable with VDOT.
- 30. The necessity and locations for additional VDOT standard underdrains to be determined at time of subgrade
- 1. Approval of a detailed construction sequencing/maintenance of traffic narrative for the work zone is a prerequisite for issuance of a Land Use Permit allowing access to and construction within VDOT maintained right-of-way.

32. VDOT shall be provided documentation by a geotechnical engineer, certifying that all in-place pavements meet or

- exceed the approved pavement design thickness prior to state acceptance. 33. The establishment of a temporary vegetative cover is required on all denuded areas that are not to be fine graded for
- periods longer than 30 days. 34. No structure shall be constructed on state maintained rights of way unless said structures are shown on road construction plans approved by VDOT or such structures are covered by a VDOT Land Use Permit (or by a letter of intent from the Resident Engineer to issue said permit at the time of state acceptance).

Site Work / Earthwork Notes:

- There was no geotechnical investigation performed on this site.
- For bidding purposes, the Contractor shall assume that on site soils are available for engineered fill as may be required.
- The Contractor shall employ the services of a Geotechnical Firm to observe proof rolling operations. The Geotech. Engineer shall approve borrow material used for engineered fill. The Geotech, shall also monitor all cut and fill operations and shall perform field density tests to verify compaction of same. The density tests shall be conducted at the Geotech. Engineer's discretion.
- 4. The Geotech. Engineer shall provide Owner with a copy of all field test reports and a letter of certification regarding same at completion of site work operations.
- Contractor shall allow Geotech, firm at least 5 working days to check and approve proposed fill material prior to commencing fill operations.
- 6. First step in site work shall be to clear site of stumps, debris, vegetation, topsoil, etc.. Topsoil shall be stockpiled for later use. Location of stockpile shall be coordinated with Owner. Contractor shall ensure that all stockpiles are secure against erosion and shall install additional silt fence as may be required.
- Existing asphalt along Ravenswood Drive shall be removed and hauled off site at the Contractor's expense. Stone sub-base may be reused if found to be suitable by the Geotech. Engineer. See Typical Pavement Section. Also, Contractor may elect to mill / grind existing asphalt and reuse for sub-base at his discretion and as approved by the Geotechnical Engineer.
- Roadway shall then be proof rolled with a partially loaded tandem axle dump truck. The Geotech. Engineer shall be present during the proof rolling operations. All soft areas, if encountered, shall be undercut and controlled filled at the direction of the Geotech. Engineer.
- . The Contractor shall provide unit costs for undercutting, hauling, and control fill if inferior conditions are discovered during proof rolling operations. The Contractor shall also provide a unit cost to underlay gravel with a geotextile fabric such as AMOCO 2002 as may be required.
- 10. Approved fill material shall be placed in lifts of no more than 8". Each lift shall be compacted and approved prior to placing next lift. Compaction criteria shall be 95 % of standard proctor per ASTM D-698 except the final 12" beneath pavement shall be increased to 98%.
- 11. The limits of disturbance in the wetland area shall be kept to a minimum. The Contractor shall take strict care to work inside the 50' right-of-way in the wetland area.
- 12. The Contractor shall acquire any and all necessary construction permits and post bonds for same as may be required by County or VDOT.

Utility Notes:

General: 1. The Contractor shall call Miss Utility at 1-800-552-7001 and shall verify location and elevation of all underground utilities in areas of construction prior to starting

- The Contractor shall coordinate with all utility companies to determine the exact point of service connection at the existing utility.
- All damage incurred to existing utilities during construction shall be repaired at the Contractor's expense.
- All utility construction, i.e. piping, valves, hydrants, meters and boxes, clean outs, manholes, bedding, etc. shall comply with the International Plumbing Code, 1997 and with Prince George County Standards. County Engineer is Mr. Stephen
- McBride, P.E., 804-733-2625. All work shall be subject to inspection by Prince George County. The Contractor shall notify County Official 48 hours prior to the start of work.
- Owner shall be responsible for all utility fees.
- All utility trenches in paved areas shall be backfilled, full height, with VDOT 21A
- 8. GC shall be responsible for groundwater control as may be required.
- 9. Contractor shall submit complete "as-built" drawing of all site utilities at completion of project. All utilities shall be located with exact dimensions on "asbuilt" drawing.

- . Water lines shall be PVC, C900, with push-on, gasketed, joints and 12 ga. braided copper tracer wire.
- Water piping for fire hydrant assembly shall be ductile iron.
- Minimum cover for water line shall be 3.5 feet.
- Water line and sanitary sewer line shall be separated by at least 10 feet of undisturbed or compacted earth.
- Contractor shall install concrete thrust blocking at all bends, end caps, etc. as required. Same shall comply with County standards.
- All water valves, as shown on the Plan, shall be located in cast iron inspection box marked "Water".
- Lines, valves and hydrants shall be thoroughly flushed and tested per County

Sewer:

- Sanitary sewer line shall be PVC, SDR35, with push-on joints.
- Sanitary sewer manholes shall be standard VDOT, 4' diameter, precast concrete manholes with standard VDOT frame and cover per Standard SMH-1.
- Precast concrete manholes shall be jointed with preformed plastic gaskets. Manholes shall be set on 12" of stone. Steps shall be forged extruded aluminum or steel reinforced corrosion resistant rubber.
- Manhole invert channels shall be shaped smooth and shall be formed with concrete per VDOT Standard IS-1. Changes in direction shall have as long a radius as manhole permits. Pipe to manhole connections shall be made with approved neoprene seal assemblies.
- 5. Gravity sewer lines shall be bedded in gravel see Typical Detail on the plans.
- 6. Each section of line shall be air tested per County standards.

Legend:

DI	Drop Inlet	FL	Flow Line	HT H	Existing Overhead Telephone Line
R	Radius	MW	Monitoring Well	· · · · · · · · · · · · · · · · · · ·	Existing Gas Line
HP	High Point	125	Proposed Topo	HE H	Existing Overhead Electric
SW	Sidewalk	125	Exist. Topo	e e uGC e e	Existing Underground Conduit
Ex.	Existing	× 125.5	Proposed Spot Grade		Ex. Asphalt
FH	Fire Hydrant	- 125.0	Exist. Spot Grade		
EOP	Edge Of Pavement	125.5	Top of Curb		Ex. SW
EOG	Edge Of Gravel	★ 125.0	Flow Line of Gutter]]]]STS]]]]	Proposed Storm Sewer Line
MH	Manhole	• · · · • UGE • · · •	Existing Underground Electric	————G———	Proposed Gas Line
WV	Water Valve	$(v_1, \ldots, v_m) \in W \times_{\mathbb{R}^{n-1}} (v_1, \ldots, v_m)$	Existing Water Line	——— UGC ———	Proposed Underground Conduit
WM	Water Meter	• · · · • \$\$ • · · · •	Existing Sanitary Sewer Line	OHE	Proposed Overhead Electric
UP	Utility Pole	III.I I.STSI . I .	Existing Storm Sewer		Proposed Underground Electric
GW	Guy Wire	•••••UG*••••	Existing Underground Telephone Line	——	Proposed Water Line
LP	Light Pole	OHT FOR	Existing Overhead Telephone Line	SS	Proposed Sanitary Sewer Line
C&G	Curb & Gutter				

---- OHT Proposed Overhead Telephone Line S.S. Cleanout Proposed Fire Hydrant Assembly Gate Valve Water Meter

Limits Of Easement

Edge Of Woods

——UGT —— Proposed Underground Telephone Line

New SW

Bench Mark New Site Lighting New Heavy Duty Asphalt New Light Duty Asphart

Survey Control Point

Drawing List:

Vicinity Map

Owner & Developer: I. Roland Specter

P.O. Box 1936

Petersburg, Virginia

Ravenswood Drive

M-1, Limited Industrial

Prince George, VA 23875

Allowed = 70%, Provided = N/A

10' Required. Provided = N/A

10' Required, Provided = N/A

0' Required, Provided = N/A

60' Allowed, Provided = N.A.

Ph: 804-732-1910

Fx: 804-732-1915

TM. 33 - (A) - 13

Rives District

11 904 Acres

Scale: 1'' = 2.000'

General Notes:

Legal Information:

Site Address:

Zoning:

Lot Size.

8 Lot Width:

10. Setback:

11. Side Yard:

12 Rear Yard

13. Parking:

14 Water

15 Sewer

13 Building Height

6. Lot Coverage:

Lot Frontage:

9. Length / Width Ratio: N/A

Sheet 1 of 4: Cover Sheet Sheet 2 of 4. Site Plan

Sheet 3 of 4: Profiles & Sections Sheet Sheet 4 of 4: E & S & Details Sheet

October 10, 2002 Rev Nov 18, 2002 Rev Jan. 22, 2003