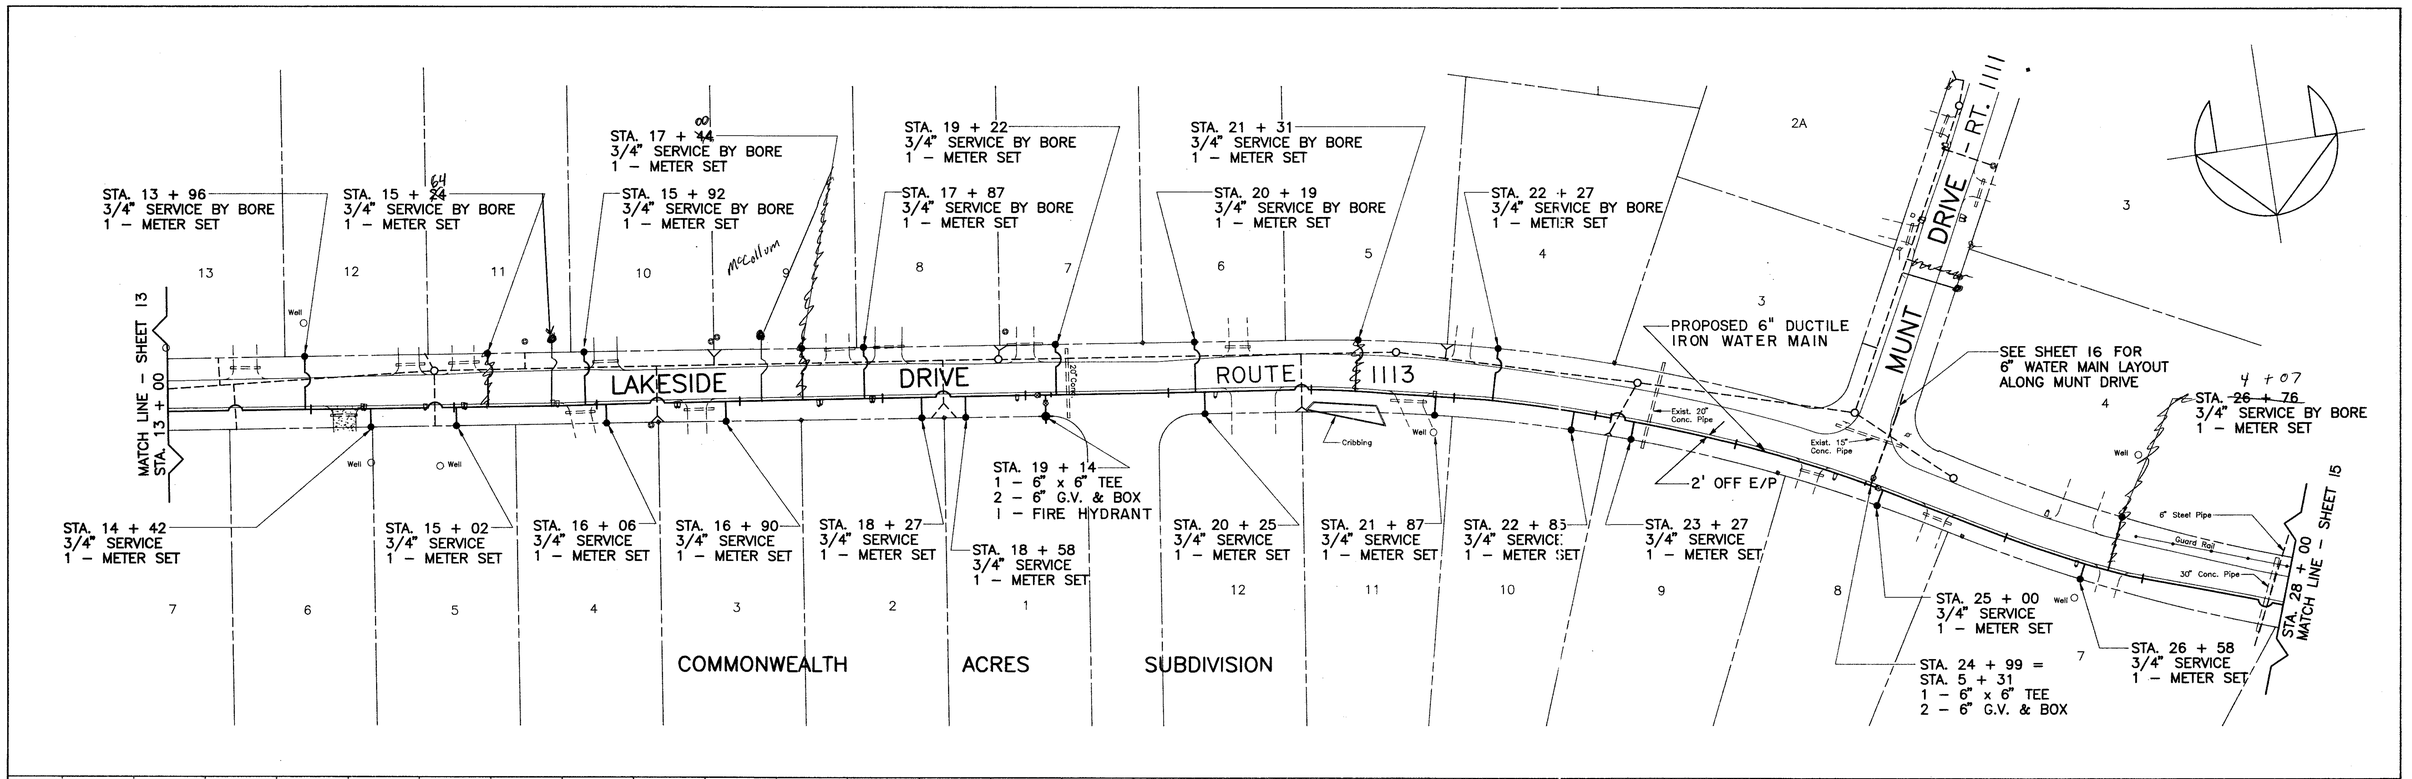

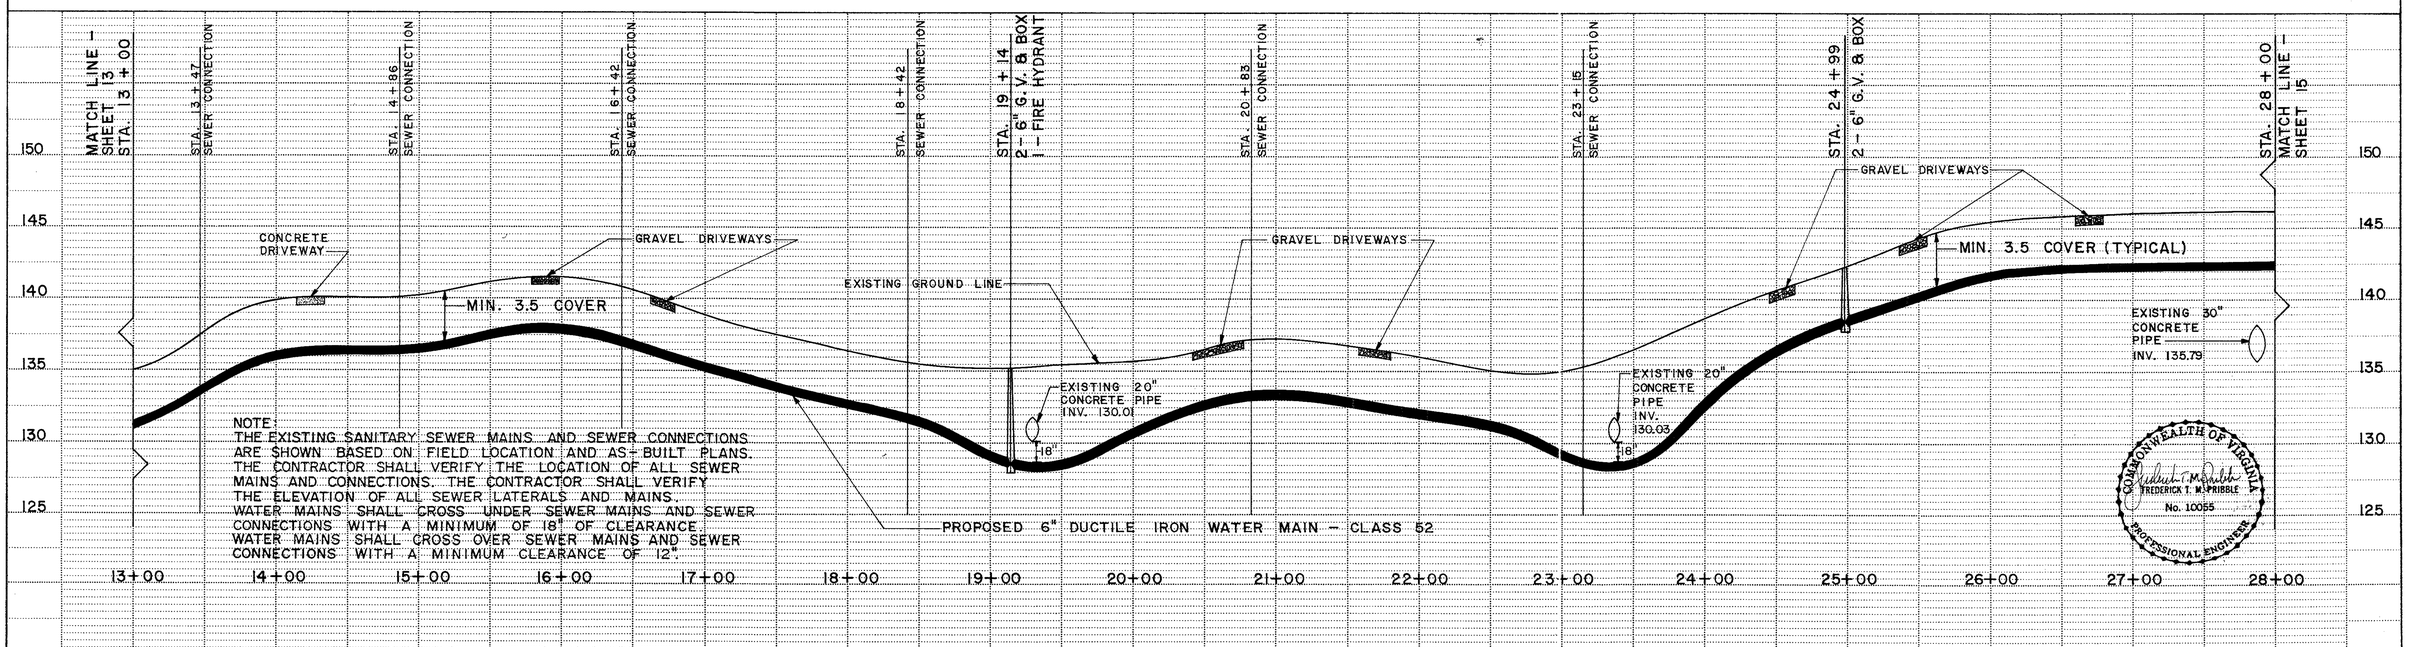

NOTE:
THE EXISTING SANITARY SEWER MAINS AND SEWER CONNECTIONS ARE SHOWN BASED ON FIELD LOCATION AND AS-BUILT PLANS. THE CONTRACTOR SHALL VERIFY THE LOCATION OF ALL SEWER MAINS AND CONNECTIONS. THE CONTRACTOR SHALL VERIFY THE ELEVATION OF ALL SEWER LATERALS AND MAINS. WATER MAINS SHALL CROSS UNDER SEWER MAINS AND SEWER CONNECTIONS WITH A MINIMUM OF 18" OF CLEARANCE. WATER MAINS SHALL CROSS OVER SEWER MAINS AND SEWER CONNECTIONS WITH A MINIMUM CLEARANCE OF 12".

COMMONWEALTH OF VIRGINIA
FREDERICK T. McPRIBBLE
No. 10055
PROFESSIONAL ENGINEER

PLAN — SURVEYED, PLOTTED, ALIGNMENT CHECKED, BY, DATE — NOTE BOOK NO. — BY — DATE

PROFILE — SURVEYED, PLOTTED, GRADES CHECKED, BY, DATE — NOTE BOOK NO. — BY — DATE — STRUCTURE NOTATNS CH'KD

Draper Aden Associates
CONSULTING ENGINEERS
Blacksburg · Richmond, Virginia

DESIGNED	FTP
DRAWN	HLJ / SKG
CHECKED	JNL
DATE	2/26/89

ROUTE 106/COMMONWEALTH ACRES WATER MAINS
PRINCE GEORGE COUNTY, VIRGINIA

PLAN & PROFILE

REVISIONS:
3-28-89

SCALE: H 1" = 50'
V 1" = 5'

PLAN Nº T-20213-01

SHEET 14 OF 19

american blueprint of columbia 305082