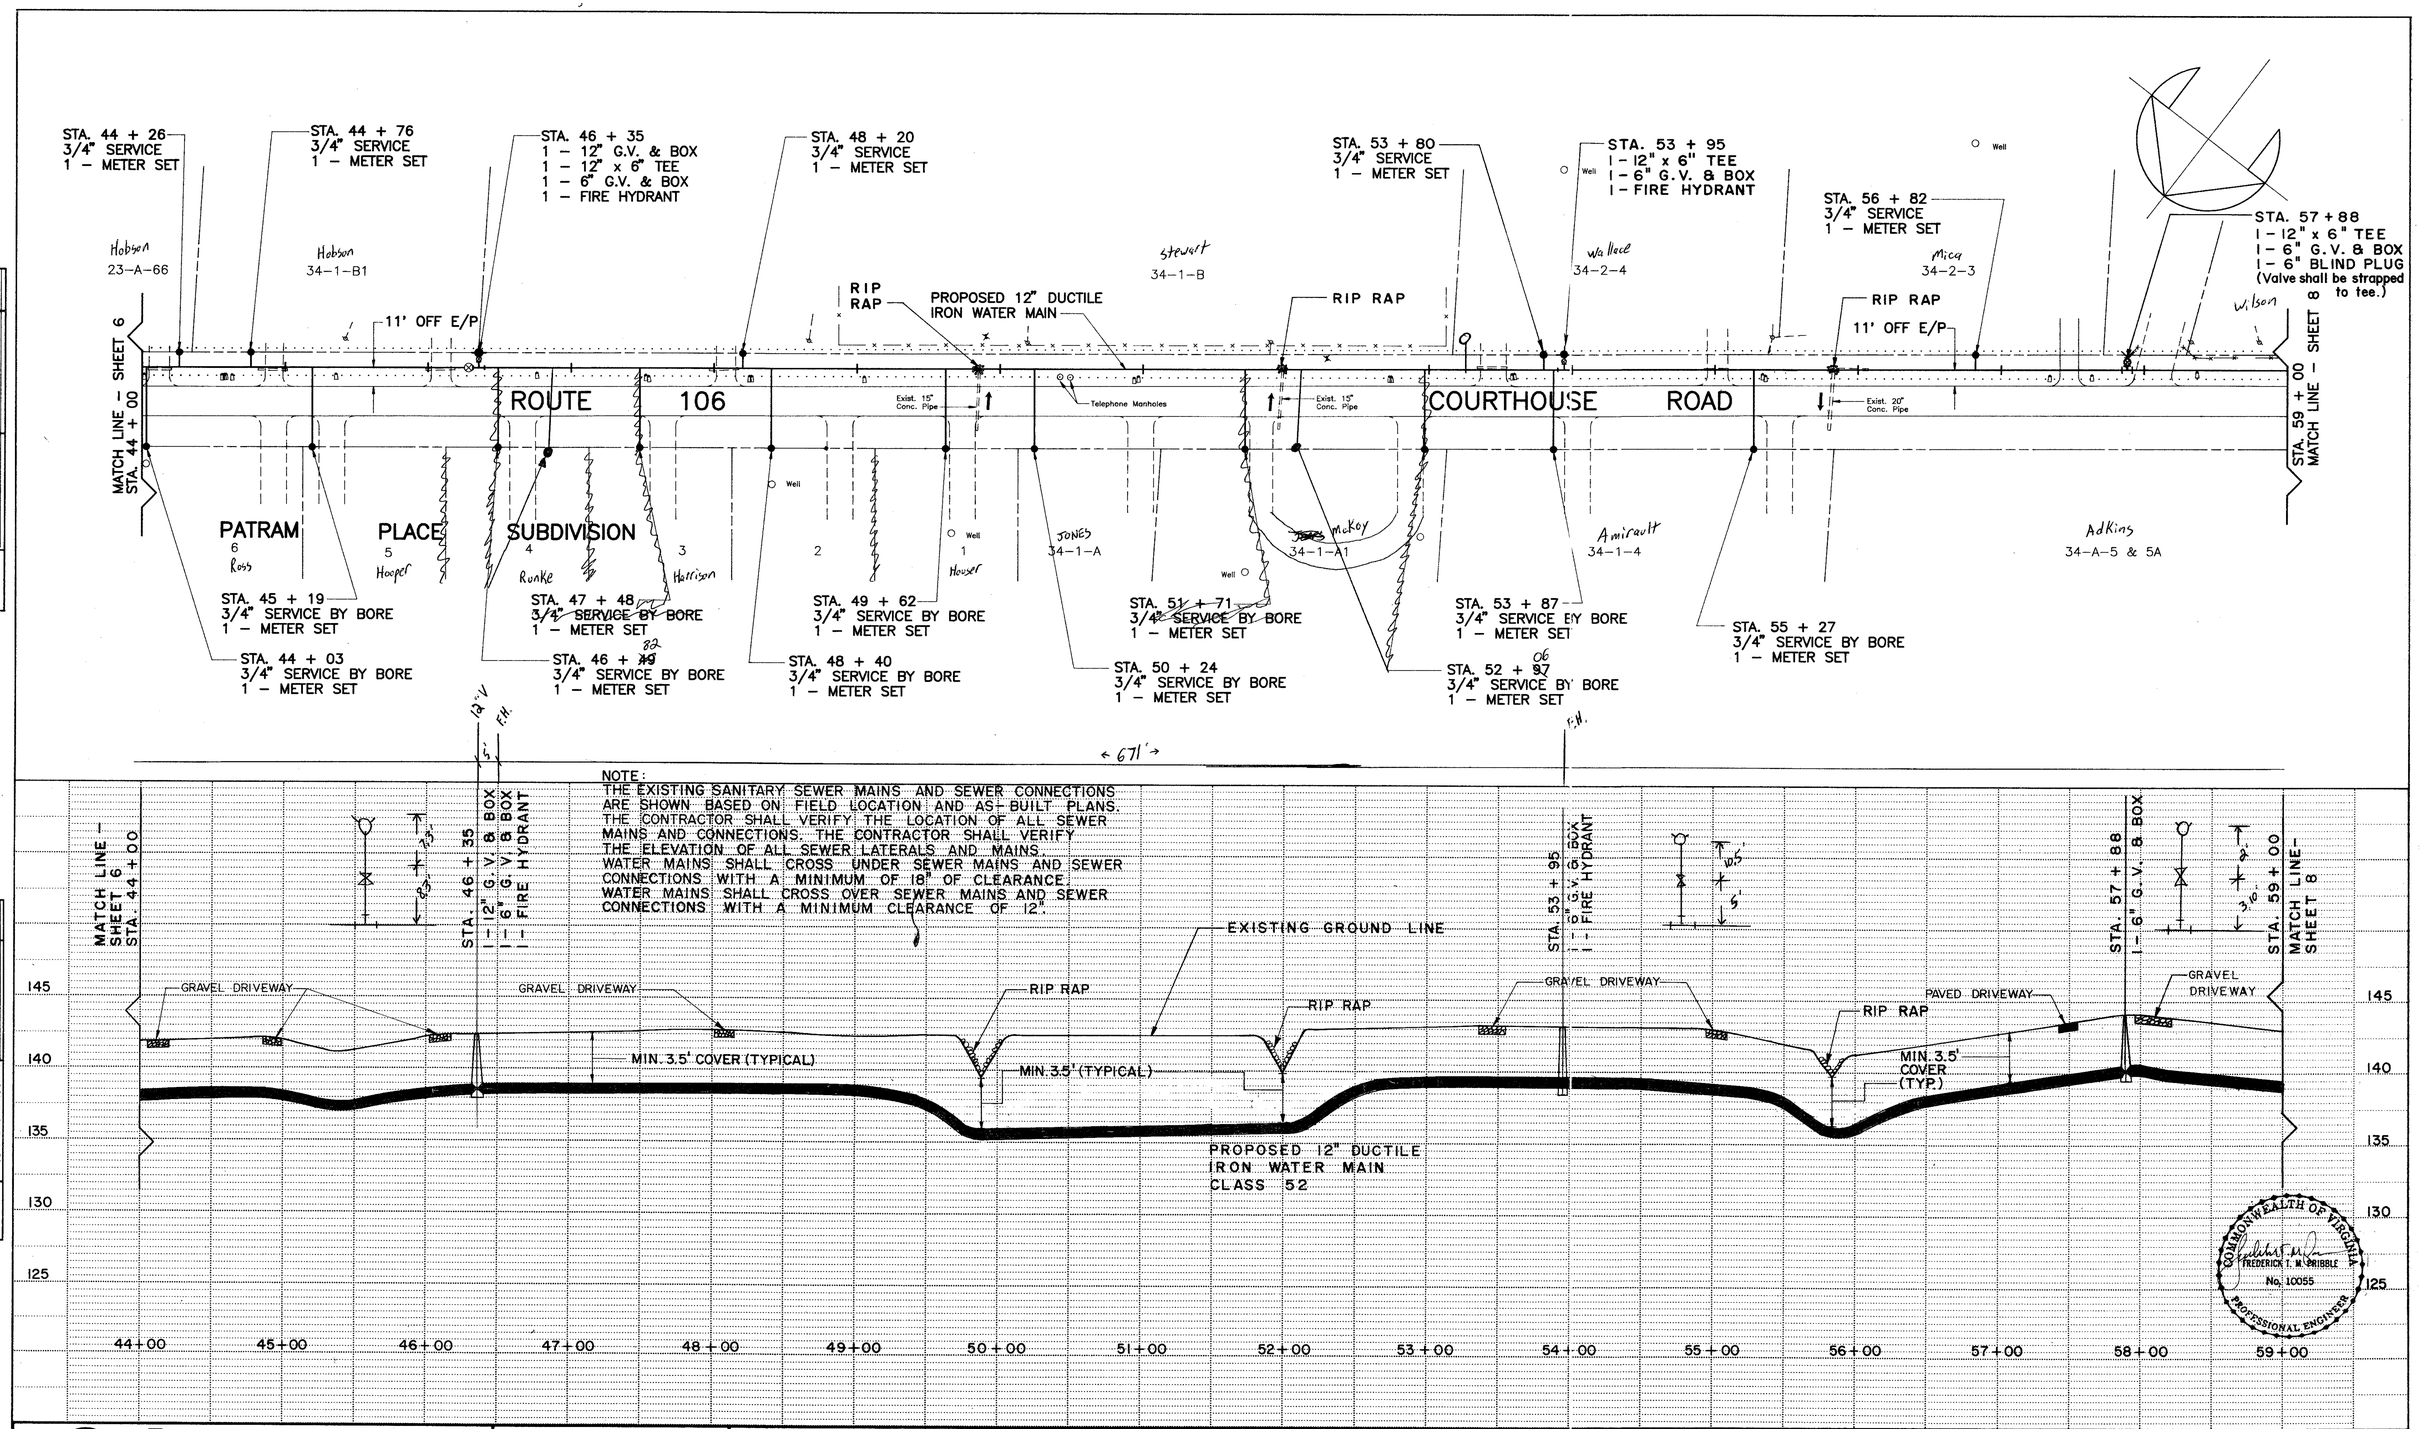

PLAN	DATE	BY
SURVEYED		
PLOTTED		
ALIGNMENT CHECKED		
R/W PLAN CHECKED		
NOTE BOOK NO.		

PROFILE	DATE	BY
SURVEYED		
PLOTTED		
GRADES CHECKED		
B. M. NOTED		
STRUCTURE NOTATIONS CHKD		
NOTE BOOK NO.		

Draper Aden Associates
CONSULTING ENGINEERS
Blacksburg · Richmond, Virginia

DESIGNED	FTP
DRAWN	HLJ / TDC
CHECKED	JNL
DATE	2/26/89

ROUTE 106/COMMONWEALTH ACRES WATER MAINS
PRINCE GEORGE COUNTY, VIRGINIA

PLAN & PROFILE

REVISIONS:
3-28-89

SCALE: H 1" = 50'
V 1" = 5'

PLAN Nº T-20213-01

SHEET 7 OF 19

american blueprint of columbia 305052