Sewer only

U. S. ROUTE #301 TRUNK SEWER

RIVES DISTRICT

PRINCE GEORGE COUNTY, VIRGINIA

DATE: MAY 16, 1979
PROJECT: 790126

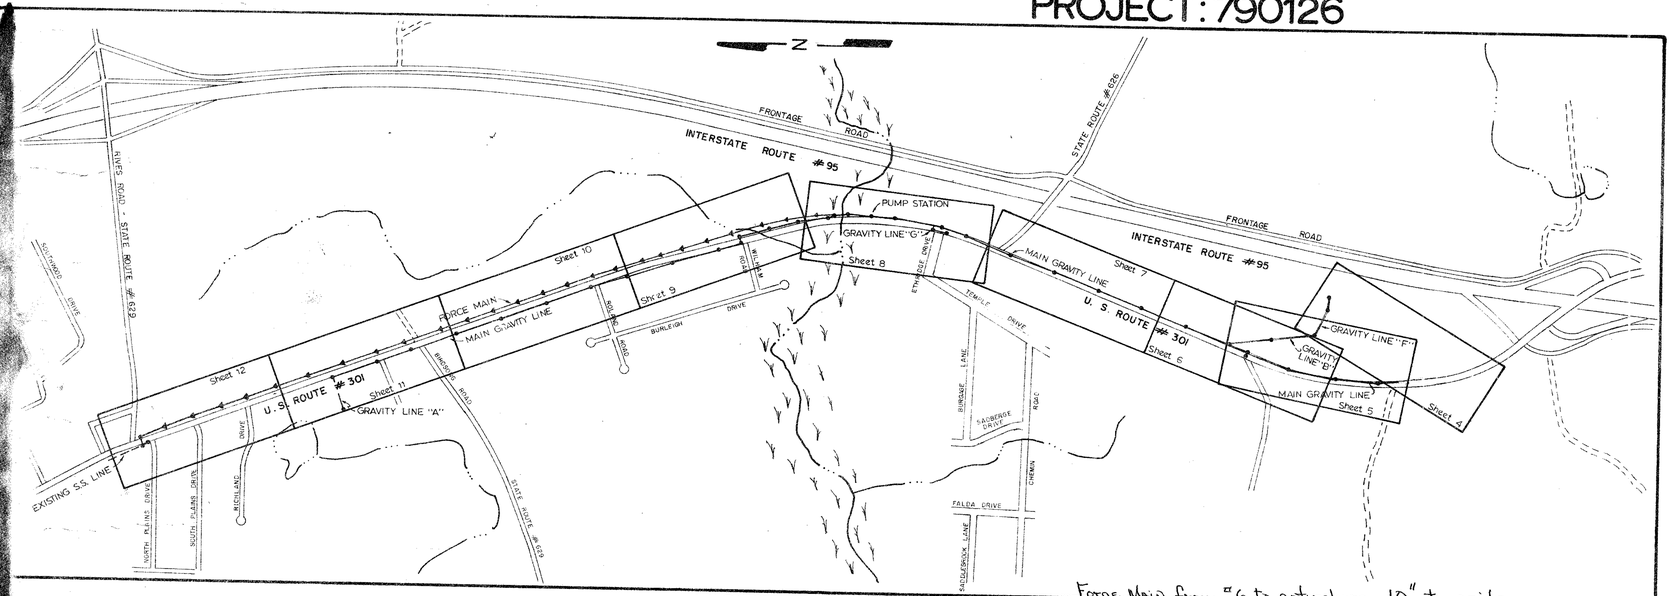

Force Main from #6 to petersburg 10" transite

VICINITY SKETCH
SCALE: 1" = 600'

ENGINEERS - SURVEYORS

CHARLES C. TOWNES & ASSOCIATES
110 NORFOLK AVENUE P.O. BOX 97
COLONIAL HEIGHTS, VIRGINIA 23834
PHONE: 526-6766

AS BUILT
April 3-1981

LEGEND

△	SURVEY STATION (Iron Rod or P K Nail)	·····	EDGE of GRAVEL AREA	⟋⟋⟋⟋	DITCHLINE	✧F.H.	FIRE HYDRANT
———	SURVEY LINE	— — —	EXISTING ENTRANCE CULVERTS and STORM DRAINAGE SYSTEMS (Unless Otherwise Noted)	⊠	TELEPHONE BOOTH	~~~	STREAMS, BRANCHES, ETC.
△	MANHOLE = SURVEY STATION	~~~~~	WOODS LINE	○	DROP INLETS and CATCH BASINS	———	PROJECT TRUNKLINE
⊙	PROJECT MANHOLE	• • • •	TREES, SHRUBS, ETC.	○	WELL	— — —	EXISTING TRUNKLINE (By Others)
●	EXISTING MANHOLE	GUY WIRE	POWER POLE	—+—	OVERHEAD WIRES	SC	SANITARY SEWER SERVICE CONNECTION
———	U. S. ROUTE #301 R/W	○	C & P UNDERGROUND CABLE PEDESTAL	——	SIGNS	①	BENCHMARK
— — —	GAS LINE	W.V.	WATER VALVE	• • • • •	POSTS, CONCRETE COLUMNS, ETC.		
———	EDGE of PAVEMENT	C.O.-S.S.	SANITARY SEWER CLEAN - OUT	—+—+—	FENCE ROW		

APRIL 2, 1981 SERVICE CONNECTIONS REVISED AS PER CONTRACTORS' AS BUILT NOTES.

COMMONWEALTH OF VIRGINIA
CHARLES E. TOWNES
CERTIFICATE No.
10478
PROFESSIONAL ENGINEER

Sheet 1