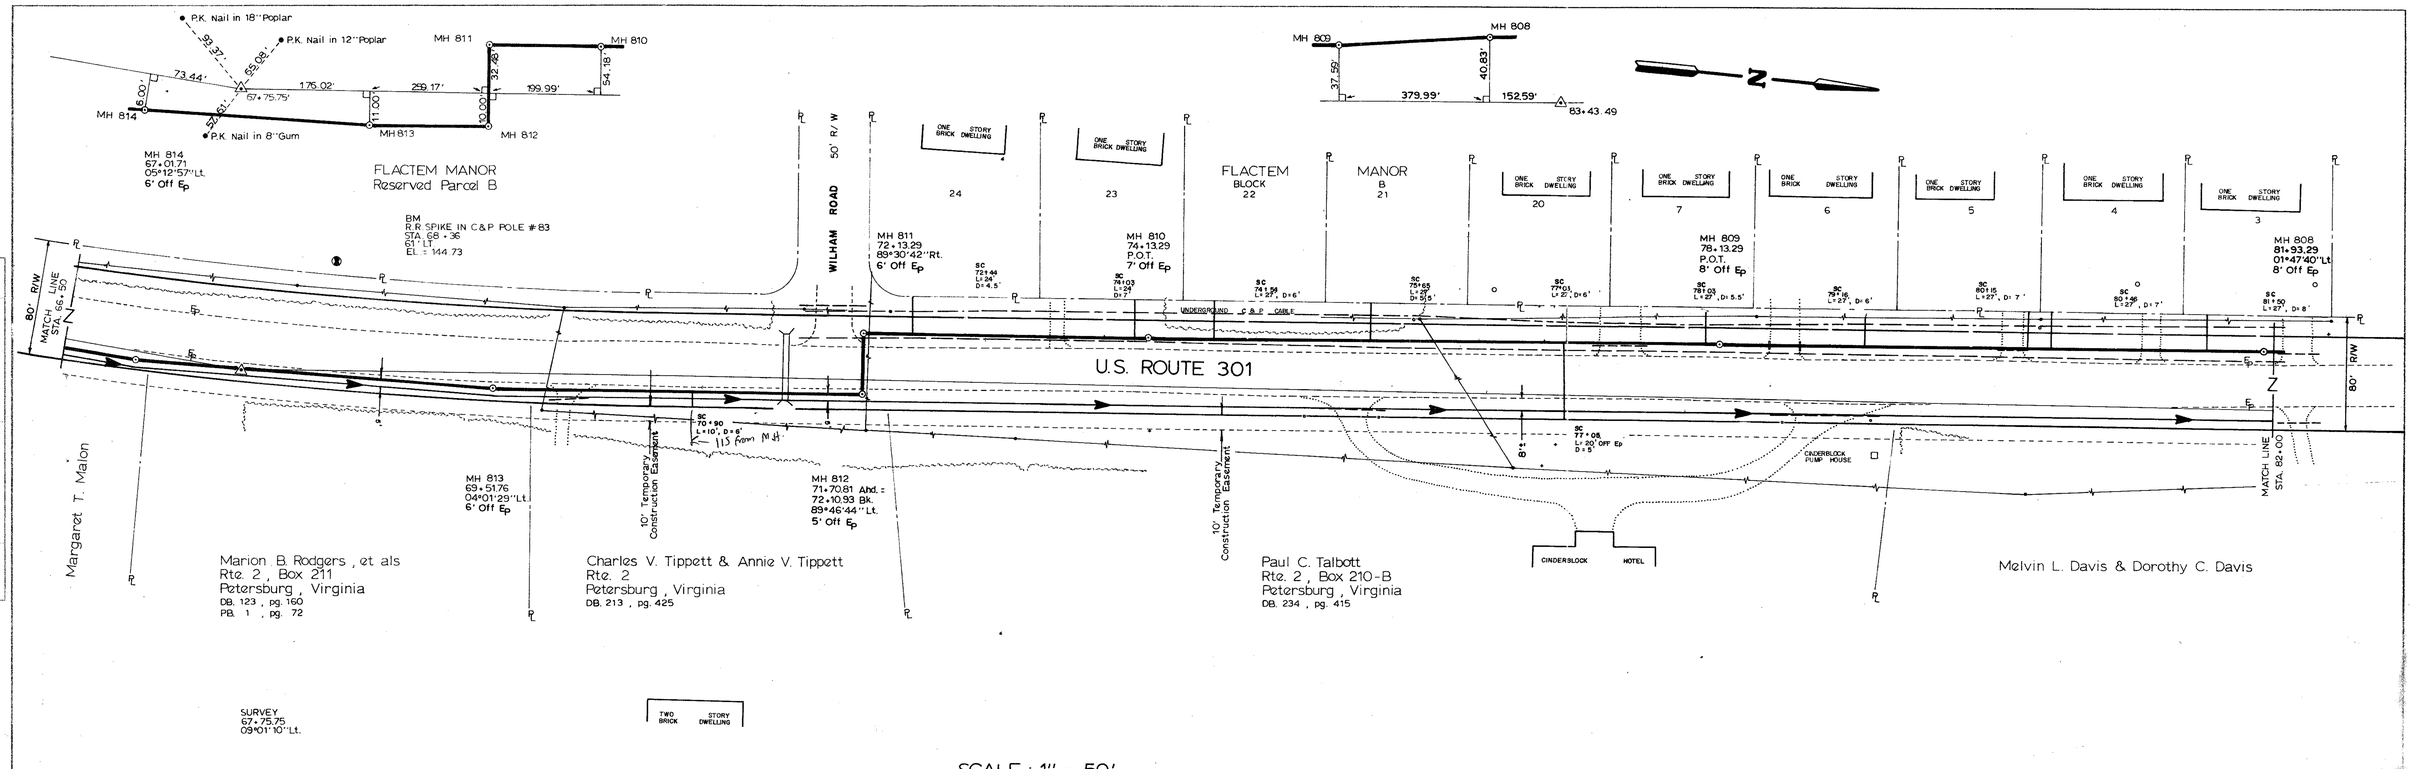

SCALE : 1" = 50'

SCALE
HORIZONTAL 1" = 50'
VERTICAL 1" = 5'

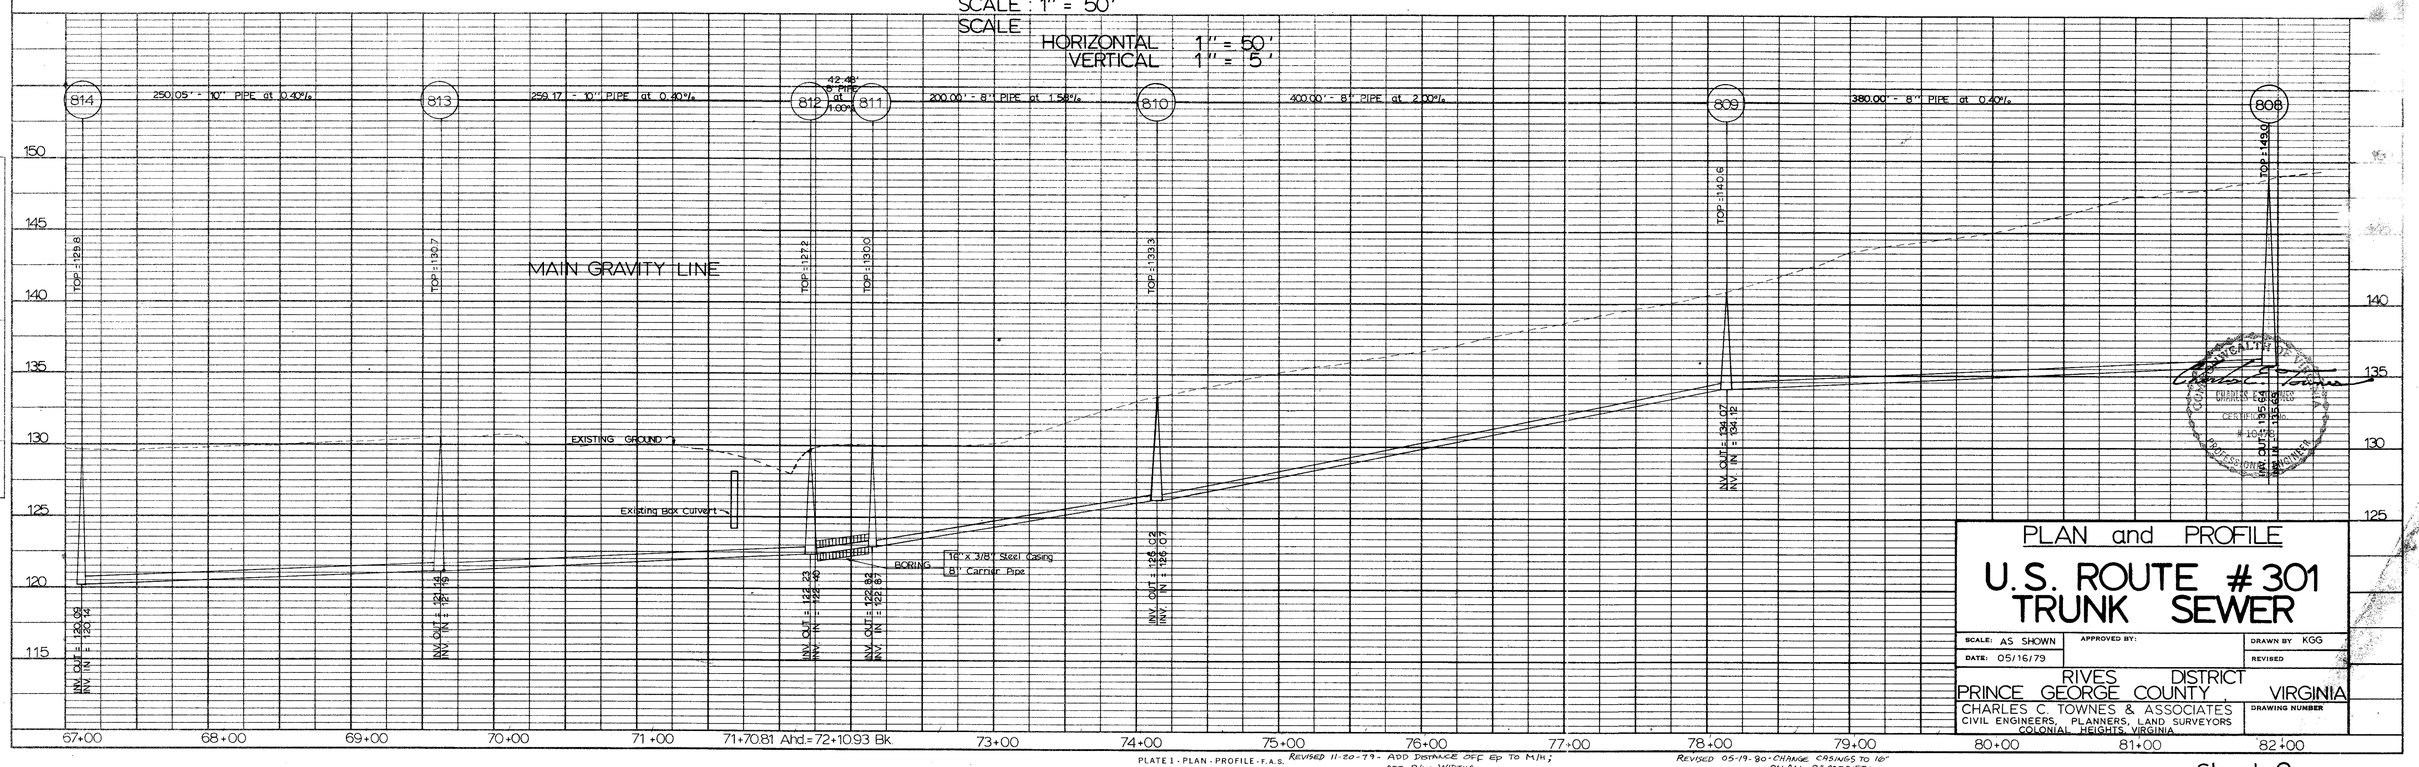

PLAN and PROFILE

U.S. ROUTE #301 TRUNK SEWER

SCALE: AS SHOWN	APPROVED BY:	DRAWN BY KGG
DATE: 05/16/79		REVISED

RIVES DISTRICT
PRINCE GEORGE COUNTY VIRGINIA

CHARLES C. TOWNES & ASSOCIATES
CIVIL ENGINEERS, PLANNERS, LAND SURVEYORS
COLONIAL HEIGHTS, VIRGINIA

DRAWING NUMBER

PLATE 1 - PLAN - PROFILE - F.A.S.
CLEARPRINT PAPER CO., S.F. CAL.
NO. 1000H-1

REVISED 11-20-79 - ADD DISTANCE OFF Ep TO MH; ADD R/W WIDTHS RELOCATE MH 808

REVISE LOCATION SKETCH AT STA. 83+43.49 LABEL US RTE. 301

REVISED 05-19-80 - CHANGE CASINGS TO 16" ON ALL 8" CARRIERS

Sheet 9

PLAN
NOTE BOOK
NO.
SURVEYED
PLOTTED
ALIGNMENT CHECKED
R/W PLAN CHECKED
BY
DATE

PROFILE
NOTE BOOK
NO.
SURVEYED
PLOTTED
GRADES CHECKED
R/W PLAN
STRUCTURE NOTATNS CHECKD
DATE