SOUTHPOINT BUSINESS PARK
UTILITIES EXTENSION
PRINCE GEORGE COUNTY, VIRGINIA

LEGEND

EXISTING FEATURES:

- DROP INLET & STORM SEWER
- STORM SEWER & MANHOLE
- SANITARY SEWER & MANHOLE
- CLEANOUT
- WATERLINE
- WATER VALVE
- WATER METER
- CHECK VALVE
- FIRE HYDRANT
- WELL (POTABLE)
- GAS VALVE
- GAS DRIP
- POWER POLE
- LIGHT POLE/STREET LAMP
- POWER/TELEPHONE LINE
- CONTOUR LINE
- UNDERGROUND TELEPHONE
- UNDERGROUND POWER
- EDGE OF PAVEMENT
- SOIL BORING LOCATION

DEMOLITION

- REMOVE PIPE
- REMOVE POWER POLE
- REMOVE STRUCTURE
- REMOVE TREE
- REMOVE ASPHALT/GRAVEL

PROPOSED FEATURES:

- DROP INLET
- CG-6
- CG-6R
- HEAVY DUTY ASPHALT
- LIGHT DUTY ASPHALT
- DRAINAGE DIVIDES
- PROPOSED CONTOURS
- DROP INLET & STORM SEWER
- STORM SEWER MANHOLE
- SANITARY SEWER & MANHOLE
- CLEANOUT
- WATERLINE
- WATER VALVE
- WATER METER
- FIRE HYDRANT

EROSION CONTROL FEATURES

- INLET PROTECTION
- OUTLET PROTECTION (RIP RAP)
- DIVERSION DIKE
- TEMPORARY SEDIMENT BASIN
- CONSTRUCTION ENTRANCE
- SILT FENCE
- TREE PROTECTION
- LIMITS OF CLEARING AND CONSTRUCTION
- TEMPORARY CONSTRUCTION FENCING

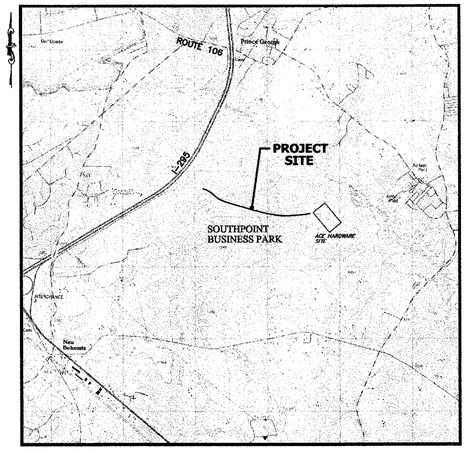

VICINITY MAP
NOT TO SCALE

SHEET INDEX:

SHEET TITLE	SHEET NO.
COVER SHEET	U1
NOTES/SHEET INDEX	U2
PLAN AND PROFILES	U3 - U10
DETAILS	D1 - D2

THE INFORMATION SHOWN ON THESE RECORD DRAWINGS HAS BEEN PROVIDED BY THE CONTRACTOR AND THE COUNTY AND IS FOR GENERAL INFORMATION PURPOSES ONLY. DRAPER ADEN ASSOCIATES DID NOT PERFORM A FINAL AS-BUILT SURVEY ON THIS PROJECT.

Draper Aden Associates
Blacksburg • Richmond, Virginia
Engineering • Surveying • Environmental Services

SEPTEMBER 15, 2000

RECORD DRAWINGS: 1/18/02

SEAL:

COMMONWEALTH OF VIRGINIA
JEFFREY P. KAPINOS
No. 21876
1/18/02
PROFESSIONAL ENGINEER

SEAL:

SHEET NO.
U1

DAA PROJECT NO. R00223.04F

P:\PROJECTS\R00\R00223\R00223-03L\DWG\00223CS.DWG