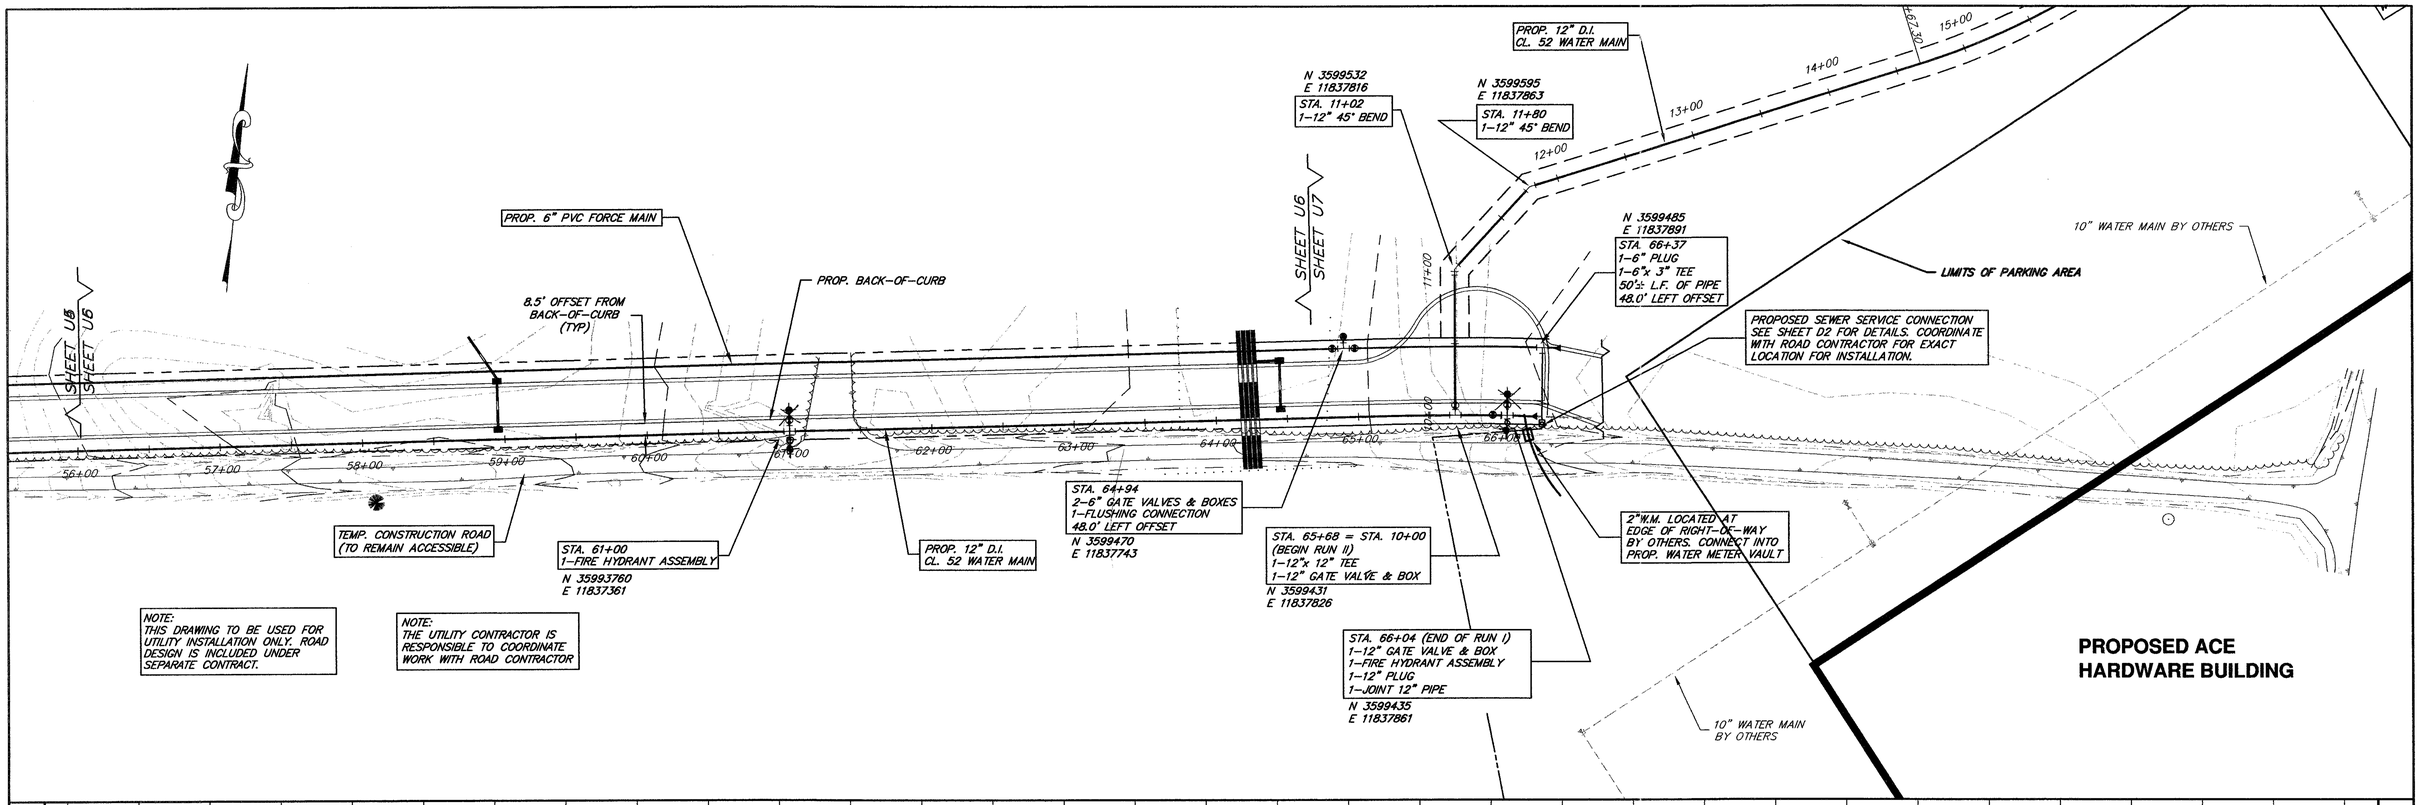

NOTE:
THIS DRAWING TO BE USED FOR UTILITY INSTALLATION ONLY. ROAD DESIGN IS INCLUDED UNDER SEPARATE CONTRACT.

NOTE:
THE UTILITY CONTRACTOR IS RESPONSIBLE TO COORDINATE WORK WITH ROAD CONTRACTOR

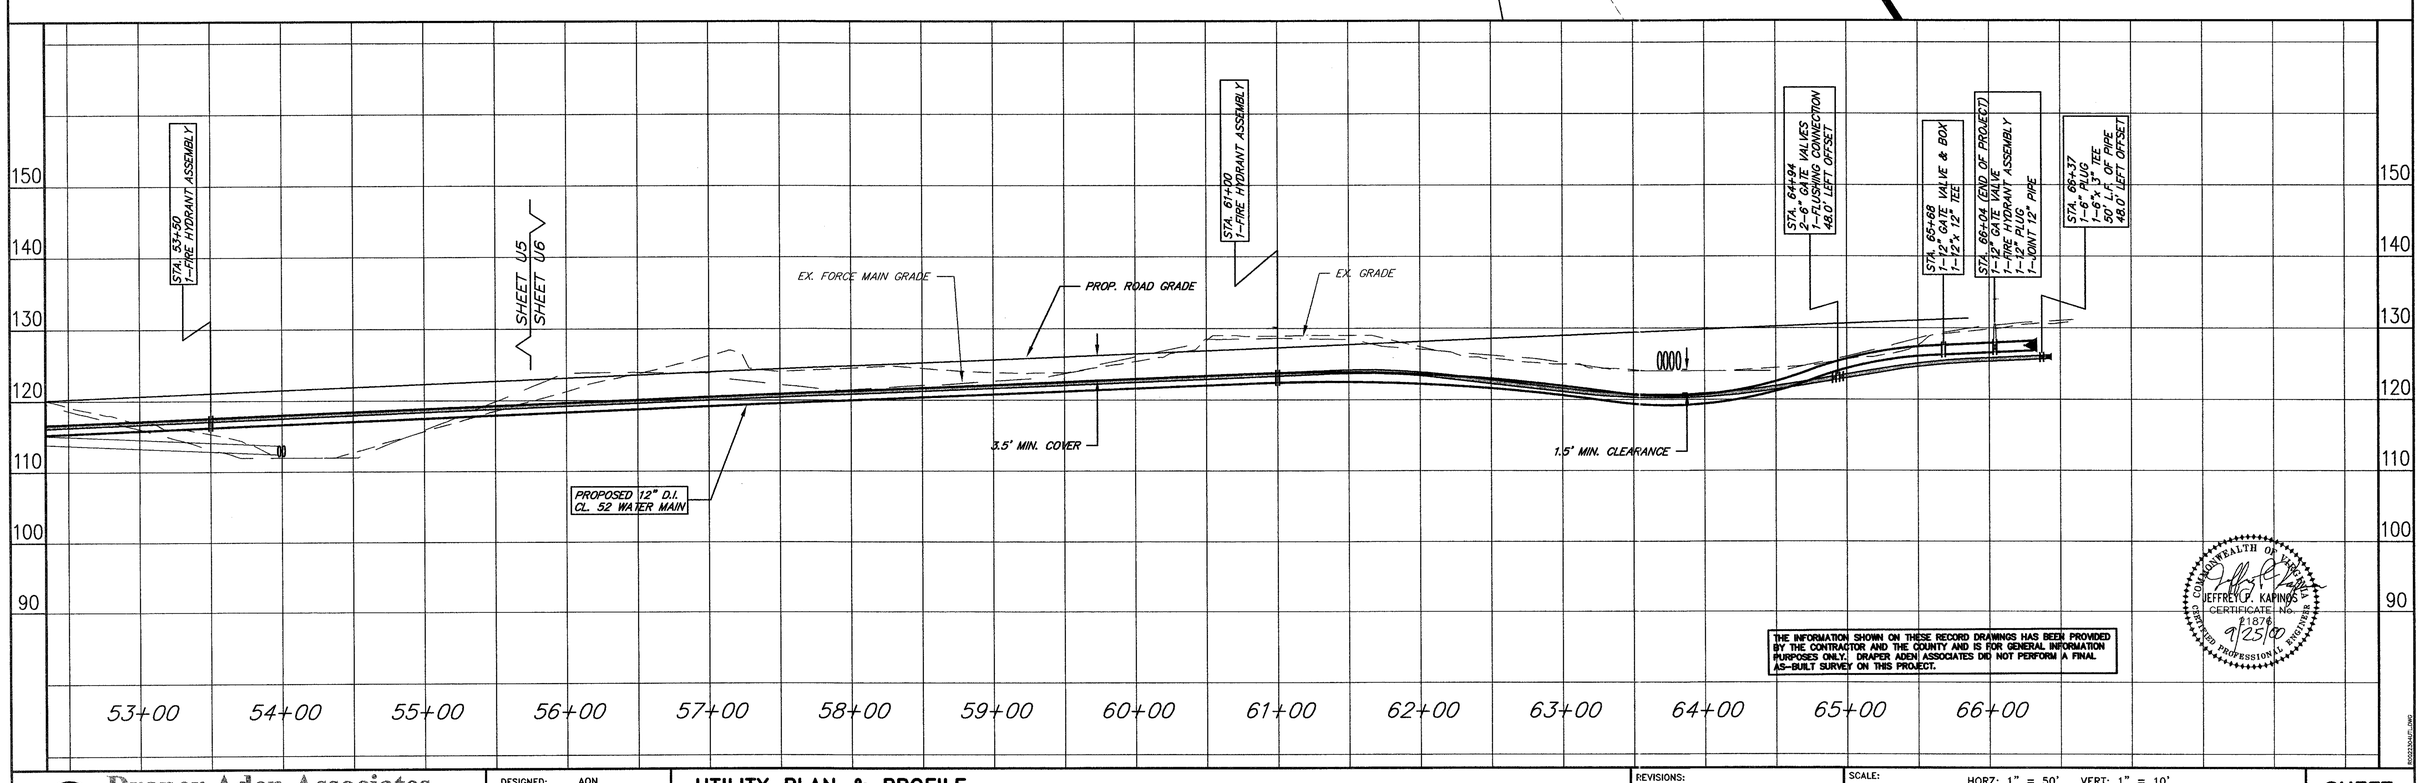

THE INFORMATION SHOWN ON THESE RECORD DRAWINGS HAS BEEN PROVIDED BY THE CONTRACTOR AND THE COUNTY AND IS FOR GENERAL INFORMATION PURPOSES ONLY. DRAPER ADEN ASSOCIATES DID NOT PERFORM A FINAL AS-BUILT SURVEY ON THIS PROJECT.

COMMONWEALTH OF VIRGINIA
JEFFREY P. KAPINOS
CERTIFICATE NO. 21874
9/25/00
CERTIFIED PROFESSIONAL ENGINEER

R00223\04UTL.DWG

Draper Aden Associates
Blacksburg • Richmond, Virginia
Engineering • Surveying • Environmental Services

DESIGNED:	AQN
DRAWN:	AQN
CHECKED:	JPK
DATE:	9-15-00

UTILITY PLAN & PROFILE
SOUTHPOINT BUSINESS PARK UTILITY EXTENSION
PRINCE GEORGE COUNTY, VIRGINIA

REVISIONS:

SCALE: HORZ: 1" = 50' VERT: 1" = 10'

PLAN NO. R00223-04F

SHEET U6