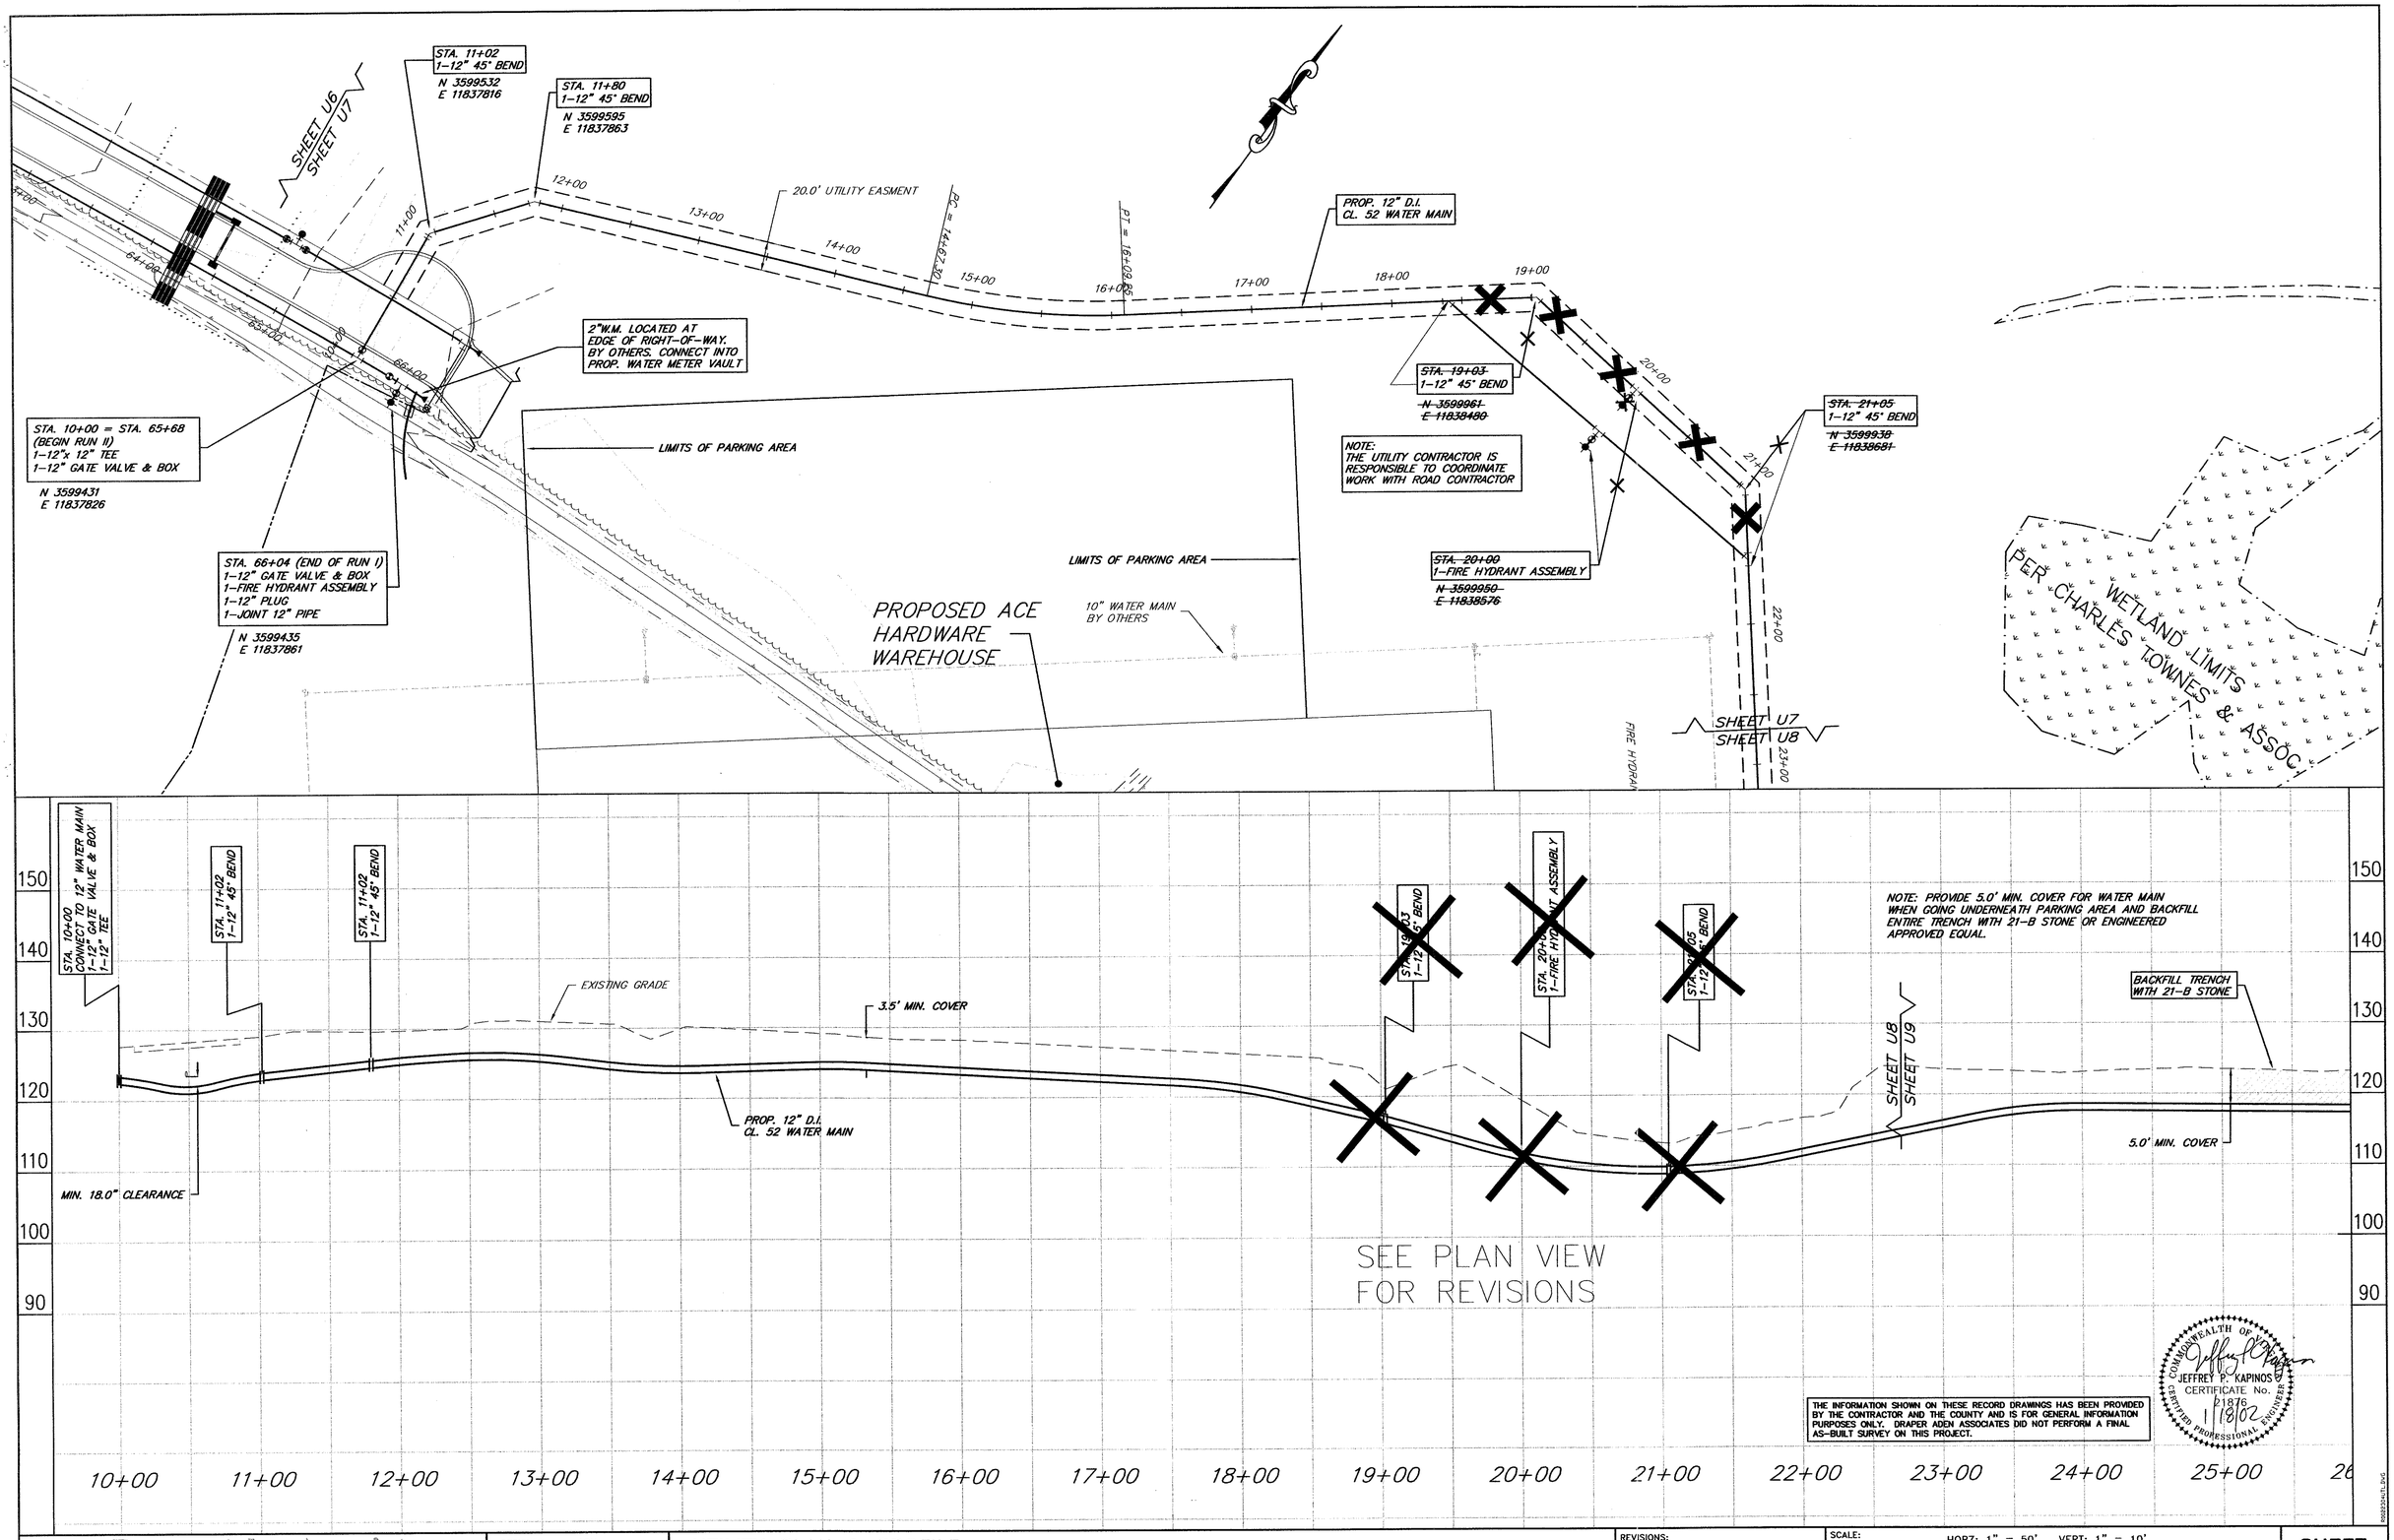

THE INFORMATION SHOWN ON THESE RECORD DRAWINGS HAS BEEN PROVIDED BY THE CONTRACTOR AND THE COUNTY AND IS FOR GENERAL INFORMATION PURPOSES ONLY. DRAPER ADEN ASSOCIATES DID NOT PERFORM A FINAL AS-BUILT SURVEY ON THIS PROJECT.

COMMONWEALTH OF VIRGINIA
JEFFREY P. KAPINOS
CERTIFICATE No. 21876
1/18/02
CERTIFIED PROFESSIONAL ENGINEER

R00223SHUTL.DWG

Draper Aden Associates
Blacksburg • Richmond, Virginia
Engineering • Surveying • Environmental Services

DESIGNED:	AQN
DRAWN:	AQN
CHECKED:	JPK
DATE:	9-15-00

UTILITY PLAN & PROFILE
SOUTHPOINT BUSINESS PARK UTILITY EXTENSION
PRINCE GEORGE COUNTY, VIRGINIA

REVISIONS:

SCALE: HORZ: 1" = 50' VERT: 1" = 10'

PLAN NO. R00223-04F

SHEET U7