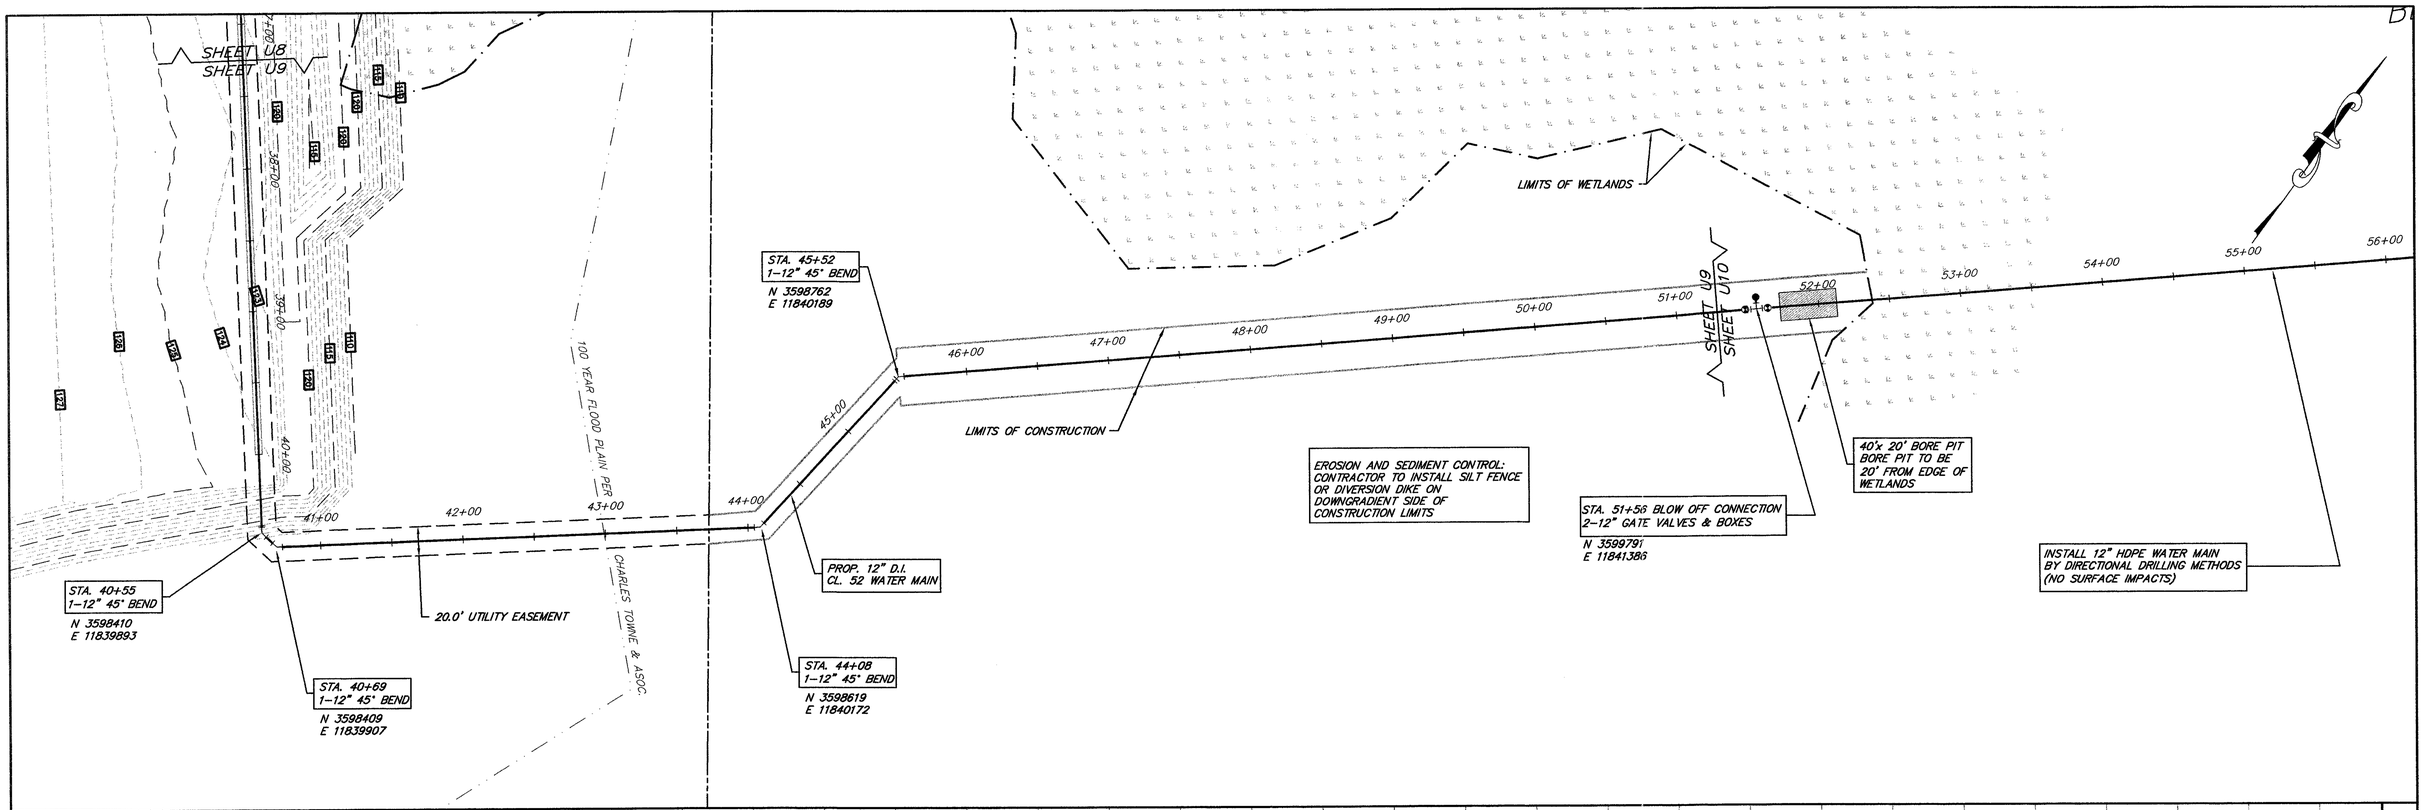

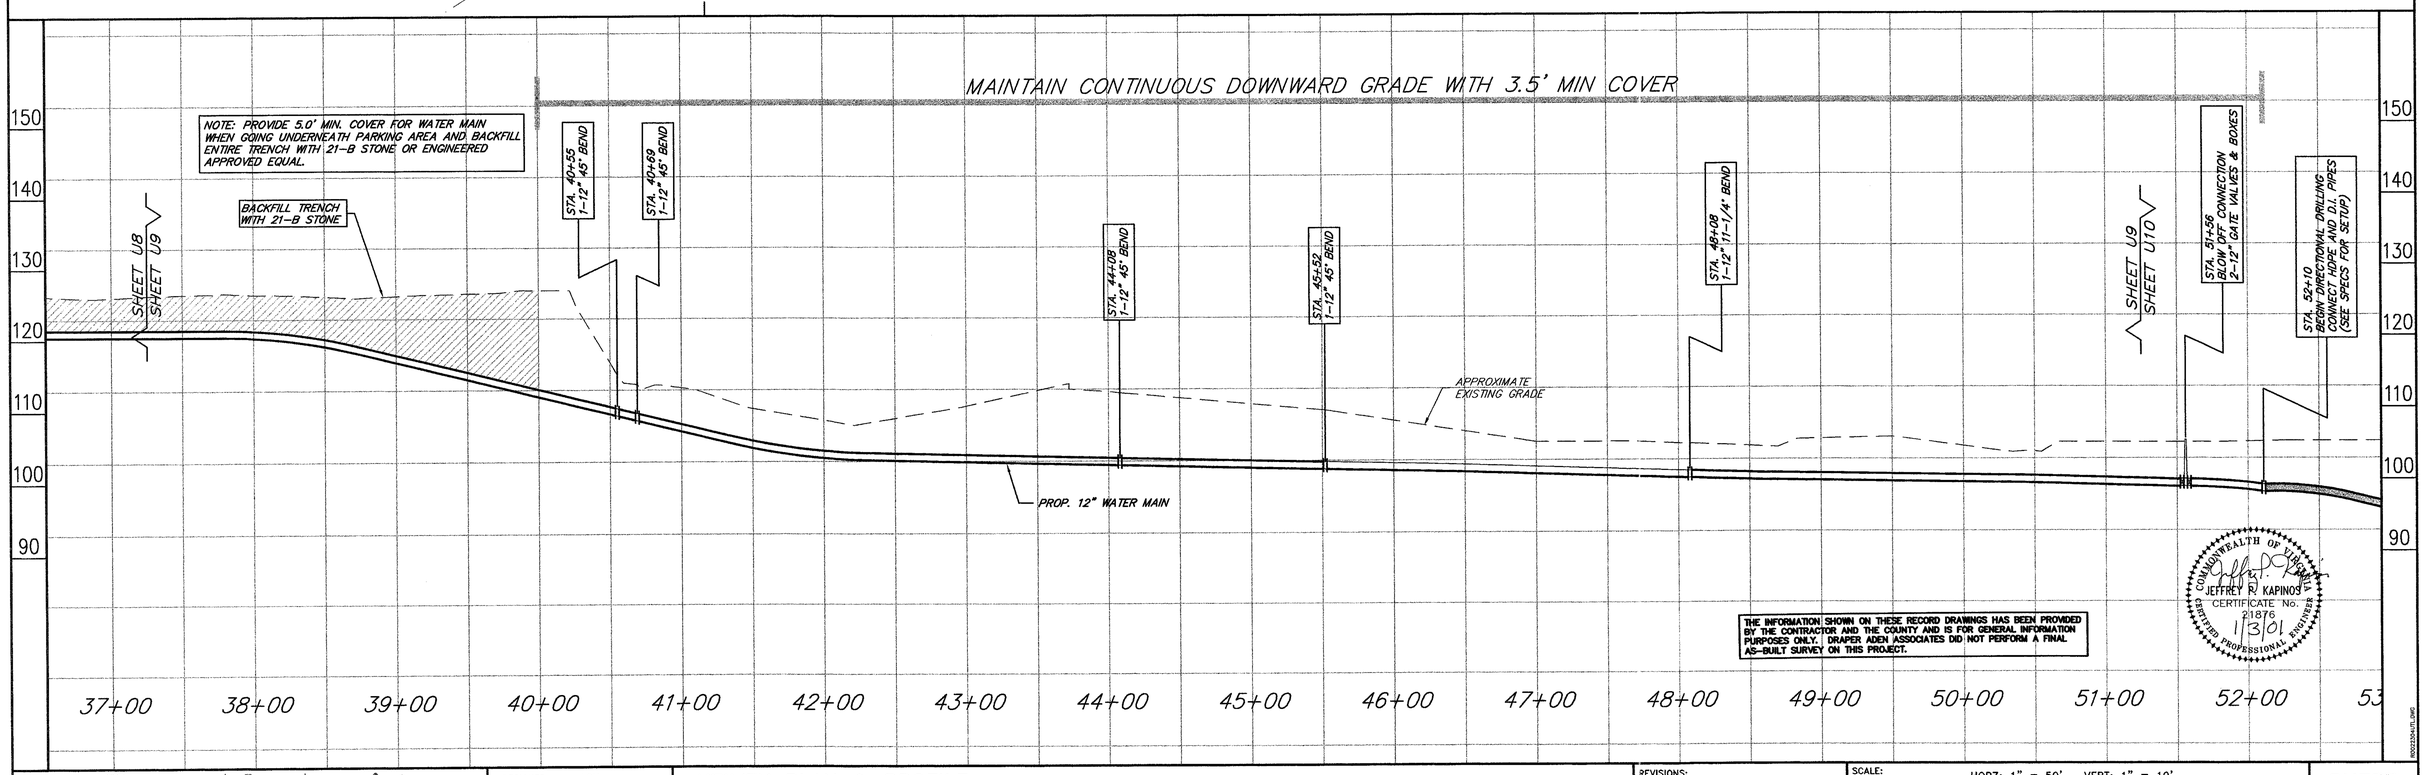

COMMONWEALTH OF VIRGINIA
JEFFREY R. KAPINOS
CERTIFICATE No. 21876
1/3/01
CERTIFIED PROFESSIONAL ENGINEER

THE INFORMATION SHOWN ON THESE RECORD DRAWINGS HAS BEEN PROVIDED BY THE CONTRACTOR AND THE COUNTY AND IS FOR GENERAL INFORMATION PURPOSES ONLY. DRAPER ADEN ASSOCIATES DID NOT PERFORM A FINAL AS-BUILT SURVEY ON THIS PROJECT.

R00223A4-TL.DWG

Draper Aden Associates
Blacksburg • Richmond, Virginia
Engineering • Surveying • Environmental Services

DESIGNED:	AQN
DRAWN:	AQN
CHECKED:	JPK
DATE:	9-15-00

UTILITY PLAN & PROFILE
SOUTHPOINT BUSINESS PARK UTILITY EXTENSION
PRINCE GEORGE COUNTY, VIRGINIA

REVISIONS:
12/10/00 – REVISED ALIGNMENT BETWEEN STA 44+00 AND 61+64

SCALE: HORZ: 1" = 50' VERT: 1" = 10'

PLAN NO. R00223-04F

SHEET U9