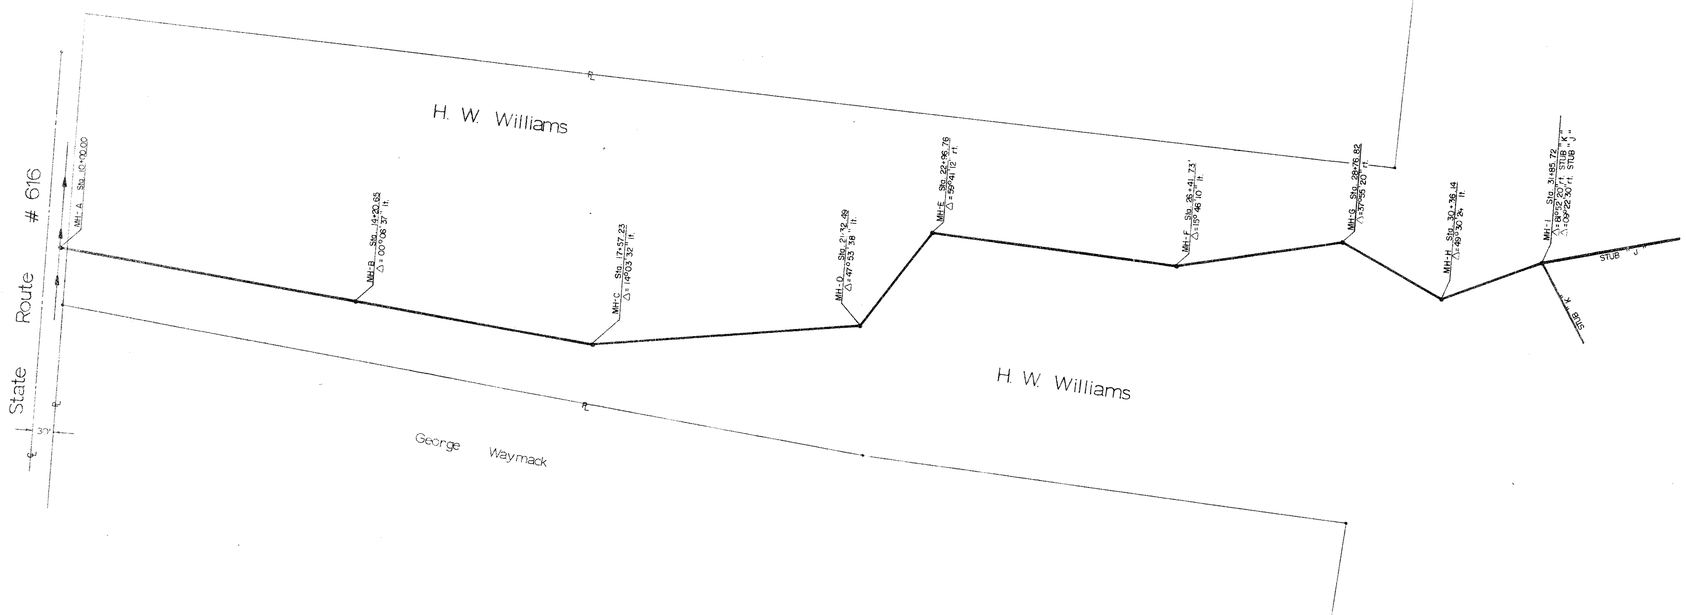

SCALE: PLAN: 1" = 100'
PROFILE: HORIZONTAL: 1" = 100'
VERTICAL: 1" = 10'

NOTE: ALL PIPE IS 8" ASB, CLASS 3300, PIPE BEDDING COMPOSED OF 4" OF #5 CRUSHED STONE.

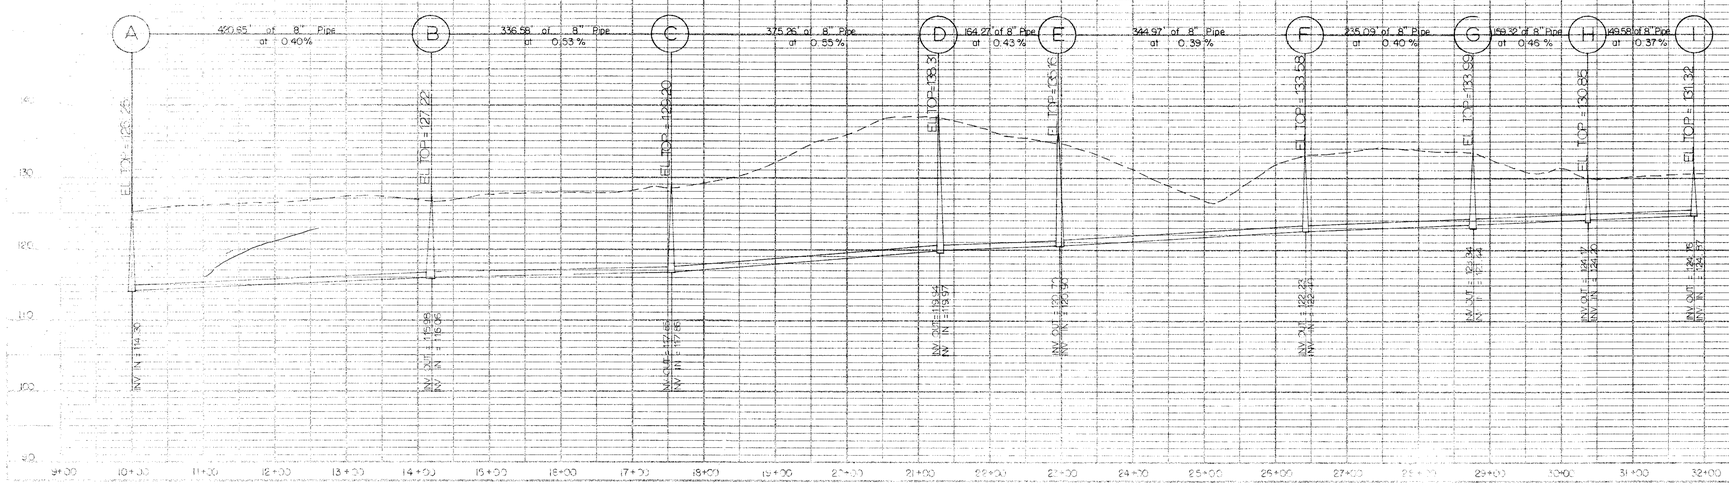

~~This is the line from Laurel Spring & To whispering winds Mobile Home Park~~
~~SEE PAGE 11 OF 13, UNDER BLANKWATER & Collection System~~

AS BUILT PLAN OF SANITARY SEWER LINES ACROSS THE PROPERTY OF H. W. WILLIAMS

SCALE: AS SHOWN	APPROVED BY:	DRAWN BY: RJM / WWV
DATE: 1/4/78		REVISED:

BLAND DISTRICT
PRINCE GEORGE COUNTY, VIRGINIA

CHARLES C. TOWNES & ASSOCIATES
CIVIL ENGINEERS, PLANNERS, LAND SURVEYORS
COLONIAL HEIGHTS, VIRGINIA

DRAWING NUMBER: 780304