Force Main is not as shown on this plan. It is actually located 3.5 feet off of C & P pole and 12.5 feet off the E/P as it existed on October 10, 1990.
C&P Pole removed 2/19/91

There are plan on widening this road in Spring of 1991 and at that time the pole will be removed and these dimensions will no longer be any good.

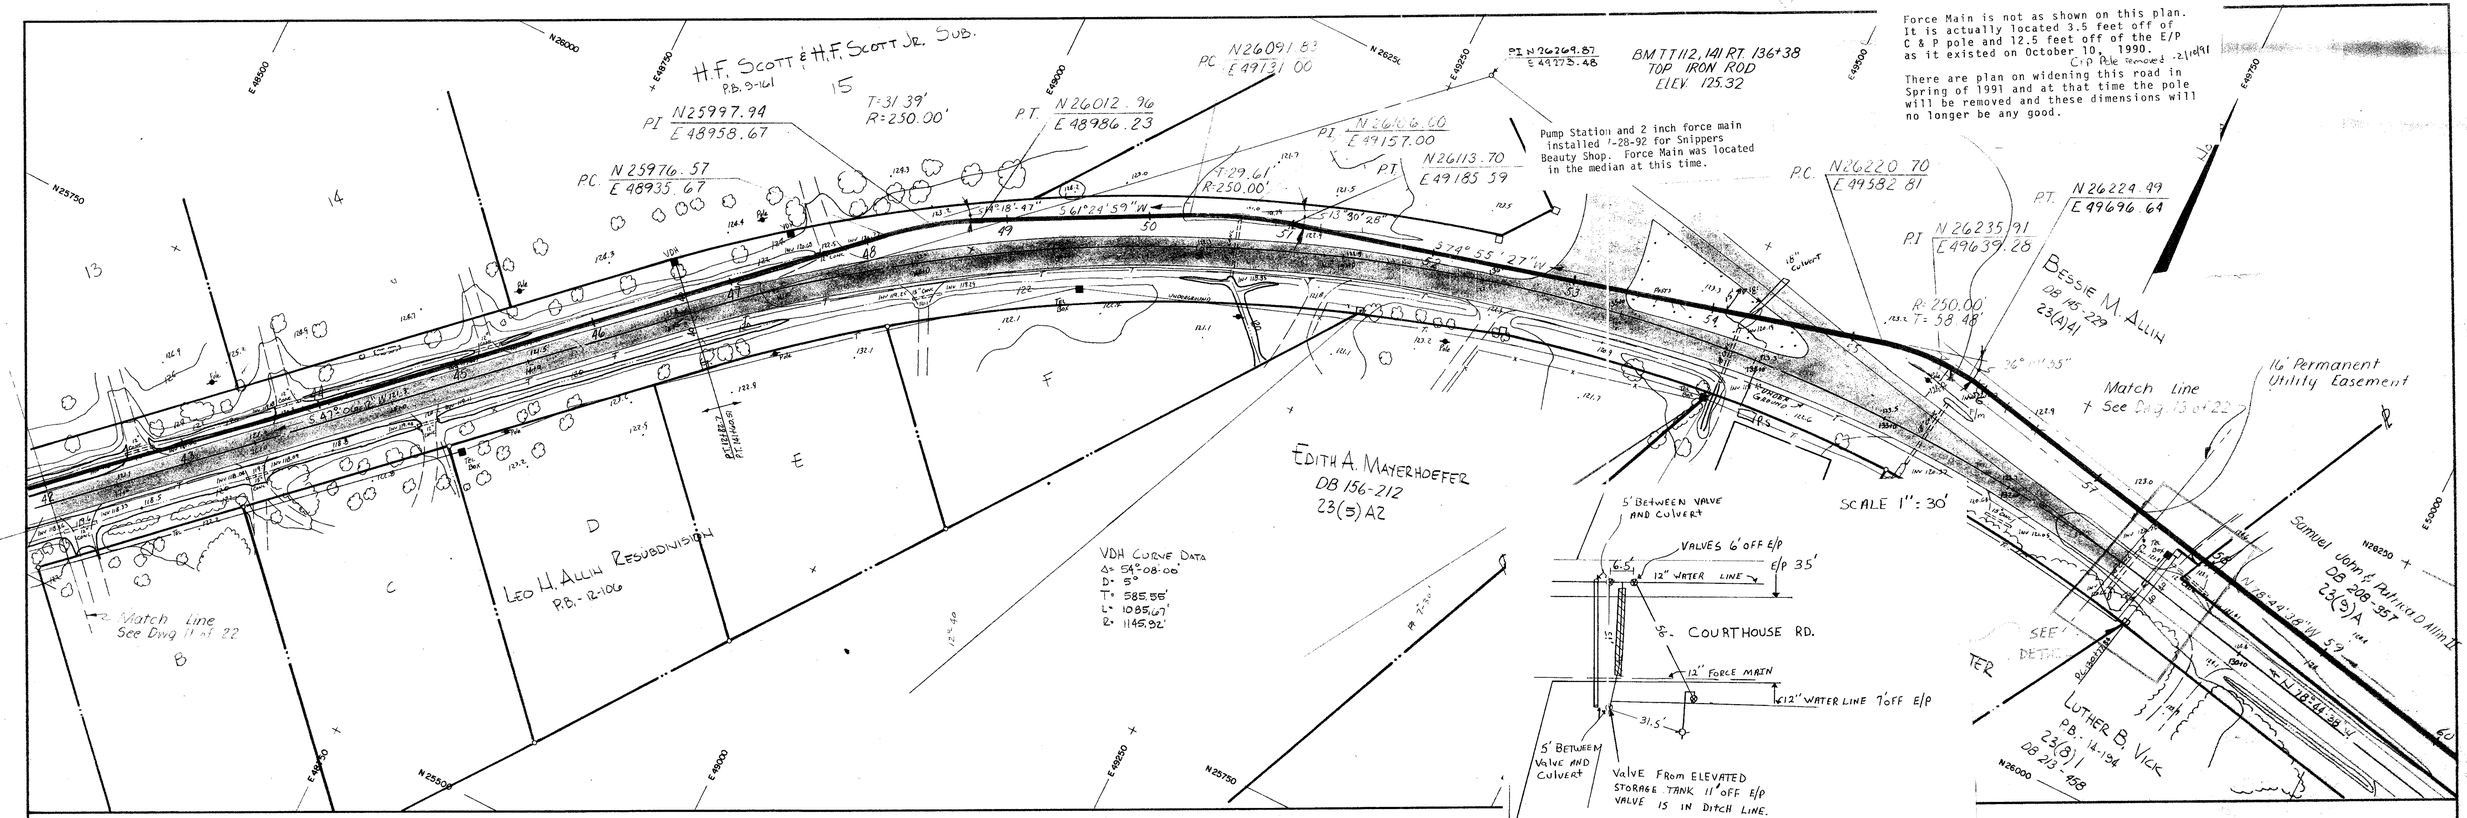

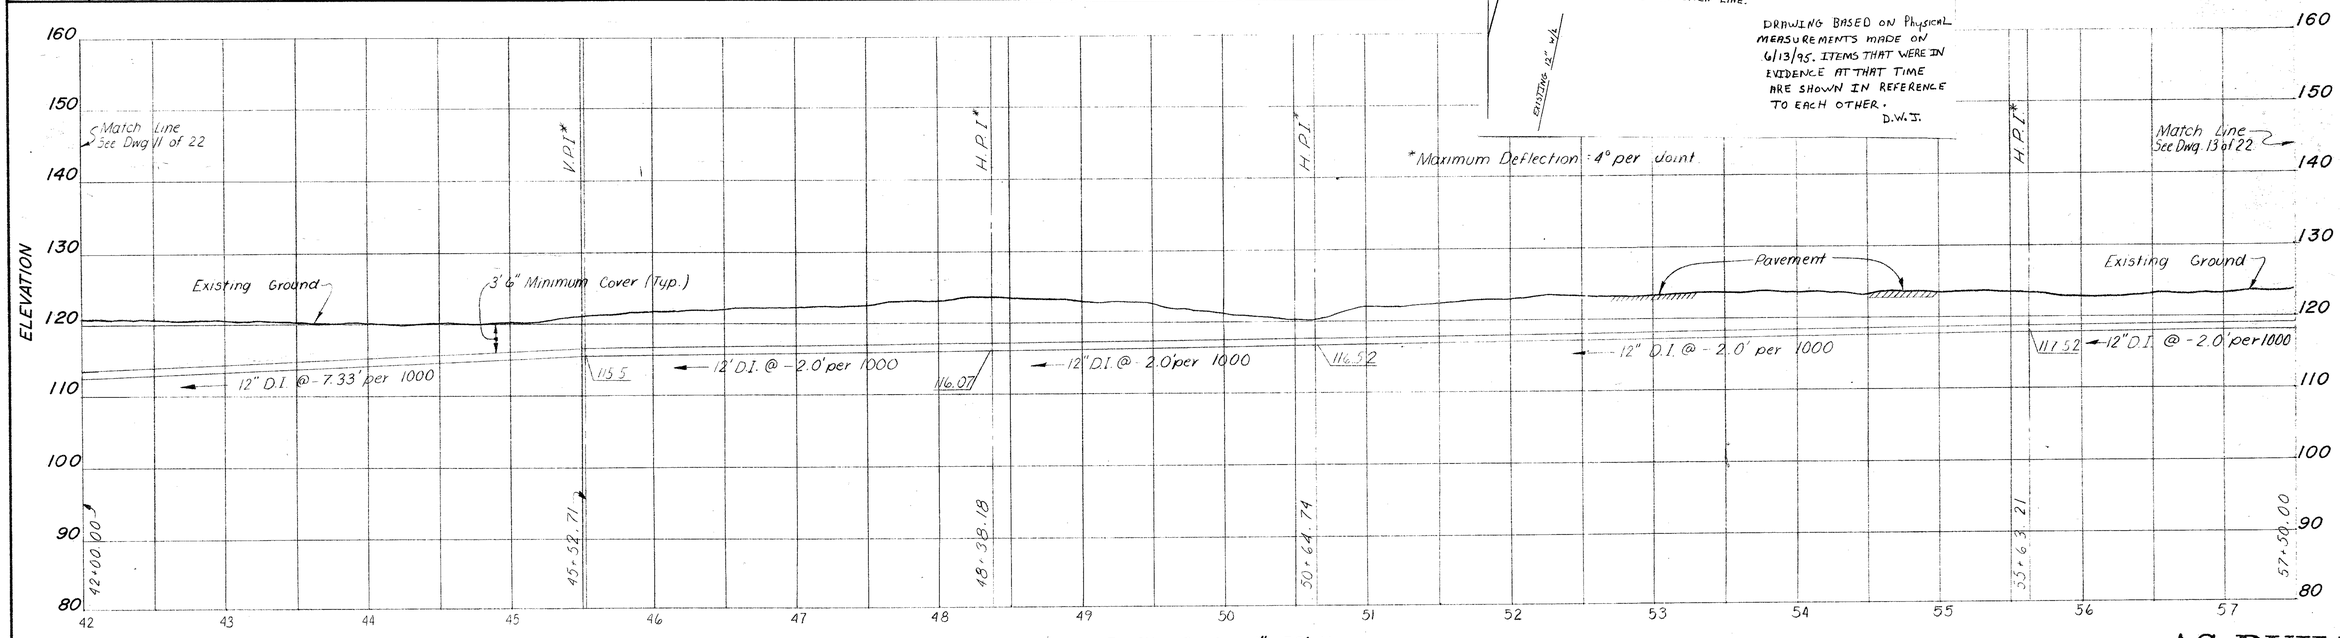

Profile Scale: 1" = 50' Horz.
1" = 10' Vert.

Note All Force Main Elevations Are Invert

AS BUILT

PRITCHARD AND ALTMAN
Engineers and Surveyors
Hopewell, Virginia

NO.	DATE	APPR.	REVISION	NO.	DATE	APPR.	REVISION

COMMONWEALTH OF VIRGINIA
JOHN L. COMBS
CERTIFICATE No. 6442
CERTIFIED PROFESSIONAL ENGINEER

CHECKED	WHP	8-76
DES. ENG.	JLH	8-76
PROJ. ENG.	JLC	8-76
PROJ. MGR.	RPR	8-76
APPROVED	JLC	8-76
APPROVED		

SUB-1 Contract-1
PRINCE GEORGE COUNTY, VIRGINIA
UPPER BLACKWATER WASTEWATER COLLECTION SYSTEM
Route 106 Force Main Sta. 42+00.00 to Sta. 57+50.00

ROY F. WESTON
ENVIRONMENTAL SCIENTISTS AND ENGINEERS
LEWIS LANE • WEST CHESTER • PENNSYLVANIA • 19380

PREPARED BY	DATE	SCALE	W. O. NO.	DWG. NO.
VIRGINIA OFFICE				12 of 22
DRAWN RLM	8-76	As Noted	1535-01	

SHEET NO.