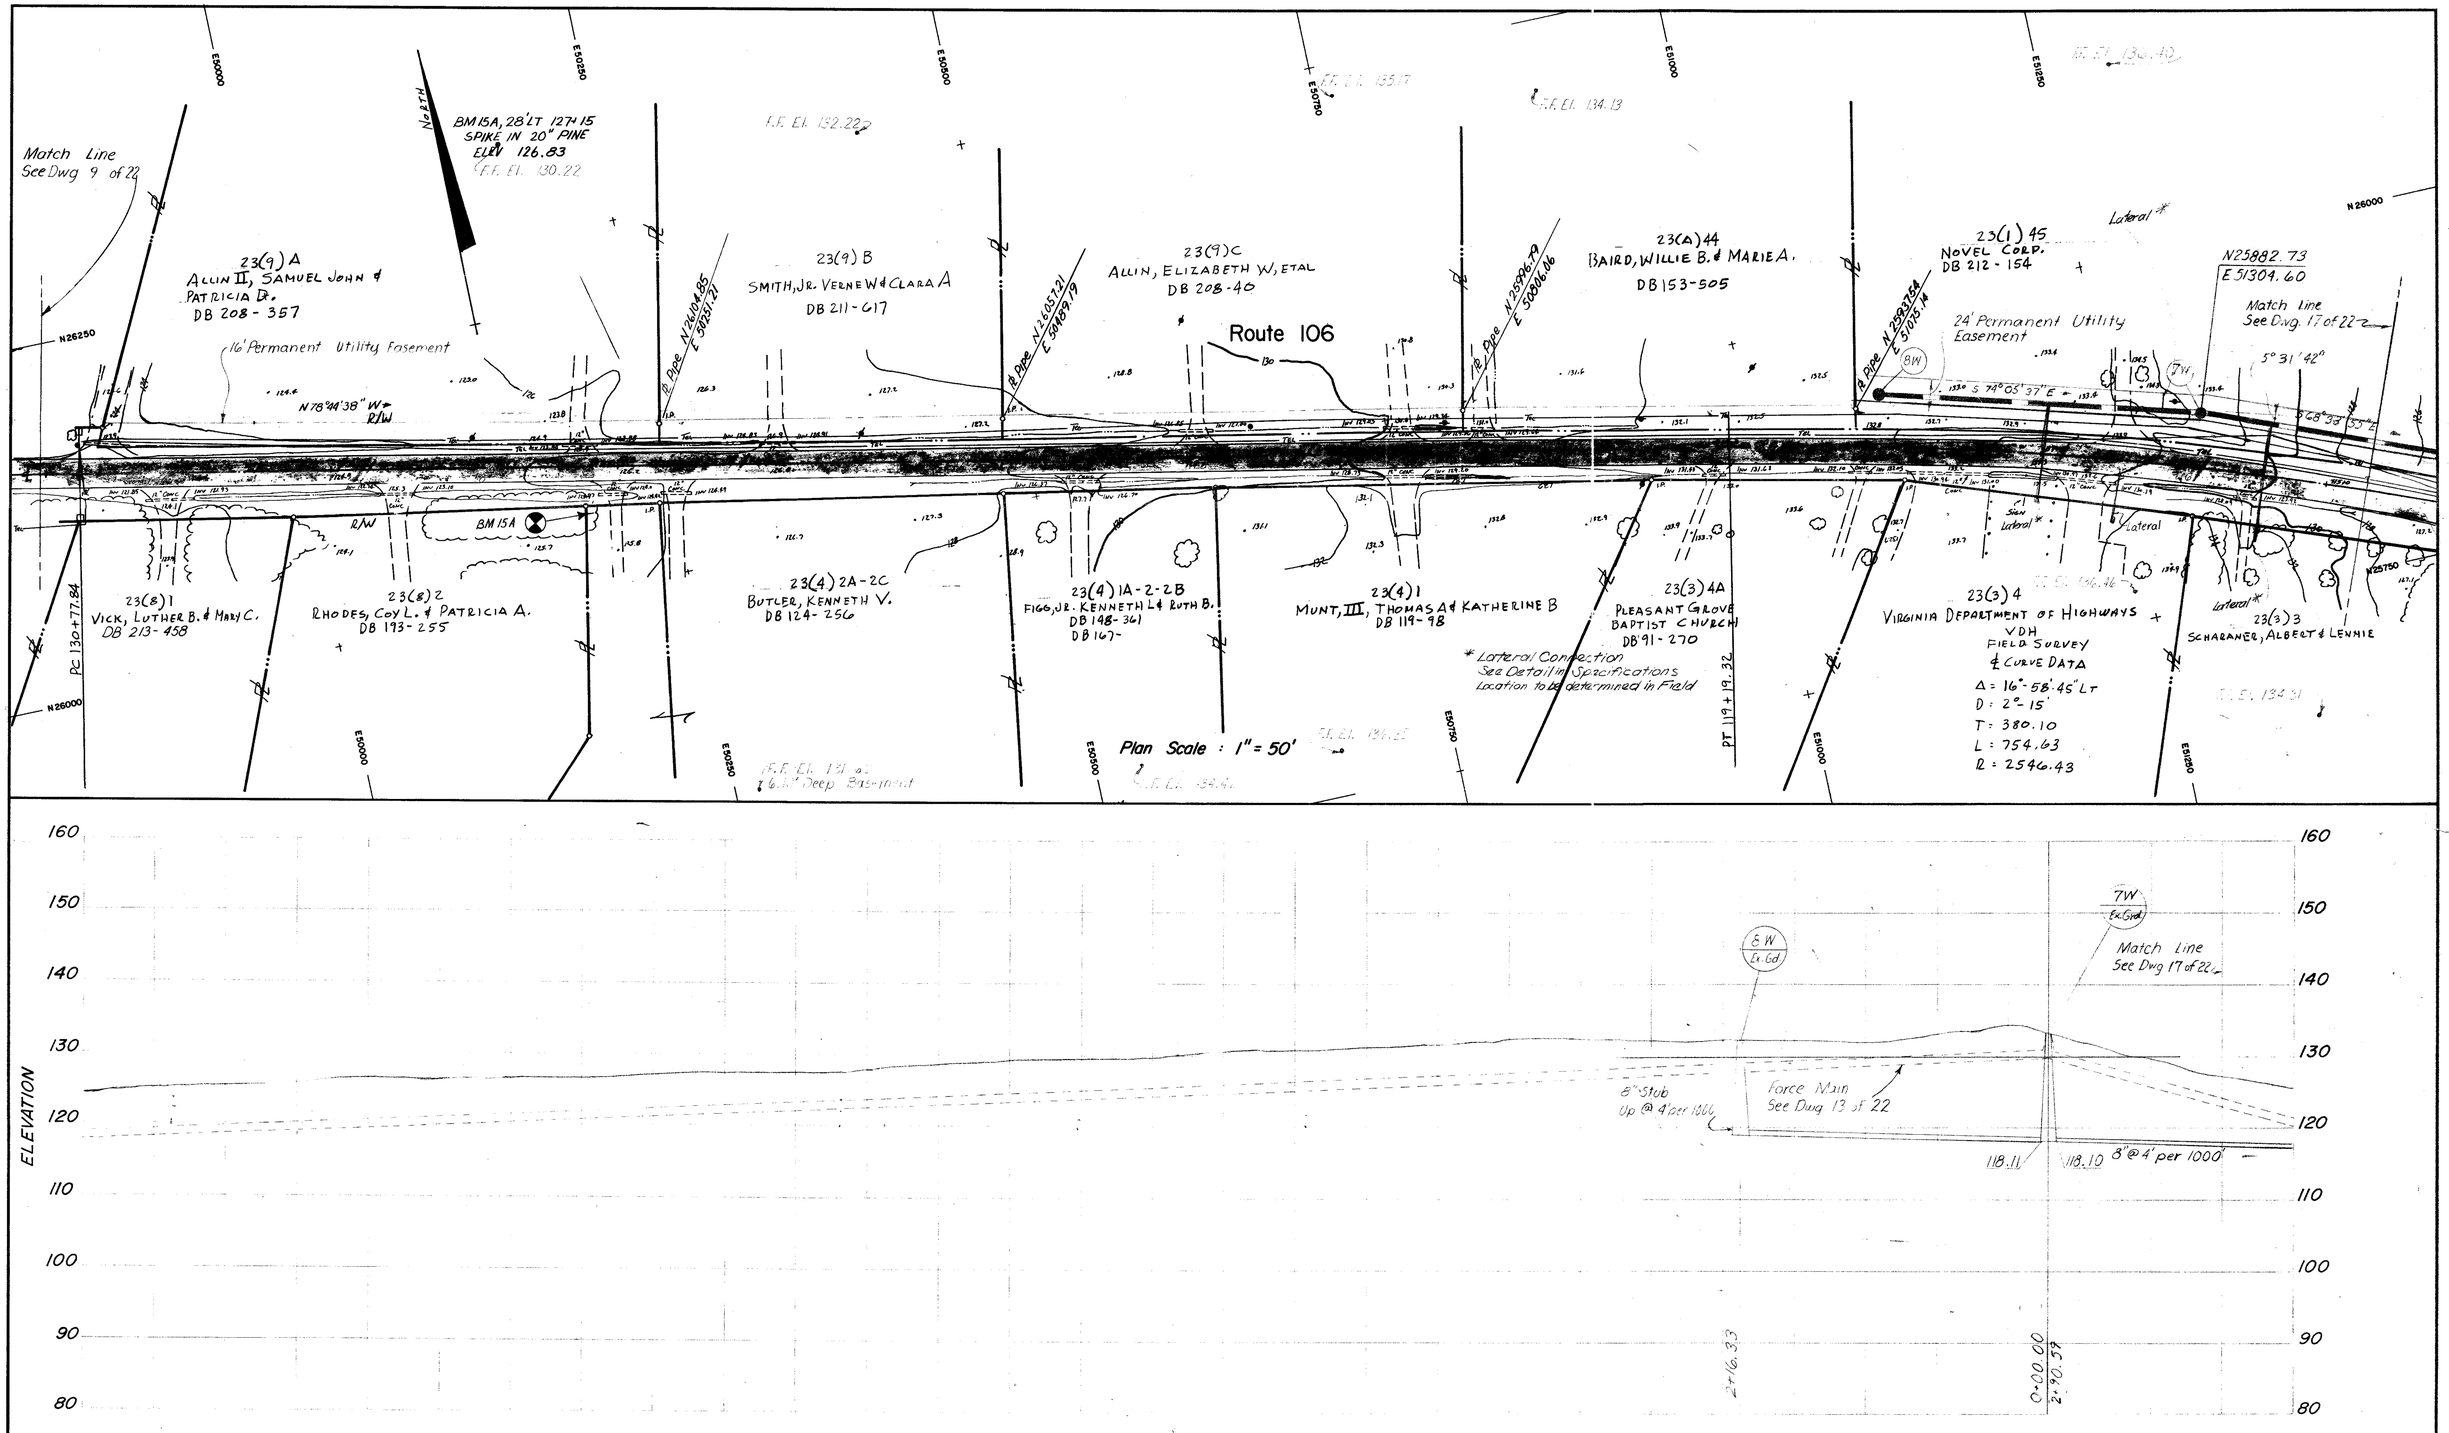

PRITCHARD AND ALTMAN REV. 6-18-76
Engineers and Surveyors
Hopewell, Virginia

Profile Scale: 1" = 50' Horz.
1" = 10 Vert.

AS BUILT

NO.	DATE	APPR.	REVISION	NO.	DATE	APPR.	REVISION
1	2-23-77		Revised Gravity Sewer				

COMMONWEALTH OF VIRGINIA
JOHN L. COMBS
CERTIFICATE No. 6442
REGISTERED PROFESSIONAL ENGINEER

CHECKED	WHP	DATE 8-76
DES. ENG.	JLH	8-76
PROJ. ENG.	JLC	8-76
PROJ. MGR.	CPR	8-76
APPROVED	JLC	8-76
APPROVED		

SUB-1 Contract-1
PRINCE GEORGE COUNTY, VIRGINIA
UPPER BLACKWATER WASTEWATER COLLECTION SYSTEM
Route 106 Sanitary Sewer M.H. 11 W - 7W

ROY F. WESTON
ENVIRONMENTAL SCIENTISTS AND ENGINEERS
LEWIS LANE ▪ WEST CHESTER ▪ PENNSYLVANIA ▪ 19380

PREPARED BY				DWG. NO.
VIRGINIA OFFICE				16 of 22
DRAWN	DATE	SCALE	W. O. NO.	
RLM	8-76	As Noted	1535-01	

N3259

SHEET NO.