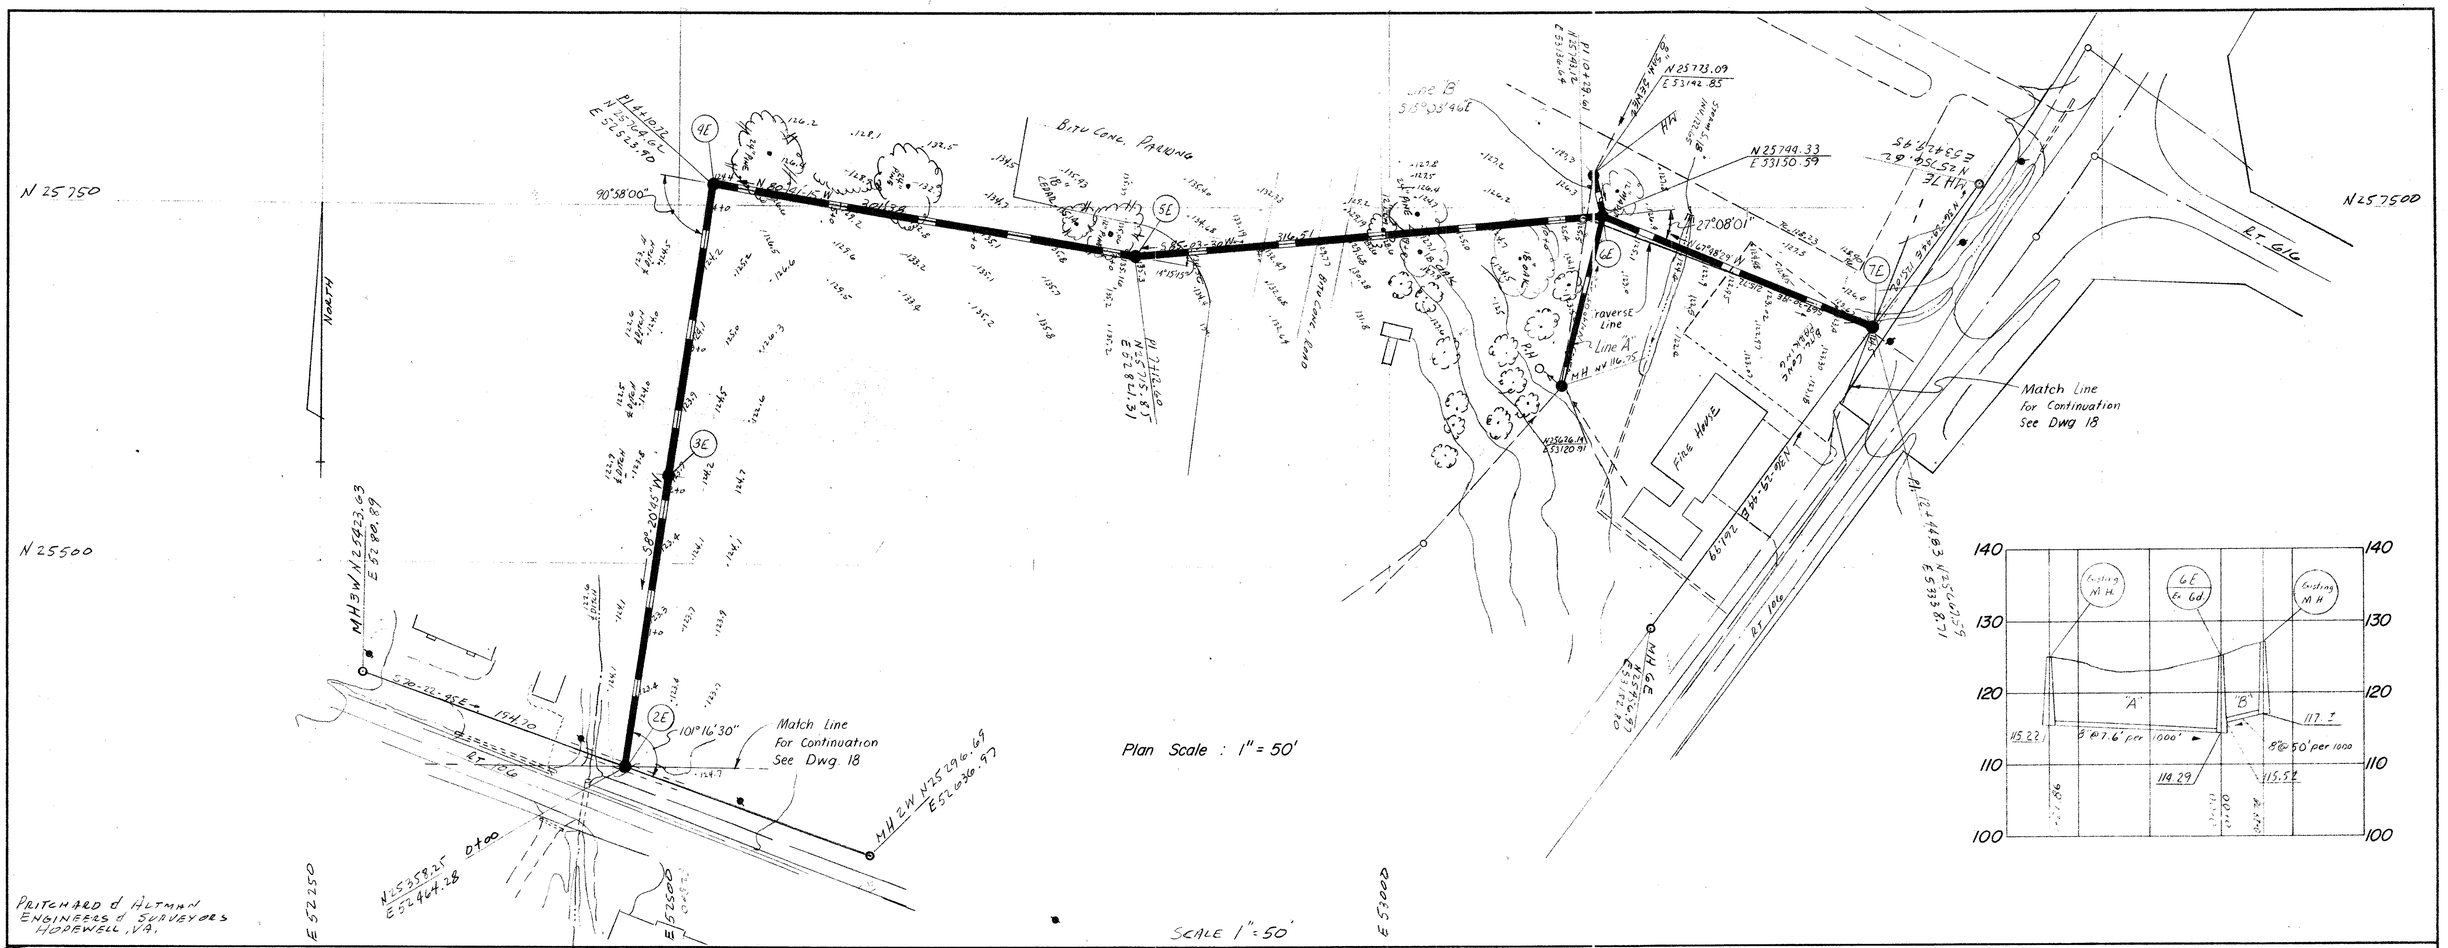

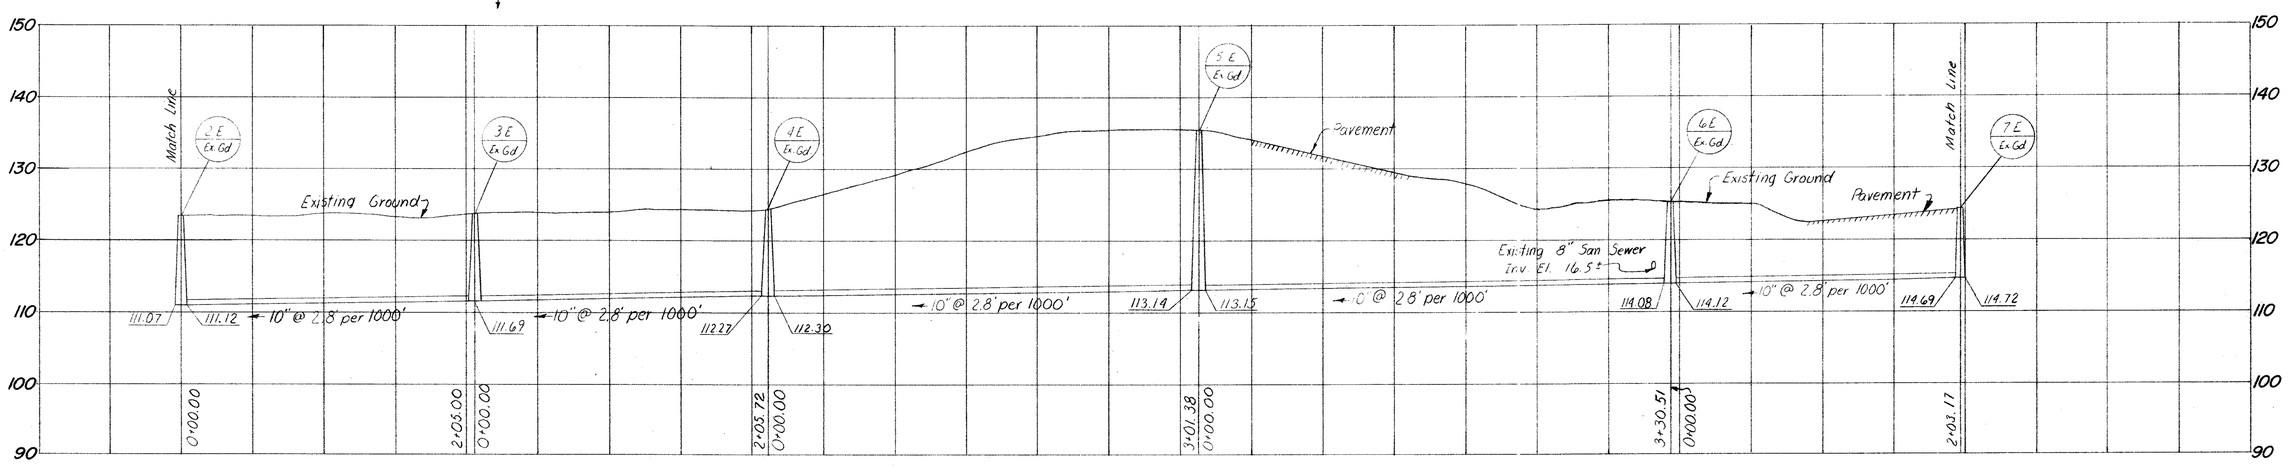

Profile Scale : 1" = 50' Horz.
1" = 10' Vert.

AS BUILT

PRITCHARD AND ALTMAN
Engineers and Surveyors
Hopewell, Virginia

NO.	DATE	APPR.	REVISION	NO.	DATE	APPR.	REVISION
1	2/23		This Sheet Added To Contract				

COMMONWEALTH OF VIRGINIA
JOHN L. COMBS
CERTIFICATE No. 5442
REGISTERED PROFESSIONAL ENGINEER

		DATE
CHECKED	WHP	2-77
DES. ENG.	JLH	2-77
PROJ. ENG.	JLC	2-77
PROJ. MGR.	RPR	2-77
APPROVED	JLC	2-77
APPROVED	[illegible]	5-23-77

SUB-1 Contract-1
PRINCE GEORGE COUNTY, VIRGINIA
UPPER BLACKWATER WASTEWATER COLLECTION SYSTEM
Route 106 Sanitary Sewer M.H. 2E - 7E

ROY F. WESTON
ENVIRONMENTAL SCIENTISTS AND ENGINEERS
LEWIS LANE • WEST CHESTER • PENNSYLVANIA • 19380

PREPARED BY				DWG. NO.
VIRGINIA OFFICE				17A of 22
DRAWN RLM	DATE 2-77	SCALE As Noted	W. O. NO. 1535-01	

SHEET NO.