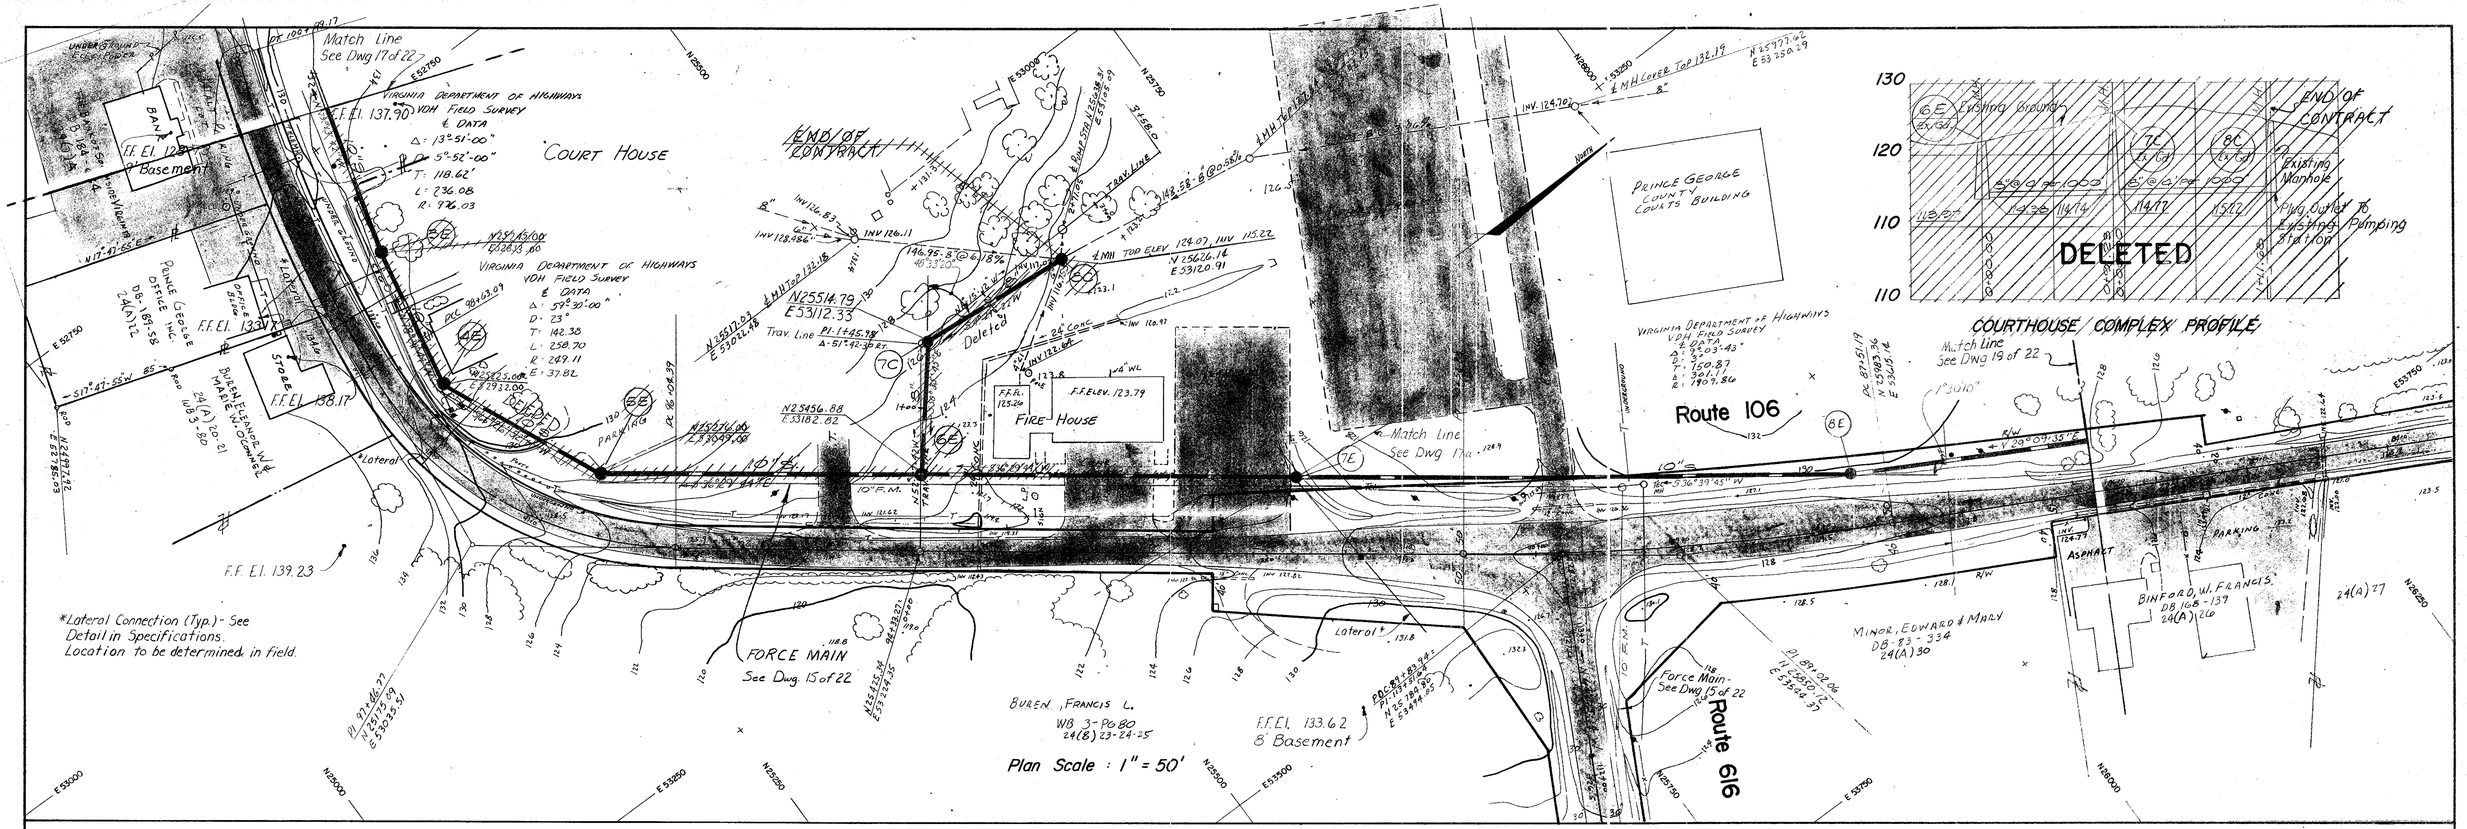

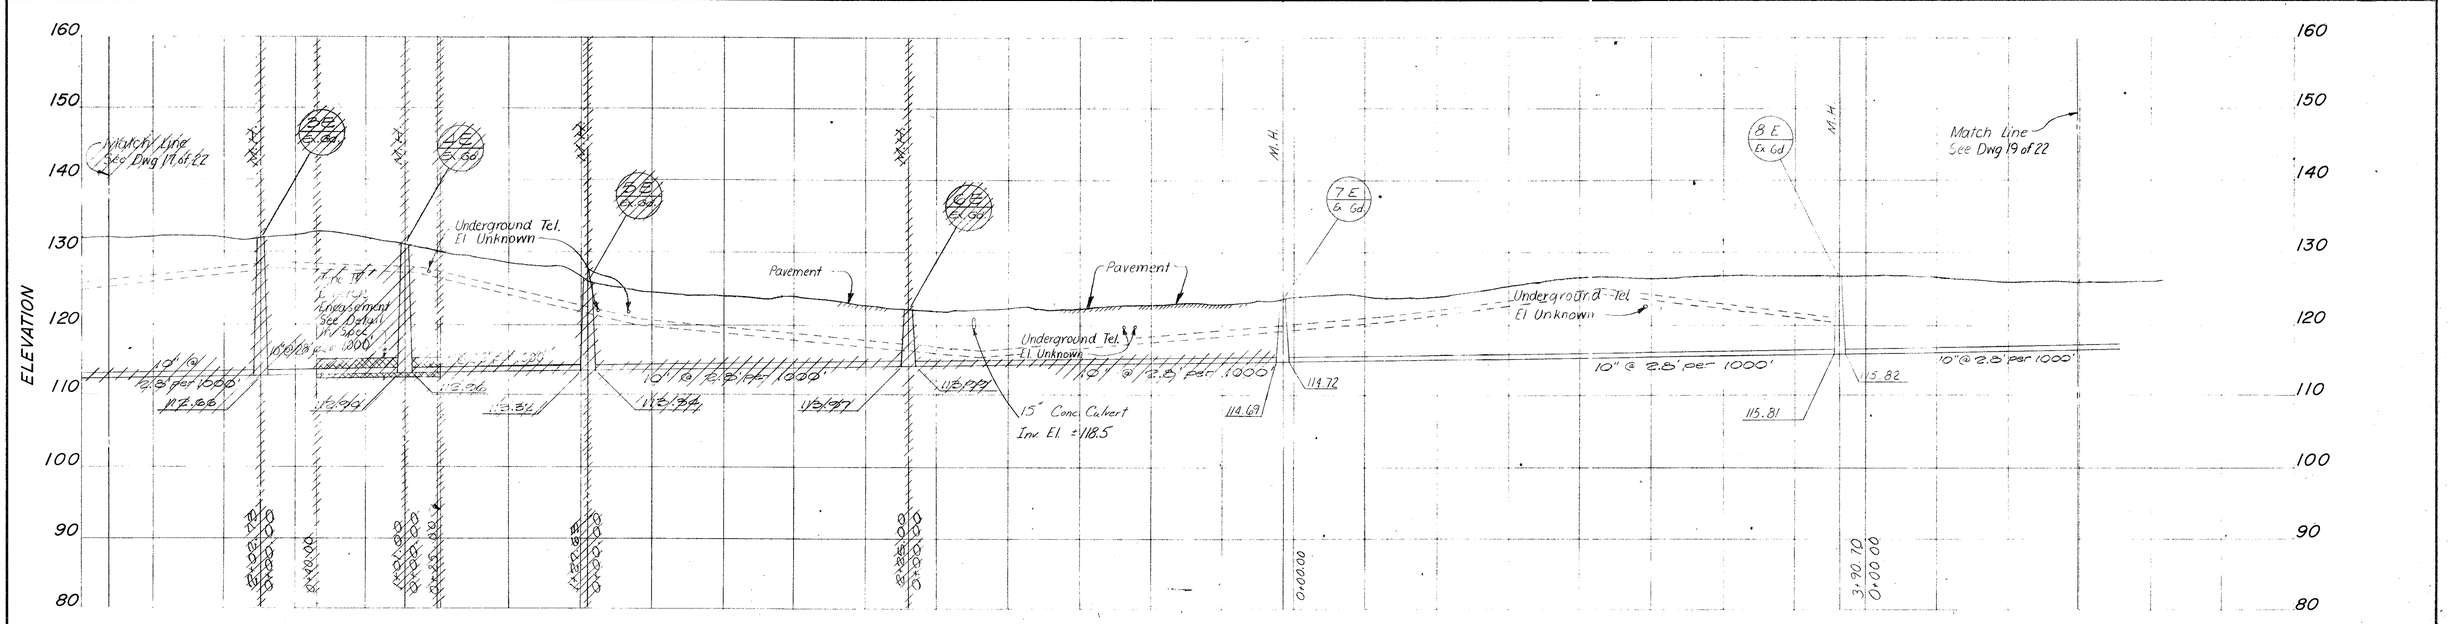

AS BUILT

PRITCHARD AND ALTMAN REV. 6-18-76
Engineers and Surveyors
Hopewell, Virginia

No.	Date	Appr.	Revision	No.	Date	Appr.	Revision
1	11-15-76		Relocate 10"S.				
2	12-17-76		Added Concrete Encasement Vicinity M.H. 4-E				
3	1-18-77		Added Coordinates to Manholes				
4	1-18-77		Added Bearings to 10" Sanitary Sewer				
5	2-23-77		Revised Gravity Sewer				

Commonwealth of Virginia — John L. Combs, Certificate No. 6442, Certified Professional Engineer

Checked	WHP	8-76
Des. Eng.	JLH	8-76
Proj. Eng.	JLC	8-76
Proj. Mgr.	RPR	8-76
Approved	JLC	8-76
Approved		

SUB-1 Contract-1
PRINCE GEORGE COUNTY, VIRGINIA
UPPER BLACKWATER WASTEWATER COLLECTION SYSTEM
Beazley School Sanitary Sewer M.H. 3E - 8E & 7C - 8C

ROY F. WESTON
ENVIRONMENTAL SCIENTISTS AND ENGINEERS
LEWIS LANE • WEST CHESTER • PENNSYLVANIA • 19380

Prepared By	Date	Scale	W. O. No.	Dwg. No.
Virginia Office				18 of 22
Drawn RLM	8-76	As Noted	1755-01	

Sheet No.