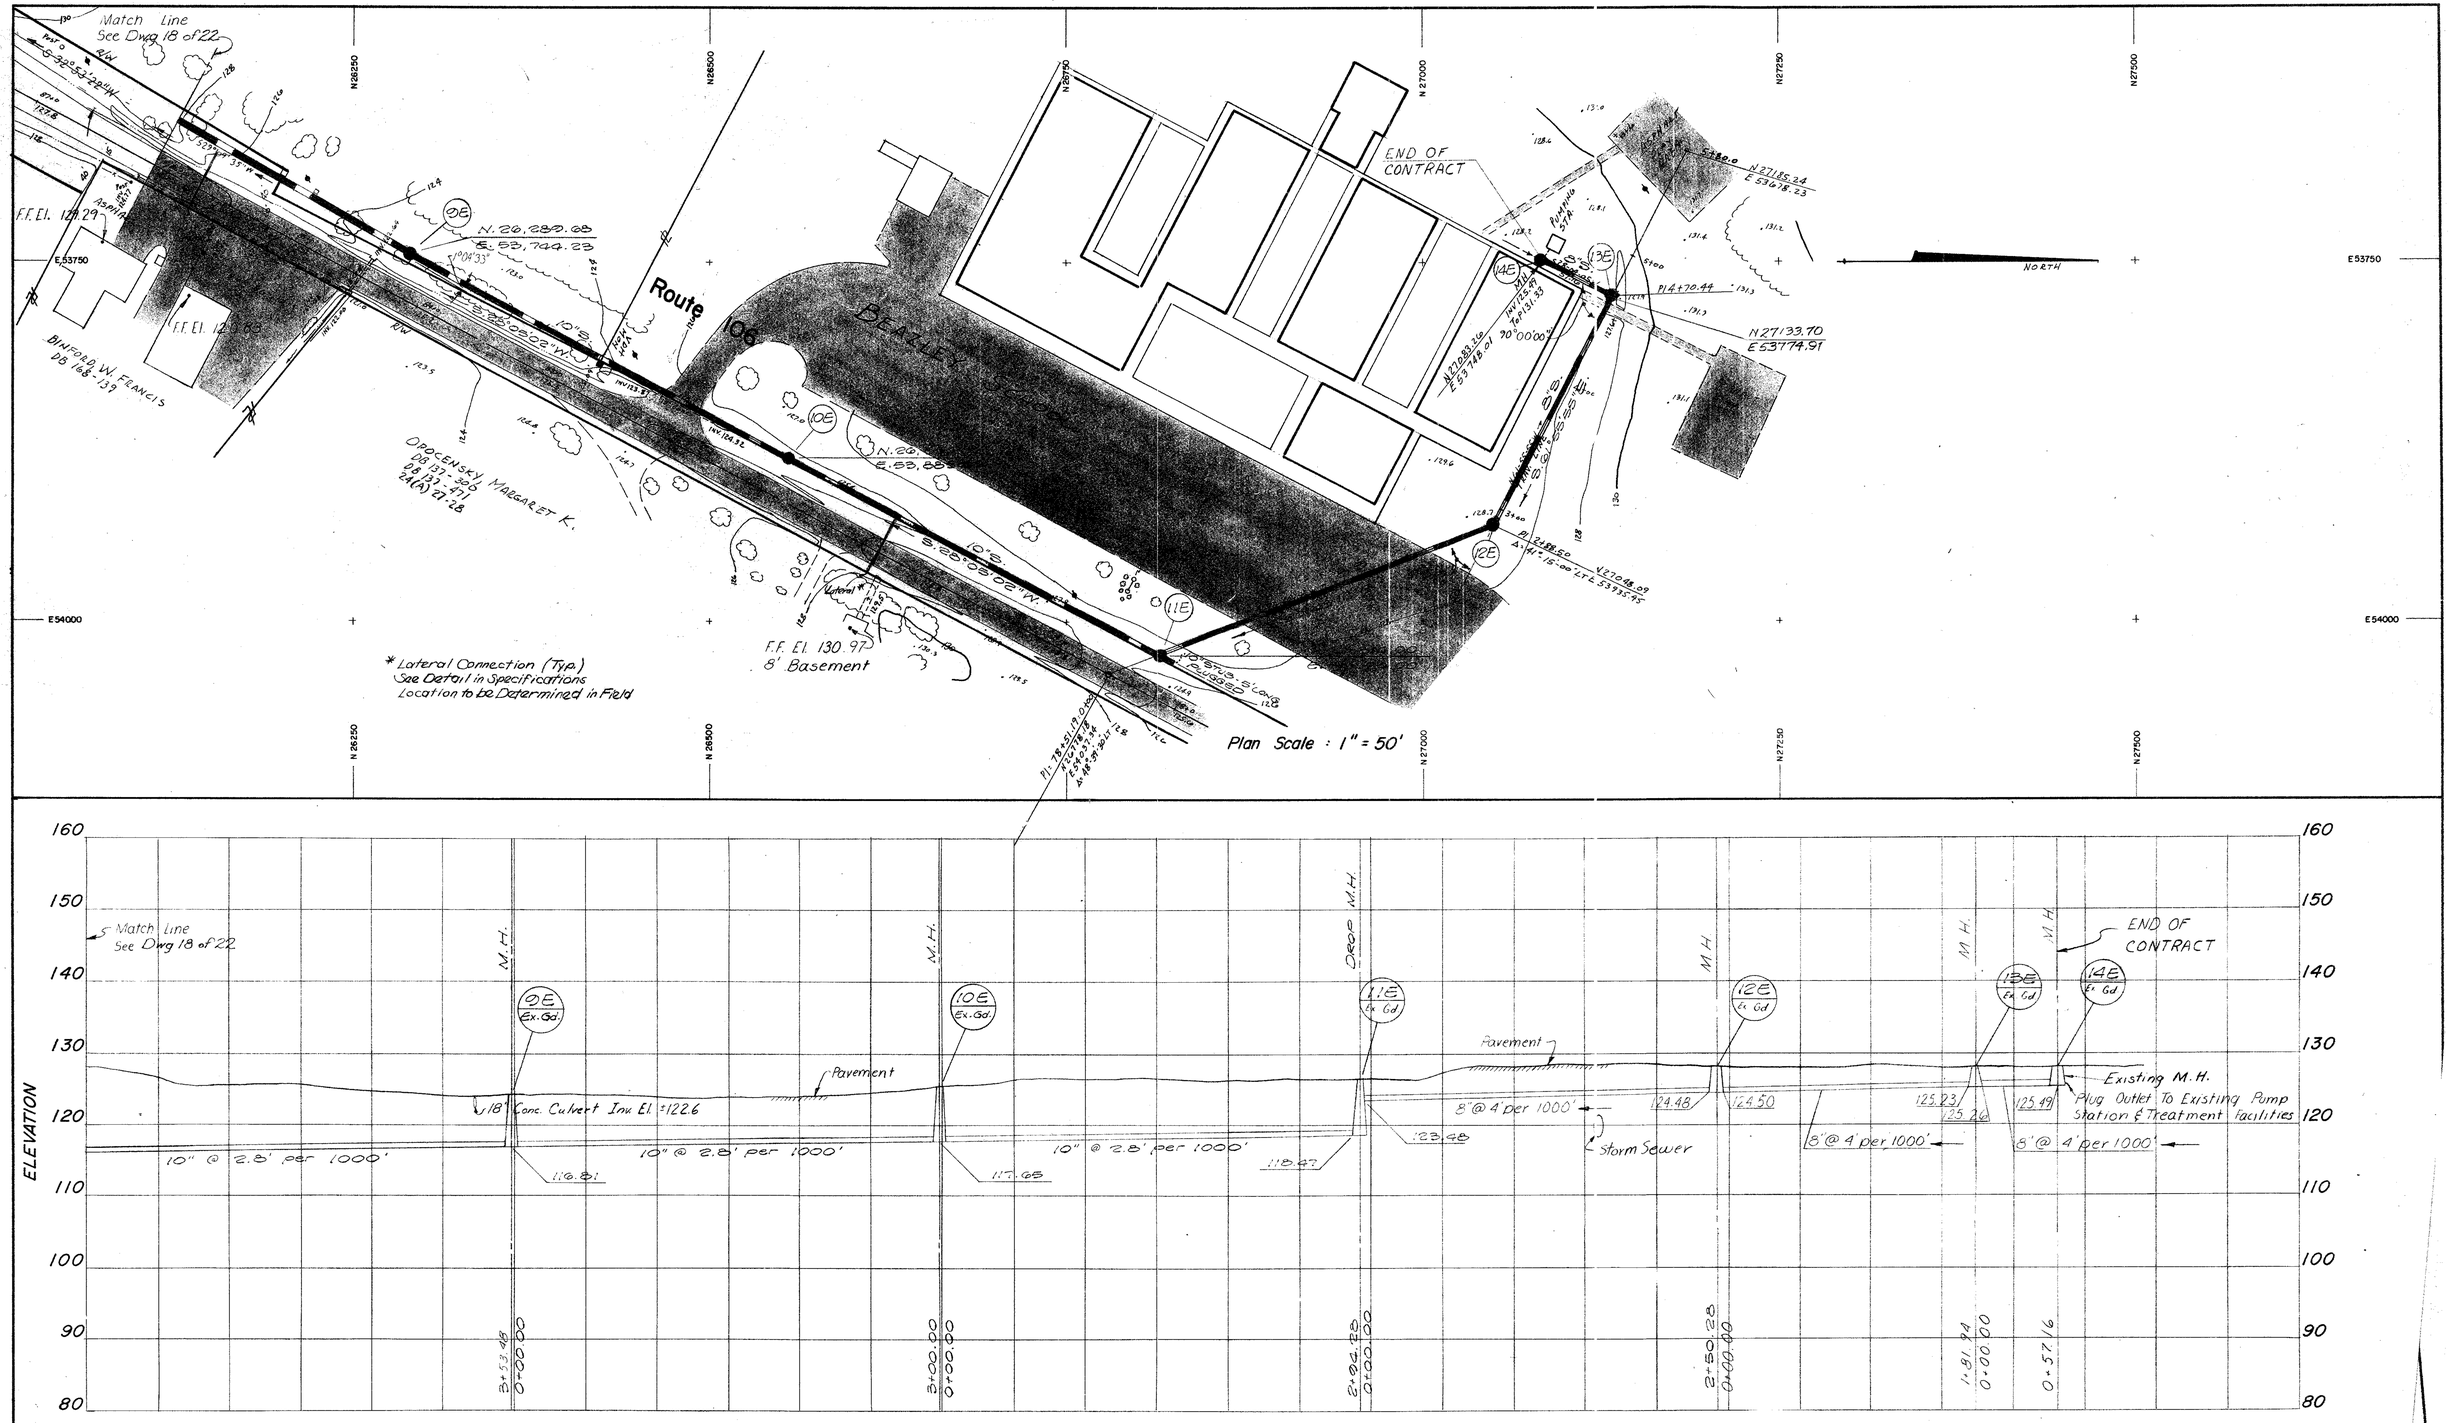

PRITCHARD AND ALTMAN REV. 6-18-76
Engineers and Surveyors
Hopewell, Virginia

AS BUILT

NO.	DATE	APPR.	REVISION	NO.	DATE	APPR.	REVISION
1	11-16-76		RELOCATE 10"S, ADD M.H.				
2	2-23-77		Revised Gravity Sewer				

COMMONWEALTH OF VIRGINIA
JOHN L. COMBS
CERTIFICATE No. 6442
REGISTERED PROFESSIONAL ENGINEER

CHECKED	WHP	8-76
DES. ENG.	JLH	8-76
PROJ. ENG.	JLC	8-76
PROJ. MGR.	RPR	8-76
APPROVED	JLC	8-76
APPROVED		

SUB-1 Contract-1
PRINCE GEORGE COUNTY, VIRGINIA
UPPER BLACKWATER WASTEWATER COLLECTION SYSTEM
Beazley School Sanitary Sewer M.H. 8E - 13E

ROY F. WESTON
ENVIRONMENTAL SCIENTISTS AND ENGINEERS
LEWIS LANE • WEST CHESTER • PENNSYLVANIA • 19380

PREPARED BY	DATE	SCALE	W. O. NO.	DWG. NO.
VIRGINIA OFFICE				19 of 22
DRAWN RLM	8-76	As Noted	1535-01	

SHEET NO.