# SUB-1 CONTRACT-1

# PRINCE GEORGE COUNTY, VIRGINIA

## CONSTRUCTION OF

# UPPER BLACKWATER WASTEWATER

# COLLECTION SYSTEM




VICINITY MAP

DRAWING INDEX

| DWG. NO. | TITLE |
|---|---|
| 1 | Title Sheet (Vicinity Map & Project Location Map) |
| 2 | Blackwater San. Sewer M.H. 1-4 |
| 3 | Blackwater San. Sewer M.H. 4-7 |
| 4 | Blackwater San. Sewer M.H. 8-12 |
| 5 | Blackwater San. Sewer M.H. 12-18 |
| 6 | Blackwater San. Sewer M.H. 19-22 |
| 7 | Blackwater San. Sewer M.H. 22-26 |
| 8 | Blackwater San. Sewer M.H. 26-27 |
| 9 | Rt. 106 F.M. Sta. 0+00.00 to 12+00.00 |
| 10 | Rt. 106 F.M. Sta. 12+00.00 to 27+00.00 |
| 11 | Rt. 106 F.M. Sta. 27+00.00 to 42+00.00 |
| 12 | Rt. 106 F.M. Sta. 42+00.00 to 57+50.00 |
| 13 | Rt. 106 F.M. Sta. 57+50.00 to 72+75.00 |
| 14 | Rt. 106 F.M. Sta. 72+75.00 to 88+00.00 |
| 15 | Rt. 106 F.M. Sta. 88+00.00 to 100+82.50 |
| 16 | Rt. 106 San. Sewer M.H. 11W-7W |
| 17 | Rt. 106 San. Sewer M.H. 6W-2E |
| 18 | Beazley Sch. San. Sewer M.H. 3E-8E & 7C-8C |
| 19 | Beazley Sch. San. Sewer M.H. 8E-13E |
| 20 | Rt. 106 San. Sewer M.H. 2 (Bank Area) |
| 21 | Walton Sch. San. Sewer M.H. 3-7N |
| 22 | Walton Sch. San. Sewer M.H. 8N-M.H.5 (Existing) |

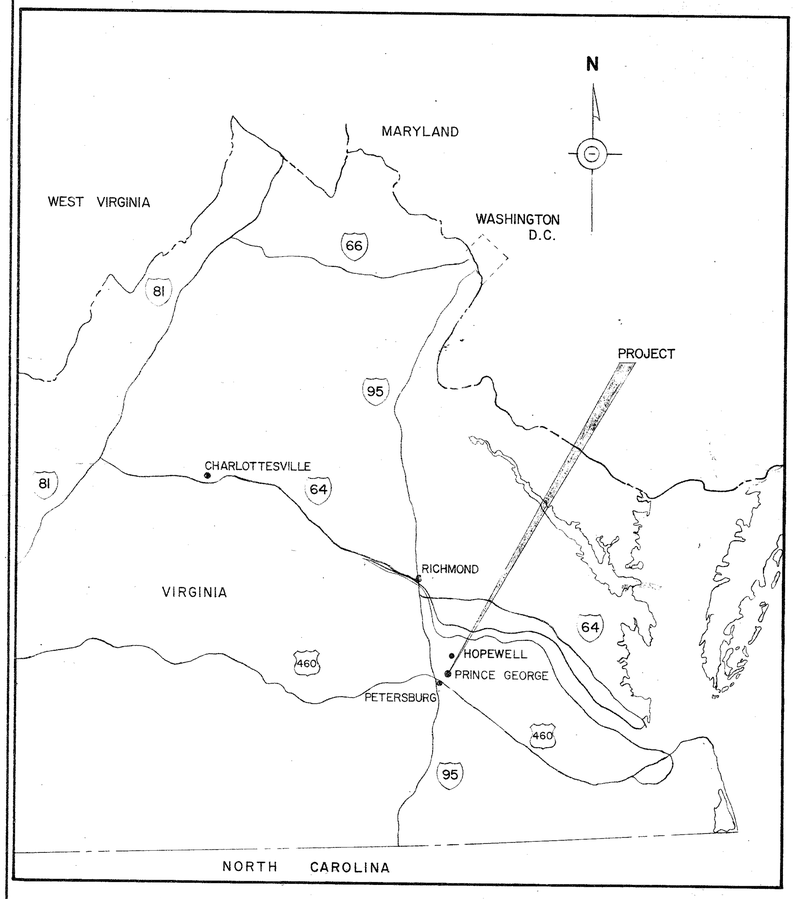


PROJECT LOCATION MAP

**AS BUILT**

Note: Datum is Mean Sea Level

| NO. | DATE | APPR. | REVISION | NO. | DATE | APPR. | REVISION |
|---|---|---|---|---|---|---|---|
| | 1-18-77 | | Latest Revisions | | | | |
| | 2-23-77 | | Latest Revisions | | | | |
| | | | | | | | |
| | | | | | | | |
| | | | | | | | |

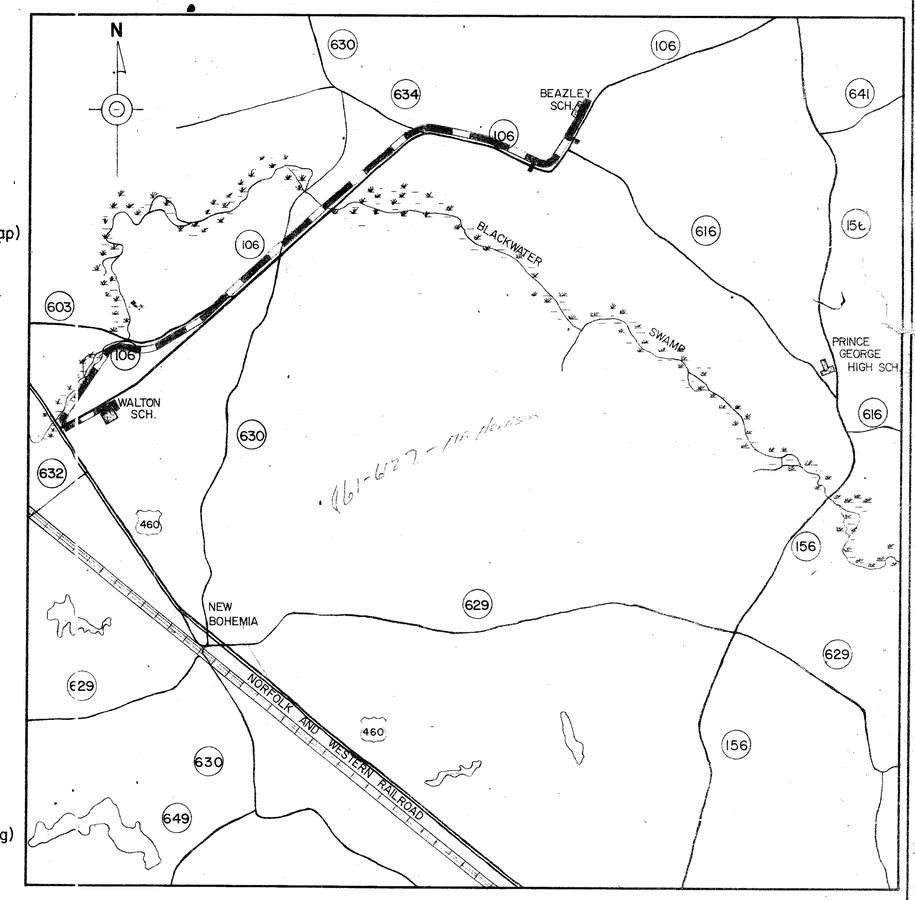COMMONWEALTH OF VIRGINIA
JOHN L. COMBS
CERTIFICATE No. 6662

| | | |
|---|---|---|
| CHECKED | WHP | DATE 8-76 |
| DES. ENG. | JLH | 8-76 |
| PROJ. ENG. | JLC | 8-76 |
| PROJ. MGR. | RPR | 8-76 |
| APPROVED | JLC | 8-76 |
| APPROVED | | |

ROY F. WESTON
ENVIRONMENTAL SCIENTISTS AND ENGINEERS
LEWIS LANE • WEST CHESTER • PENNSYLVANIA • 19380

PREPARED BY VIRGINIA OFFICE

| DRAWN | DATE | SCALE | W.O. NO. |
|---|---|---|---|
| RLM | 8-76 | As | 5-25-01 |

DWG. NO.

SHEET NO.