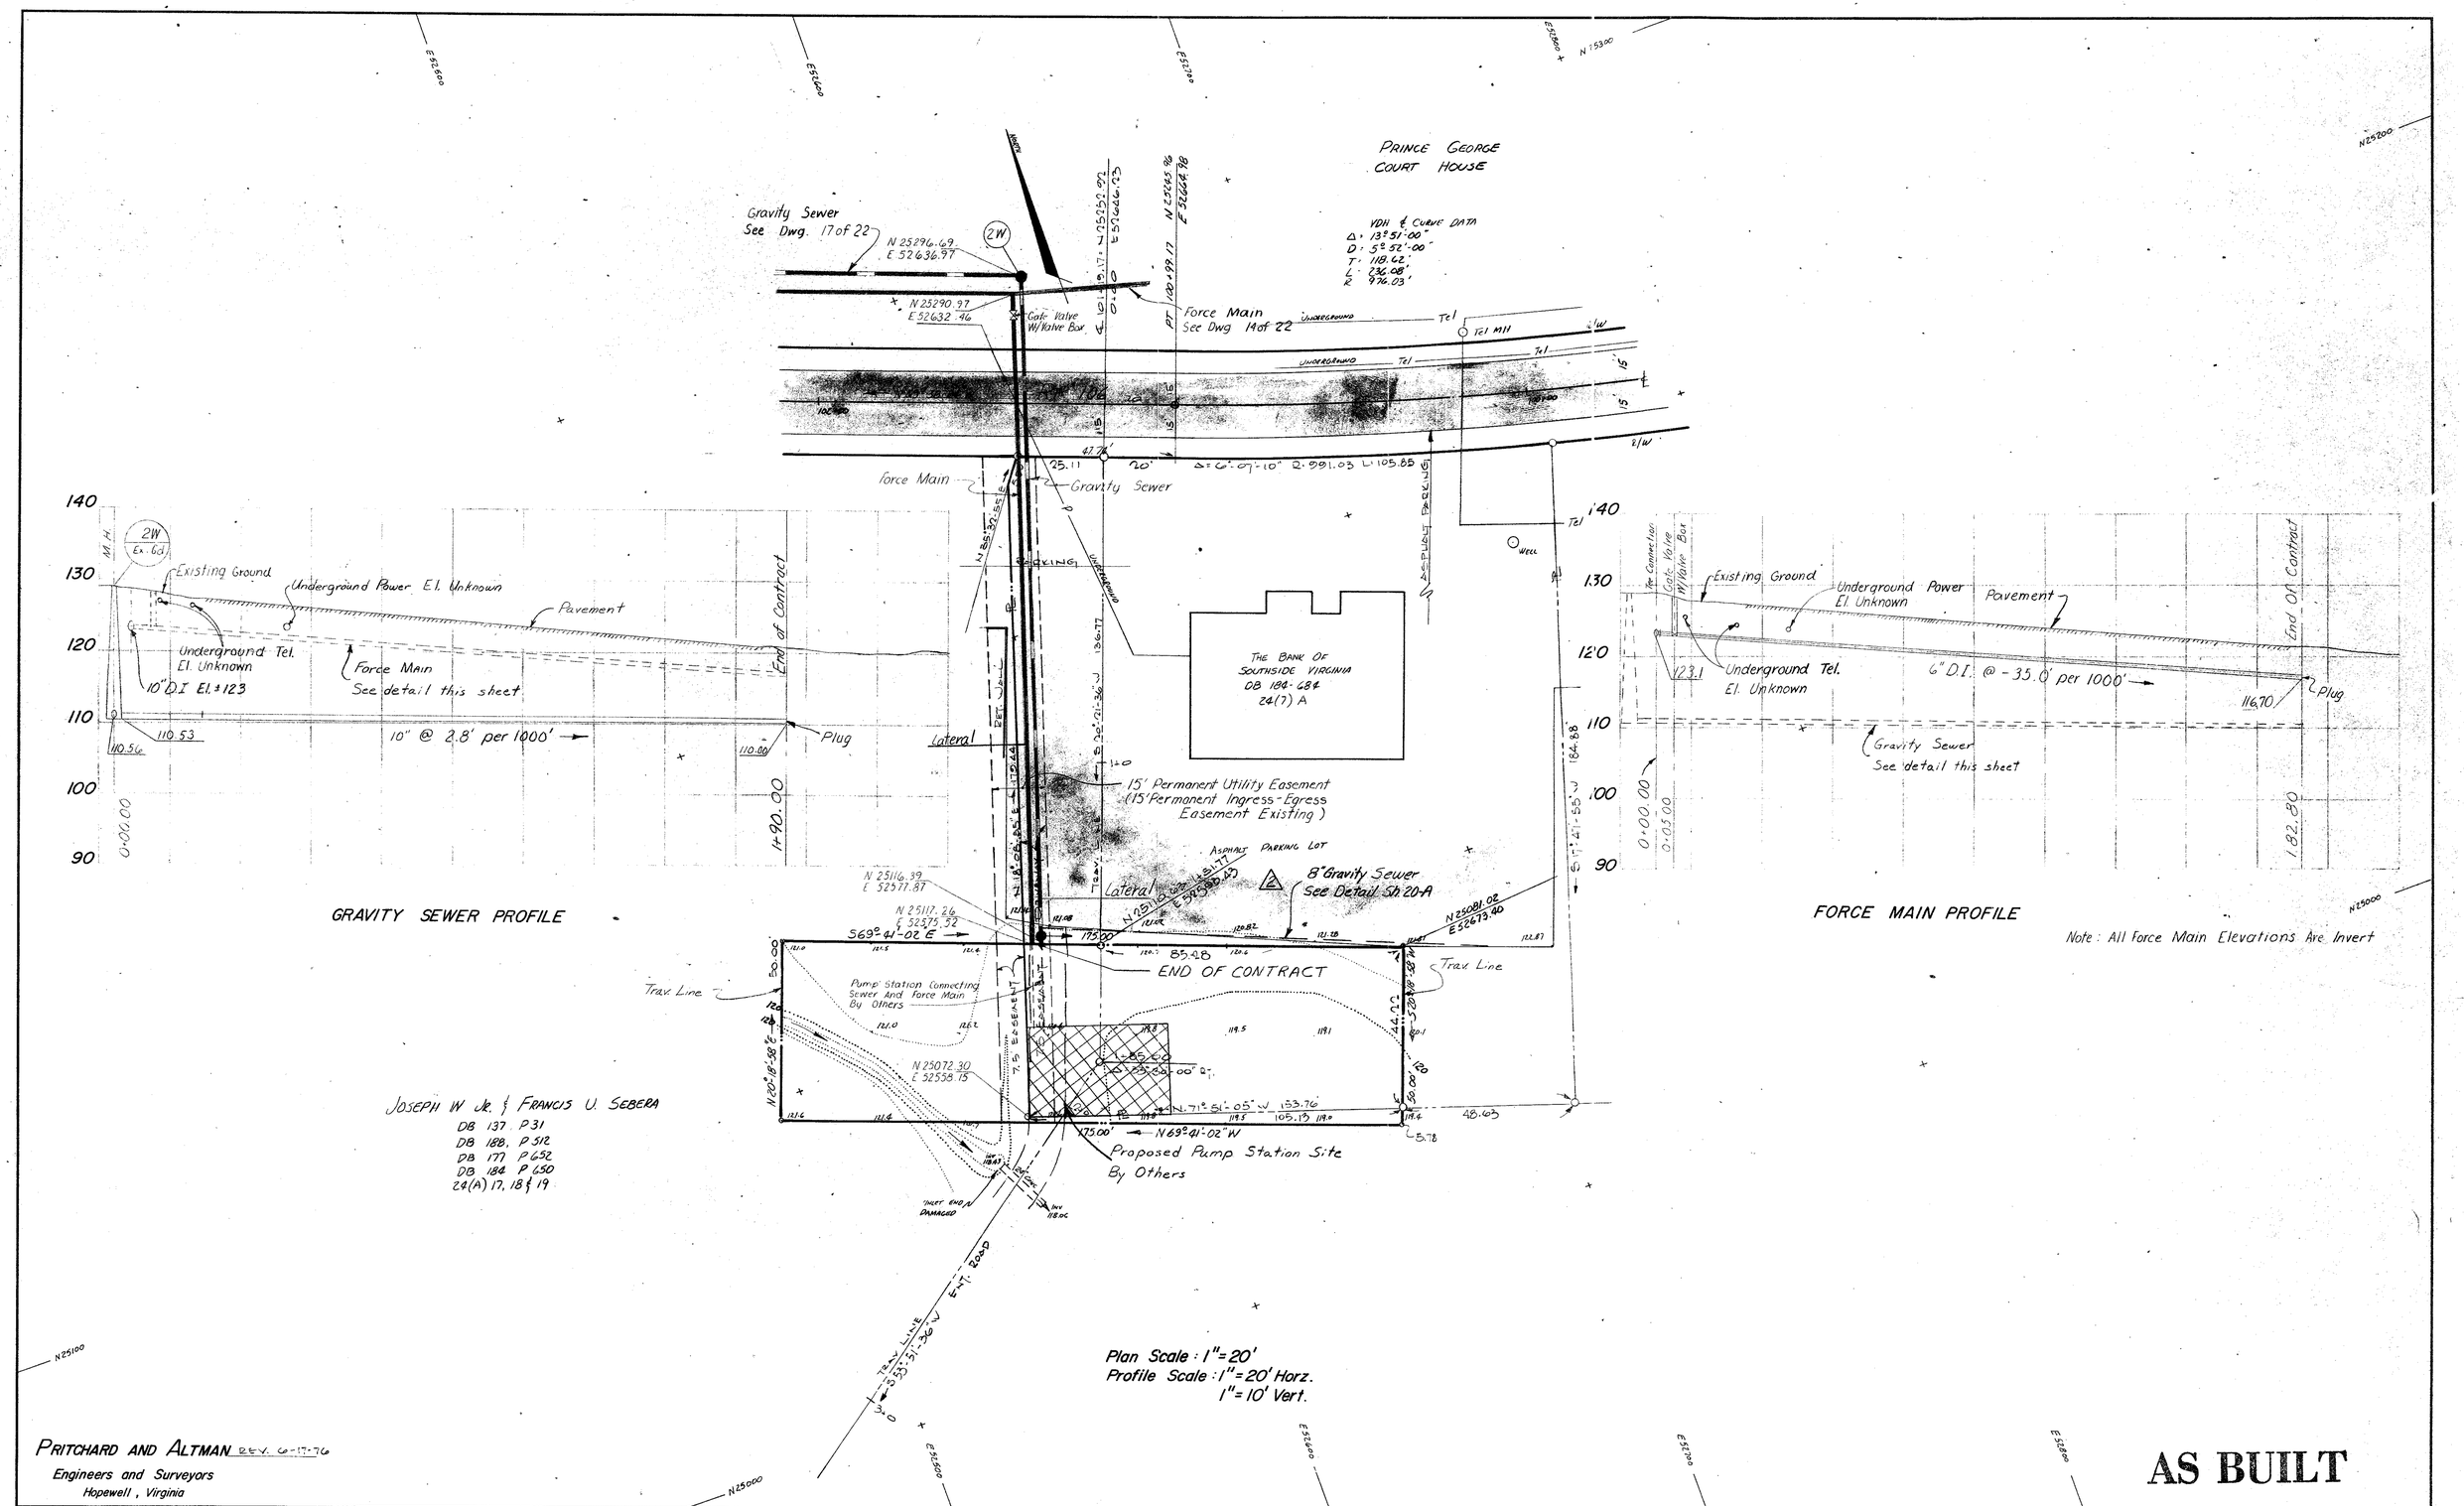

PRITCHARD AND ALTMAN REV. 6-17-76
Engineers and Surveyors
Hopewell, Virginia

AS BUILT

NO.	DATE	APPR.	REVISION	NO.	DATE	APPR.	REVISION
1	2-23-77		Revised Gravity Sewer Profile				
2	12-8-77		Added 8" Gravity Sewer & Notes				

COMMONWEALTH OF VIRGINIA — JOHN L. COMBS — CERTIFICATE No. 6442 — CERTIFIED PROFESSIONAL ENGINEER

		DATE
CHECKED	WHP	8-76
DES. ENG.	JLH	8-76
PROJ. ENG.	JLC	8-76
PROJ. MGR.	RPR	8-76
APPROVED	JLC	8-76
APPROVED		

SUBI-1 Contract-1
PRINCE GEORGE COUNTY, VIRGINIA
UPPER BLACKWATER WASTEWATER COLLECTION SYSTEM
Route 106 Sanitary Sewer M.H. 2 (Bank Area)

ROY F. WESTON
ENVIRONMENTAL SCIENTISTS AND ENGINEERS
LEWIS LANE • WEST CHESTER • PENNSYLVANIA • 19380

PREPARED BY	DATE	SCALE	W. O. NO.	DWG. NO.
VIRGINIA OFFICE				20 of 22
DRAWN RLM	8-76	As Noted	1535-01	

SHEET NO.