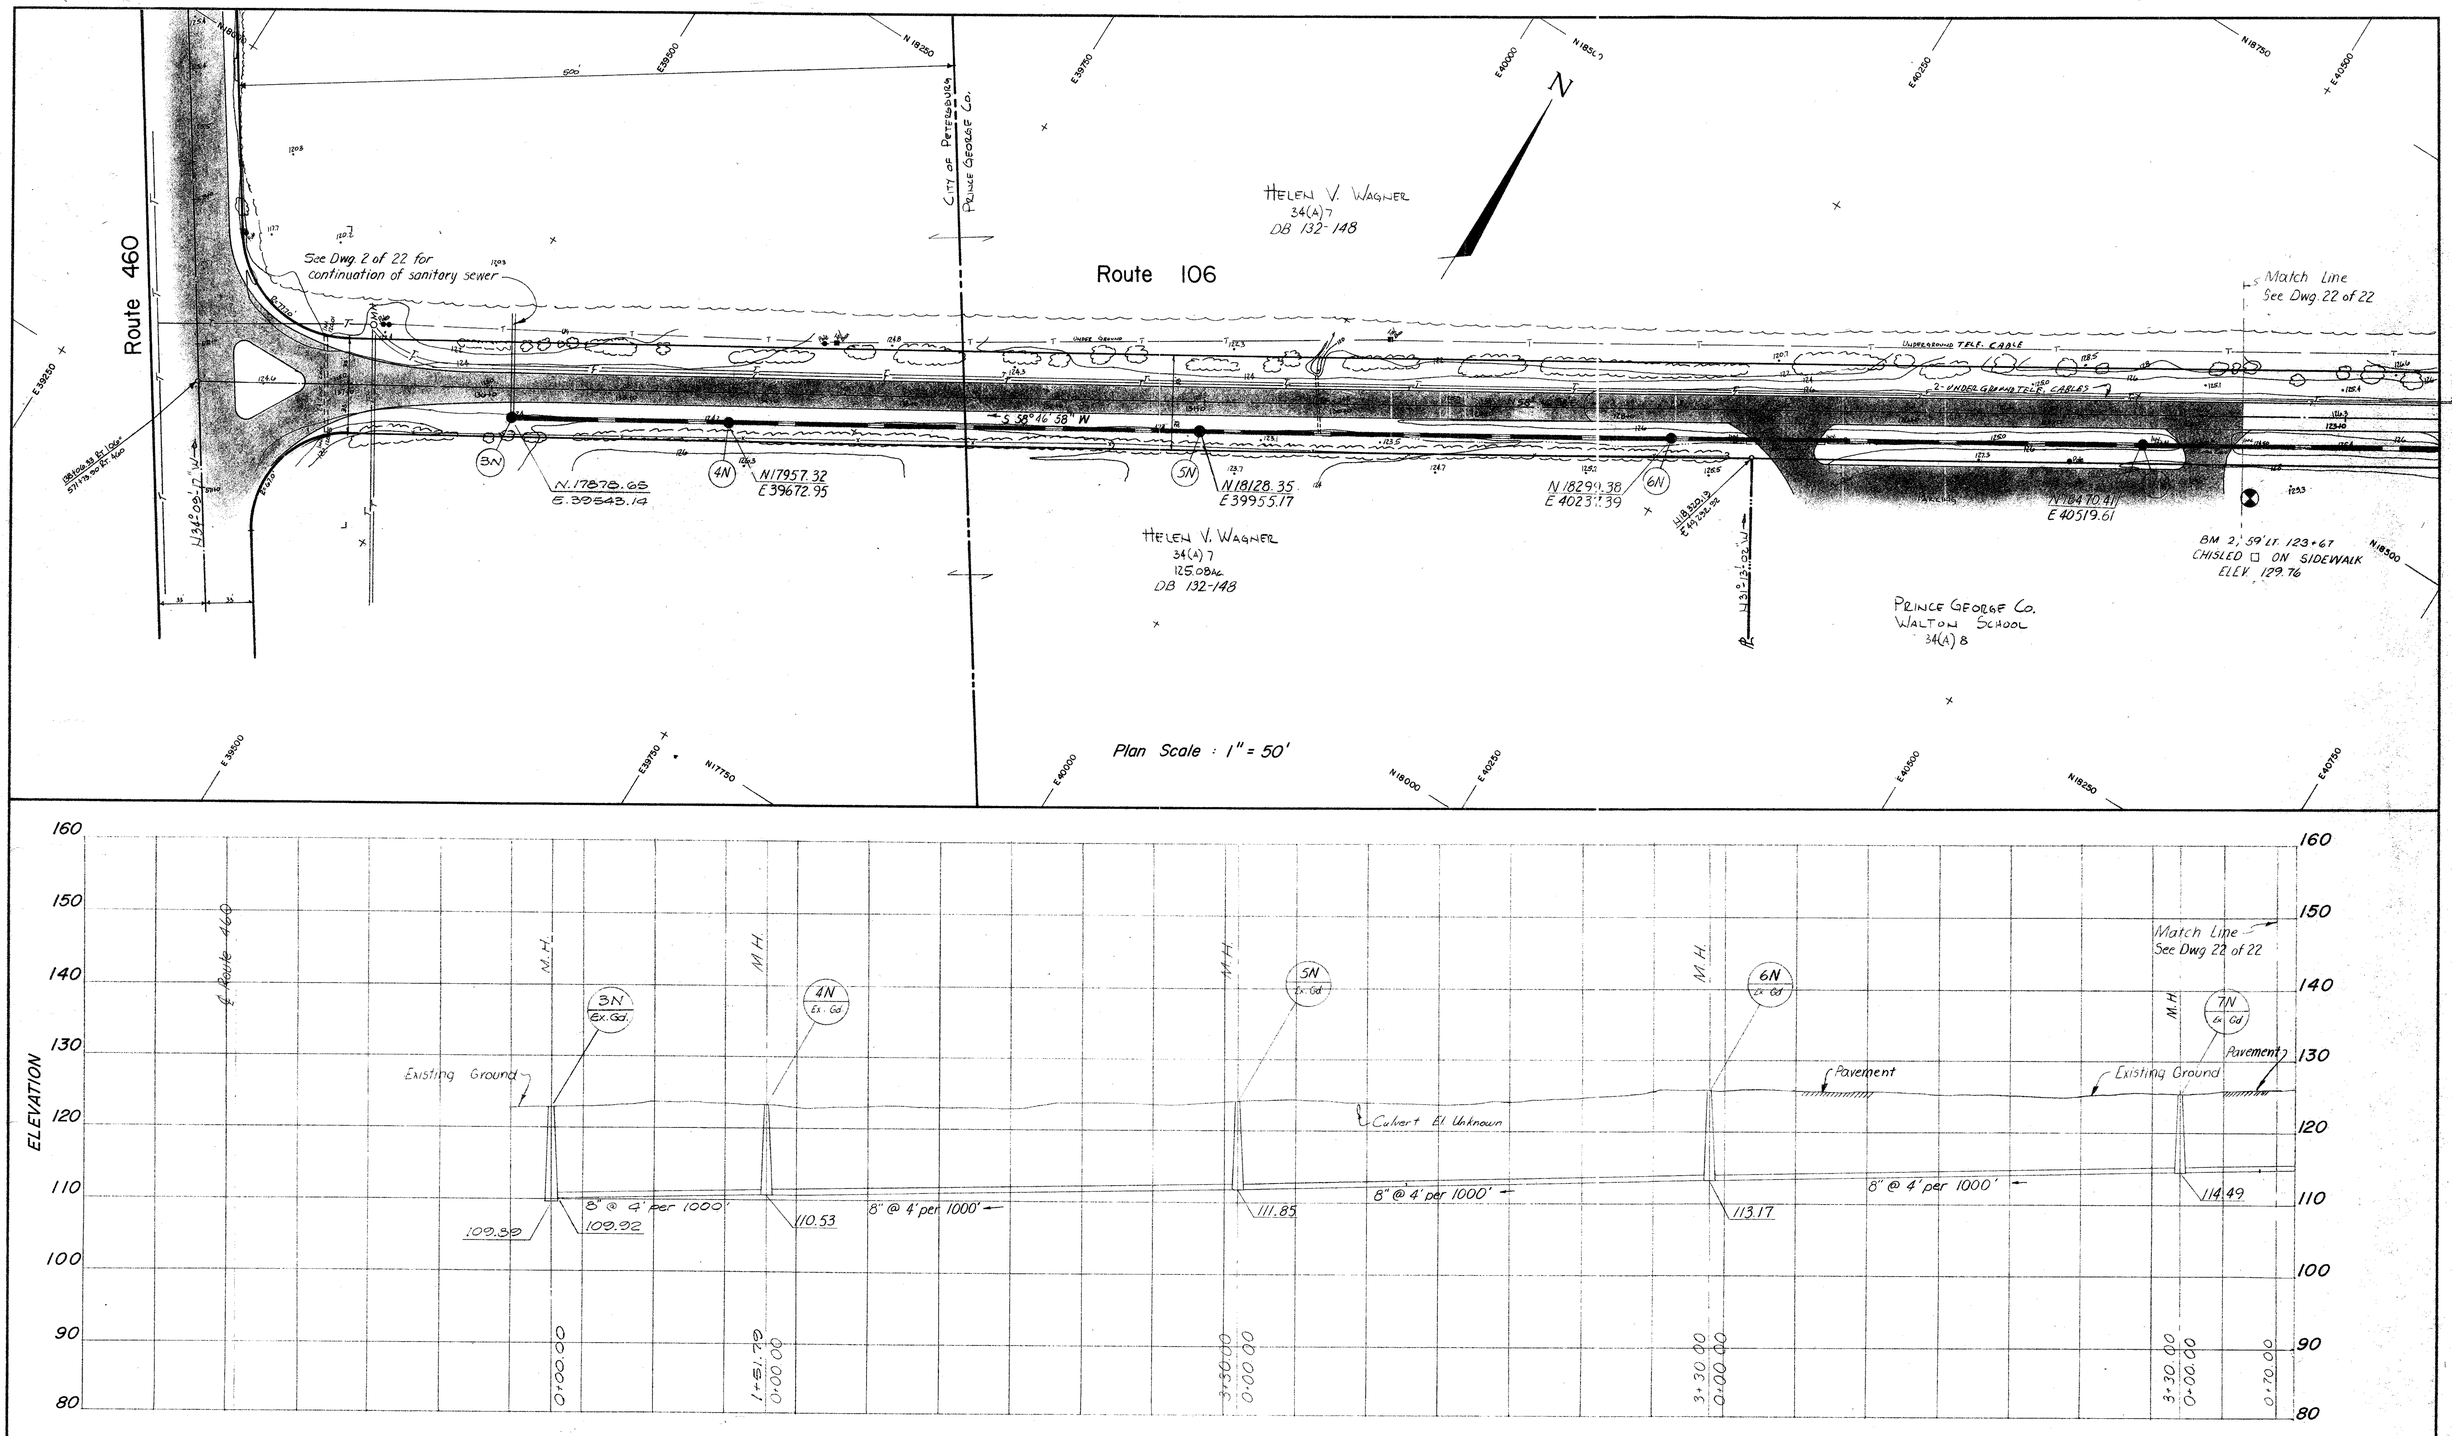

AS BUILT

PRITCHARD AND ALTMAN
Engineers and Surveyors
Hopewell, Virginia

NO.	DATE	APPR.	REVISION	NO.	DATE	APPR.	REVISION
1	11-15-76		RELOCATE M.H. # 3N				

COMMONWEALTH OF VIRGINIA
JOHN L. COMBS
CERTIFICATE No. 6442
CERTIFIED PROFESSIONAL ENGINEER

		DATE
CHECKED	WHP	8-76
DES. ENG.	JLH	8-76
PROJ. ENG.	JLC	8-76
PROJ. MGR.	RPR	8-76
APPROVED	JLC	8-76
APPROVED		

SUB-1 Contract-1
PRINCE GEORGE COUNTY, VIRGINIA
UPPER BLACKWATER WASTEWATER COLLECTION SYSTEM
Walton School Sanitary Sewer M.H. 3 - 7N

ROY F. WESTON
ENVIRONMENTAL SCIENTISTS AND ENGINEERS
LEWIS LANE • WEST CHESTER • PENNSYLVANIA • 19380

PREPARED BY				DWG. NO.
VIRGINIA OFFICE				21 of 22
DRAWN	DATE	SCALE	W. O. NO.	
RLM	8-76	As Noted	1535-01	

SHEET NO.