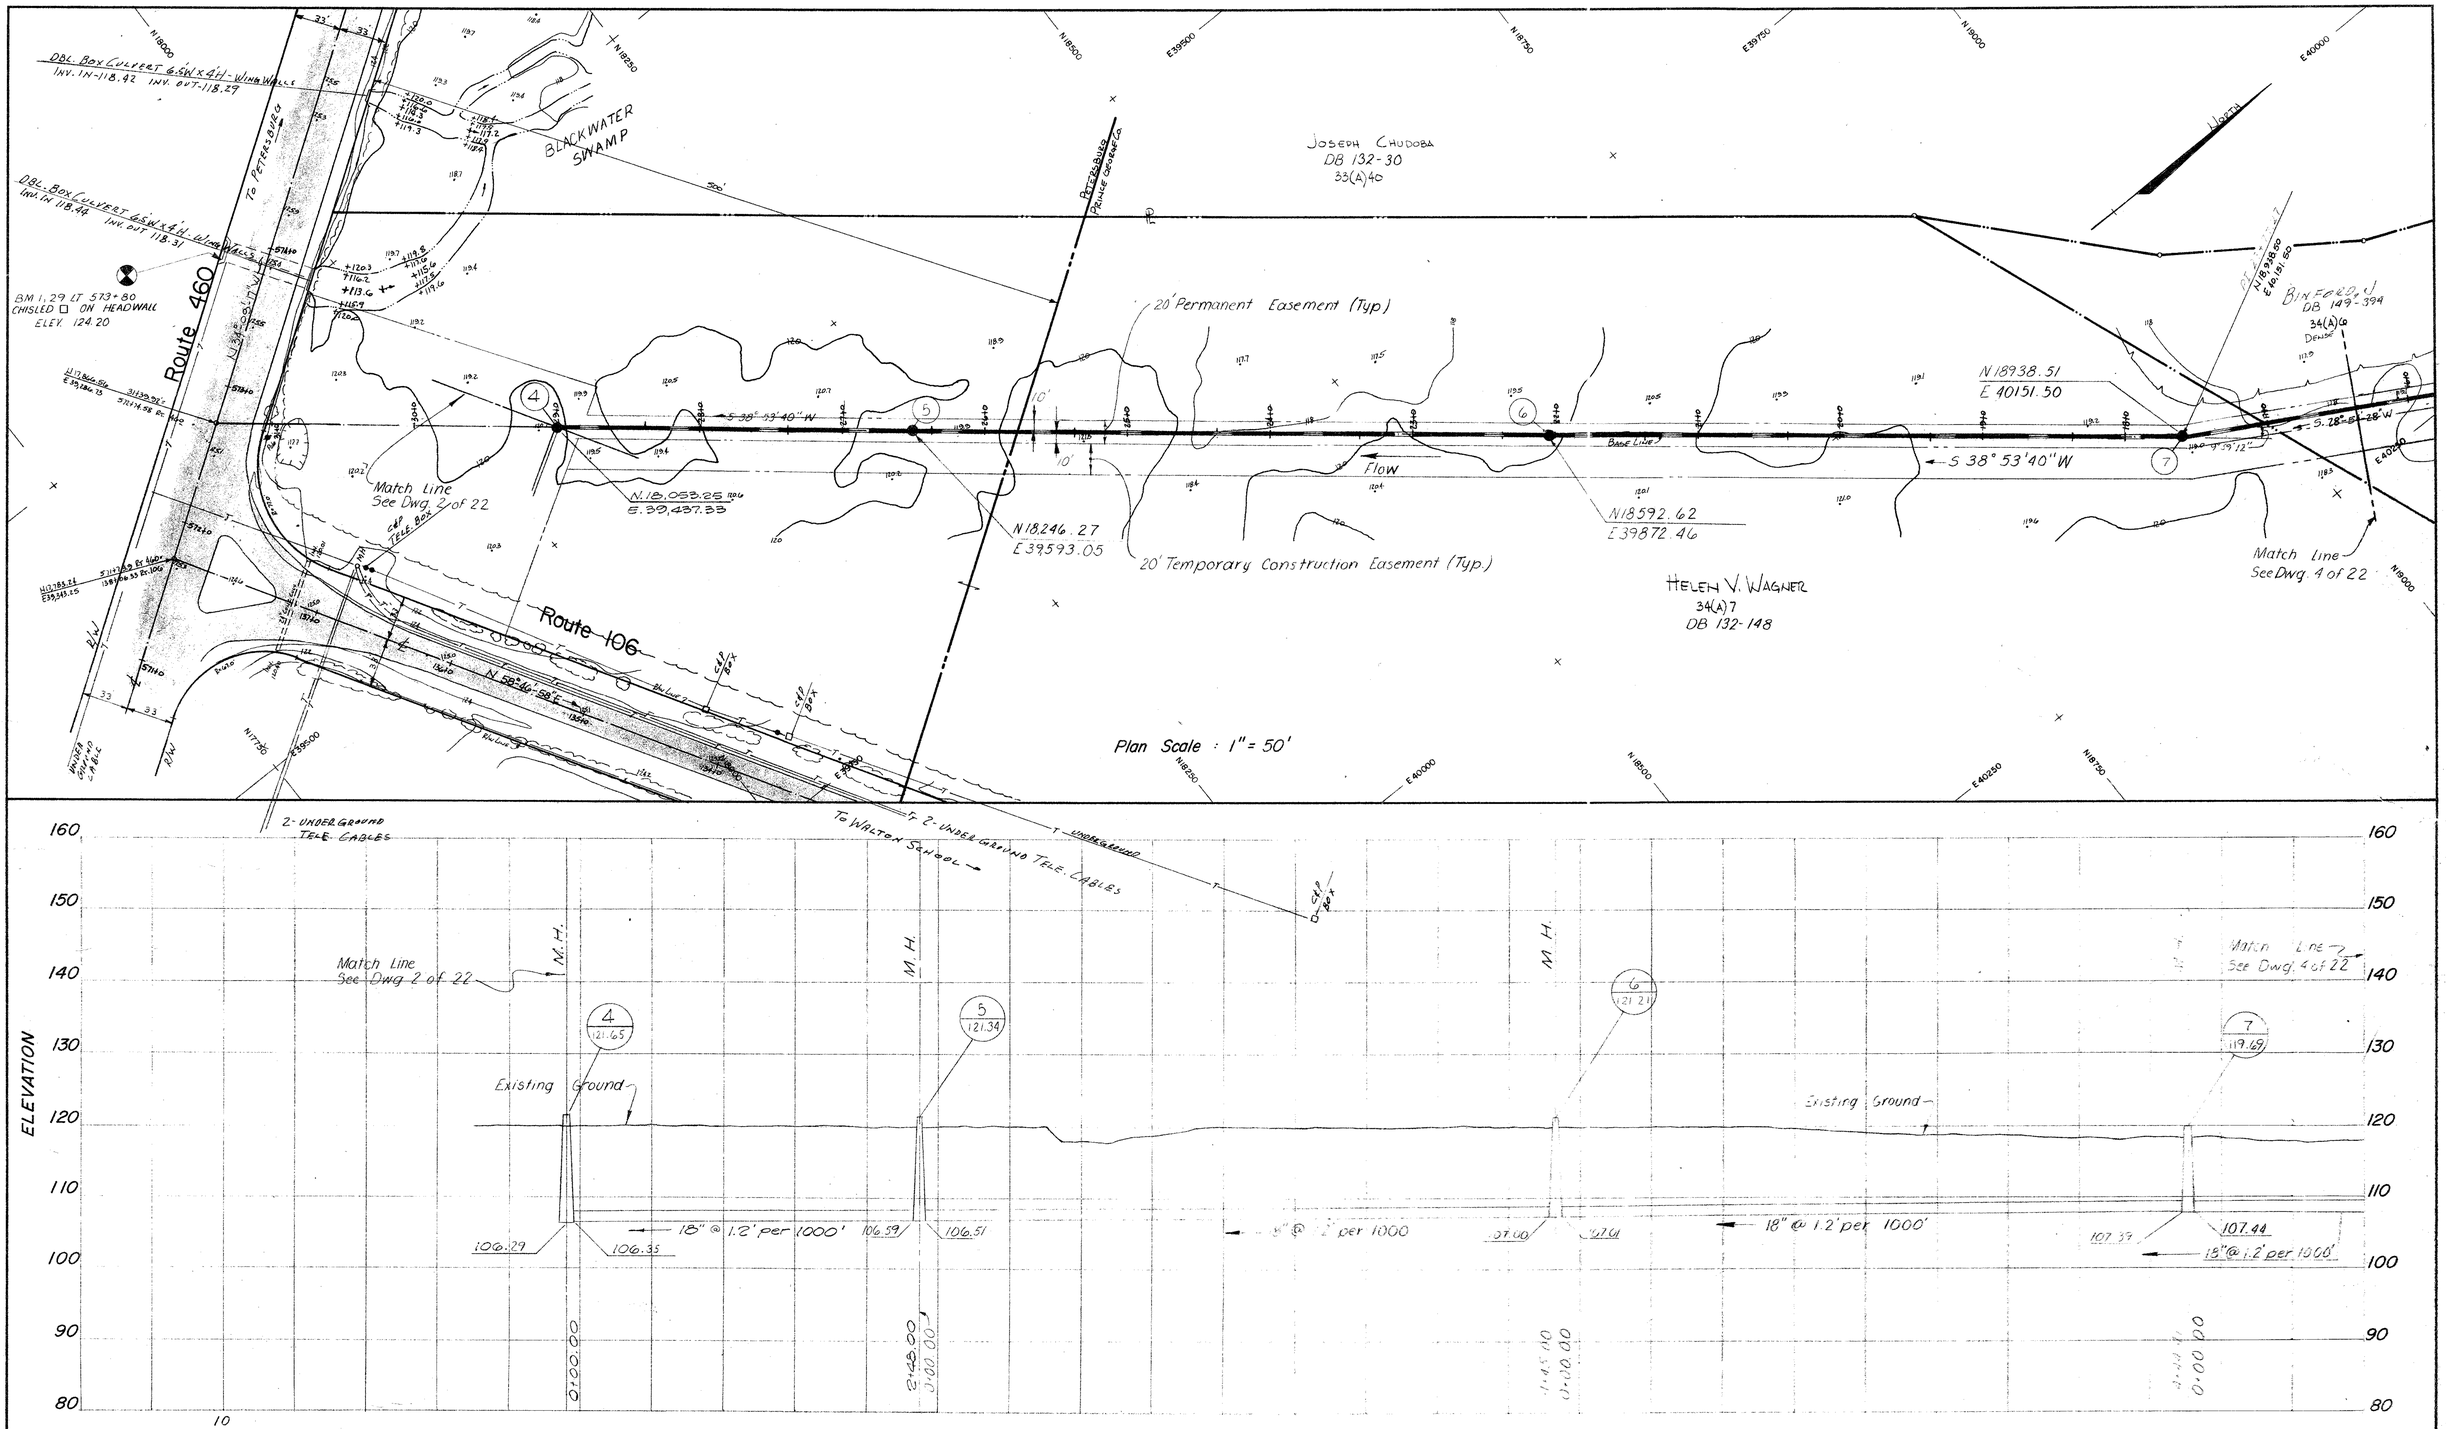

AS BUILT

PRITCHARD AND ALTMAN
Engineers and Surveyors
Hopewell, Virginia

NO.	DATE	APPR.	REVISION	NO.	DATE	APPR.	REVISION
1	11-15-76		RELOCATE M.H. #4.				

COMMONWEALTH OF VIRGINIA
JOHN L. COMBS
CERTIFICATE No. 6442
LICENSED PROFESSIONAL ENGINEER

		DATE
CHECKED		
DES. ENG.		
PROJ. ENG.		
PROJ. MGR.		
APPROVED		
APPROVED		

SUB-1 Contract-1
PRINCE GEORGE COUNTY, VIRGINIA
UPPER BLACKWATER WASTEWATER COLLECTION SYSTEM
Blackwater Sanitary Sewer M.H. 4-7

ROY F. WESTON
ENVIRONMENTAL SCIENTISTS AND ENGINEERS
LEWIS LANE • WEST CHESTER • PENNSYLVANIA • 19380

PREPARED BY	DATE	SCALE	W.O. NO.	DWG. NO.
VIRGINIA OFFICE				3 of 22
DRAWN RLM	8-76	As Noted	1535-01	

SHEET NO.