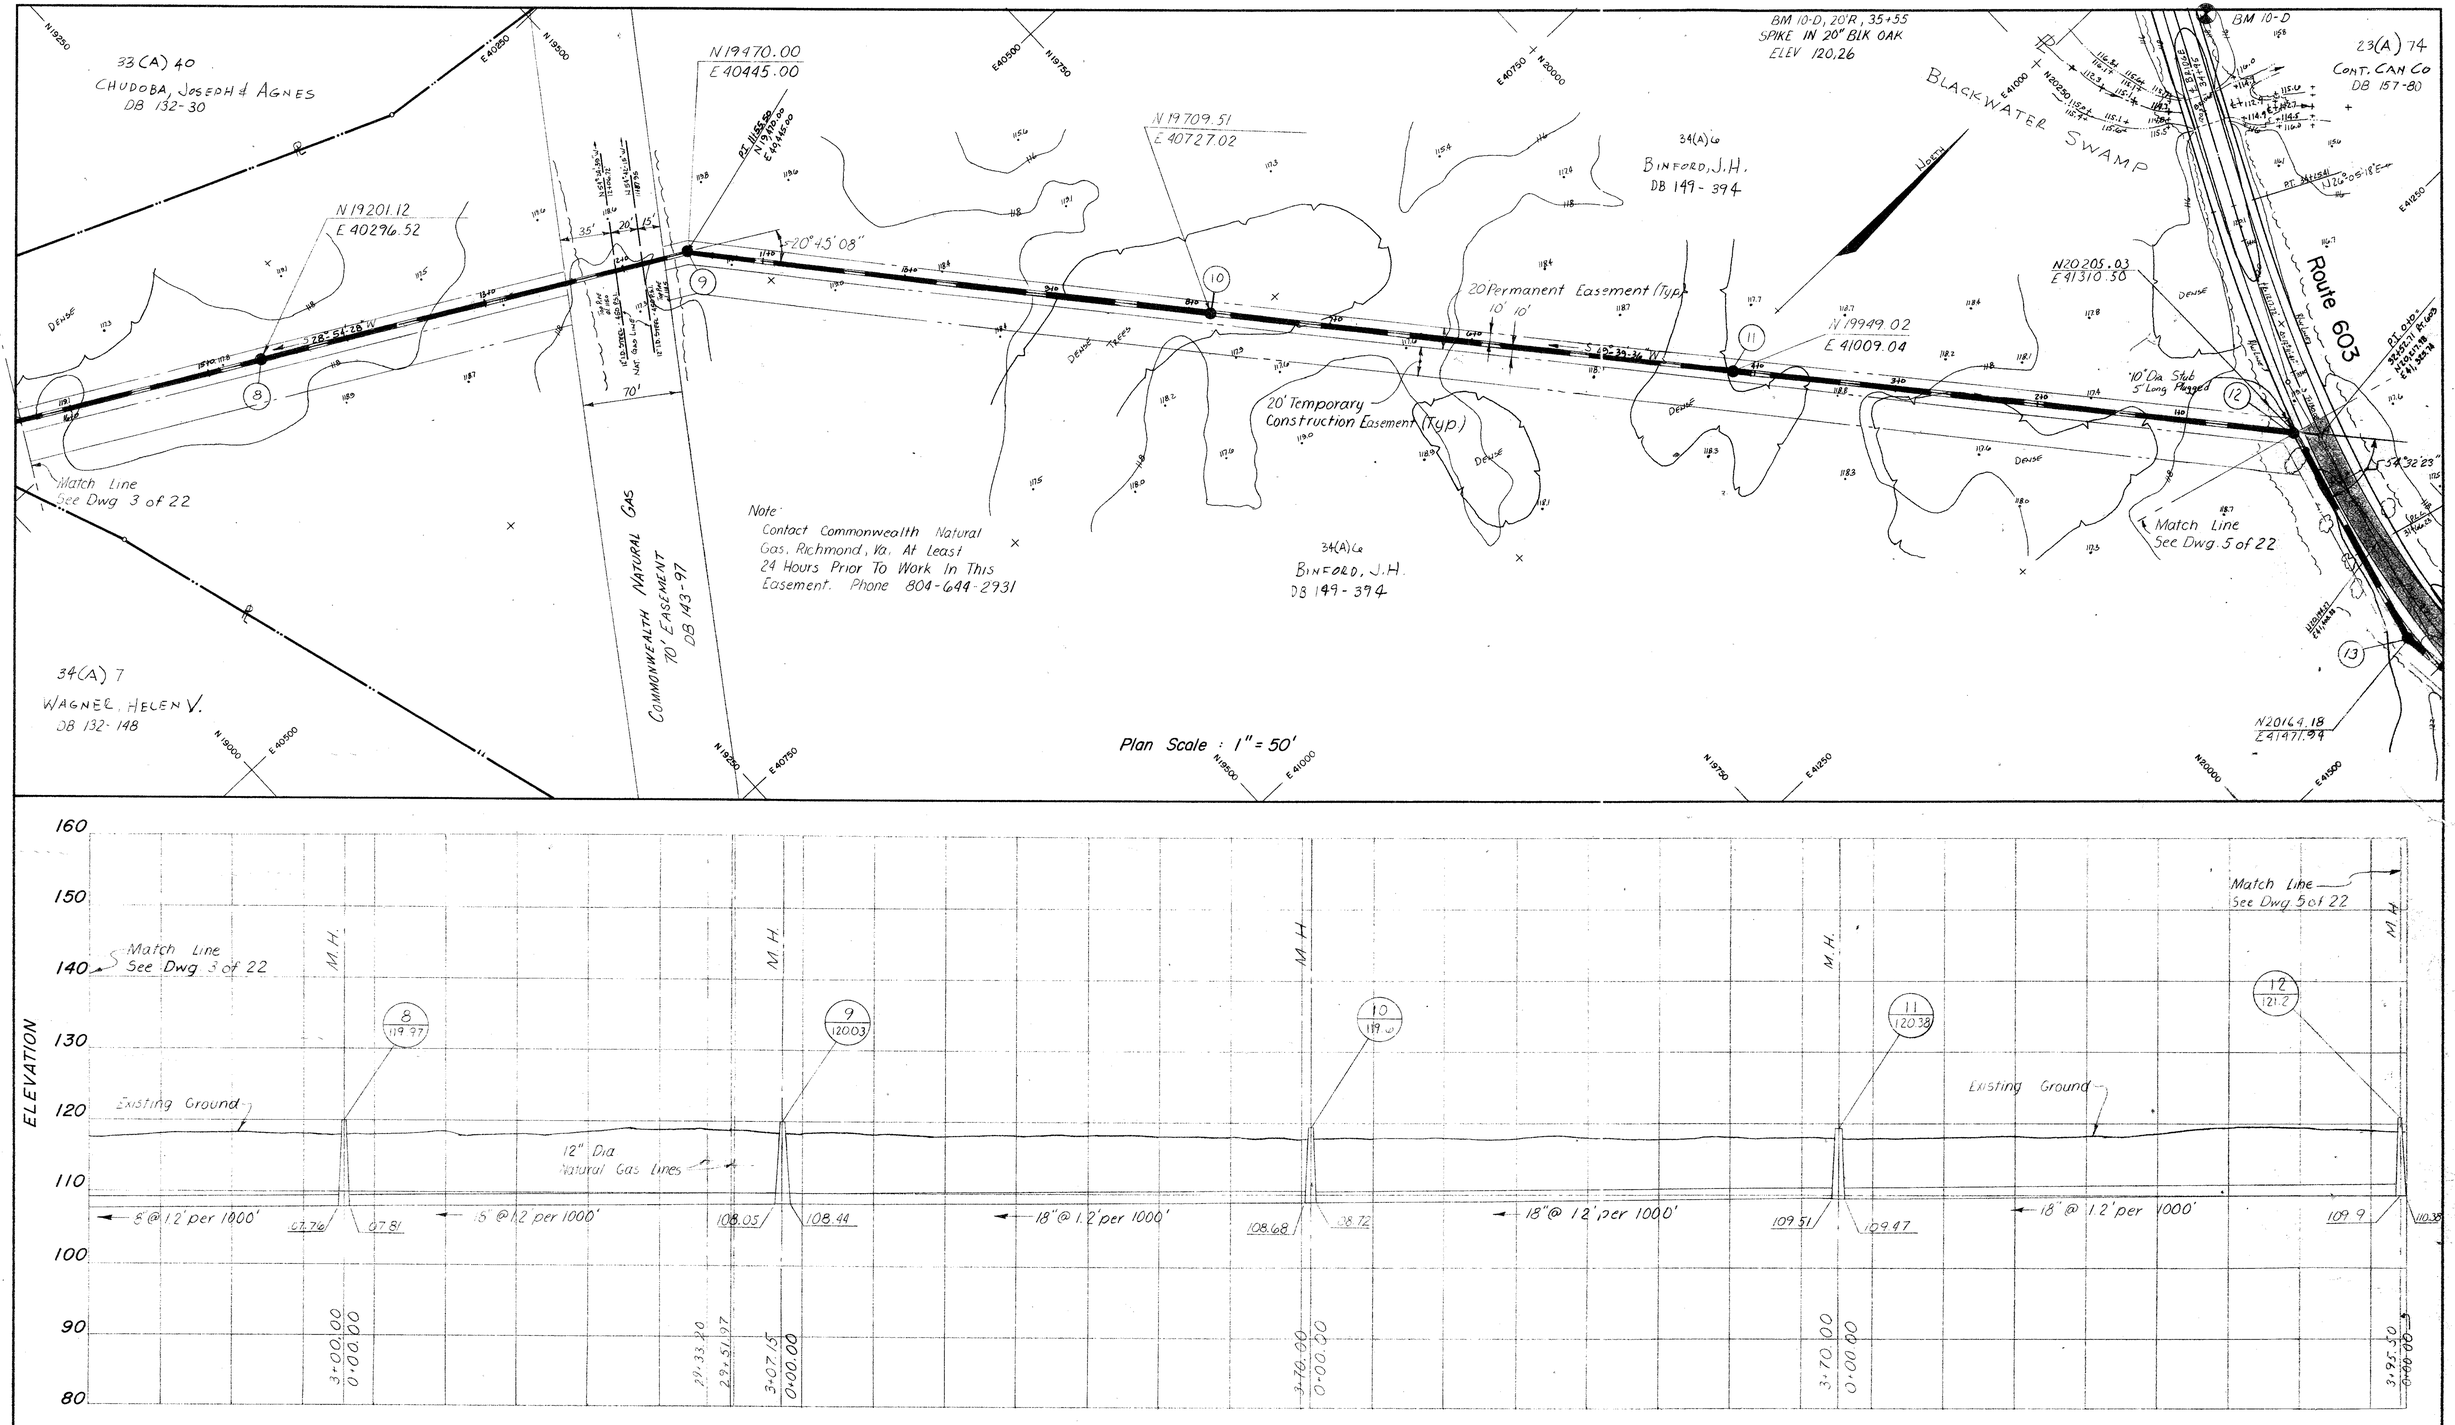

PRITCHARD AND ALTMAN
Engineers and Surveyors
Hopewell, Virginia

Profile Scale: 1" = 50' Horz.
1" = 10' Vert.

AS BUILT

NO.	DATE	APPR.	REVISION	NO.	DATE	APPR.	REVISION
1	1-14-77	JPH	Delete Steel Pipe Encasement Under Natural Gas Lines				

COMMONWEALTH OF VIRGINIA
JOHN L. COMBS
CERTIFICATE No. 6442
CERTIFIED PROFESSIONAL ENGINEER

CHECKED	WHP	DATE 8-76
DES. ENG.	JLH	8-76
PROJ. ENG.	JLC	8-76
PROJ. MGR.	RPR	8-76
APPROVED	JLC	8-76
APPROVED		

SUE-1 Contract-1

PRINCE GEORGE COUNTY, VIRGINIA
UPPER BLACKWATER WASTEWATER COLLECTION SYSTEM
Blackwater Sanitary Sewer M.H. 8-12

ROY F. WESTON
ENVIRONMENTAL SCIENTISTS AND ENGINEERS
LEWIS LANE • WEST CHESTER • PENNSYLVANIA • 19380

PREPARED BY	DWG. NO.
VIRGINIA OFFICE	4 OF 22

DRAWN	DATE	SCALE	W. O. NO.
RLM	8 76	As Noted	1535-01

SHEET NO.