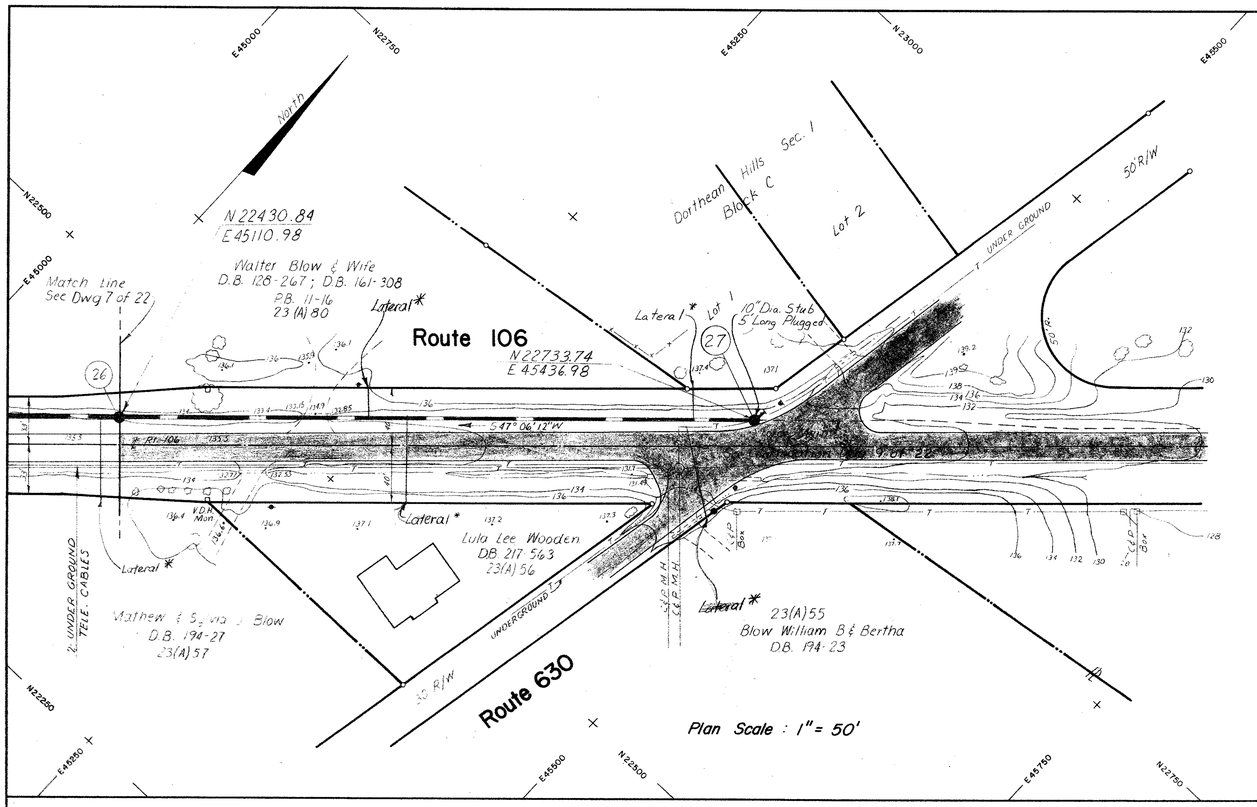

*Lateral Connection (Typ.)
See Detail in Specifications
Location to be Determined in Field

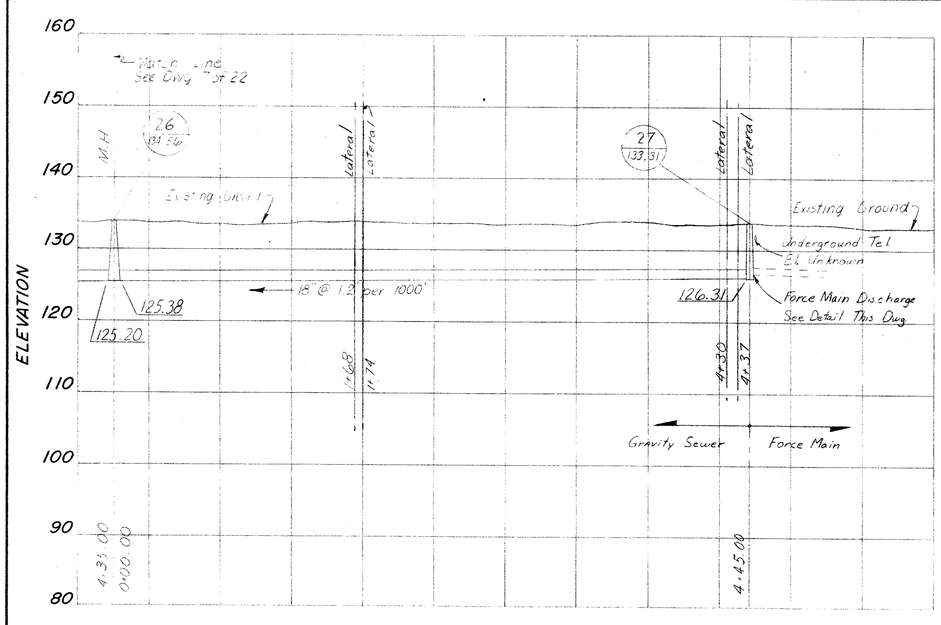

Note: M.H. 27 and Gravity Sewer between M.H. 26 and M.H. 27 to be PVC Lined, See Specifications For Details

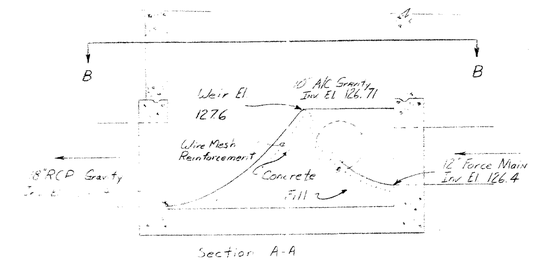

Section A-A

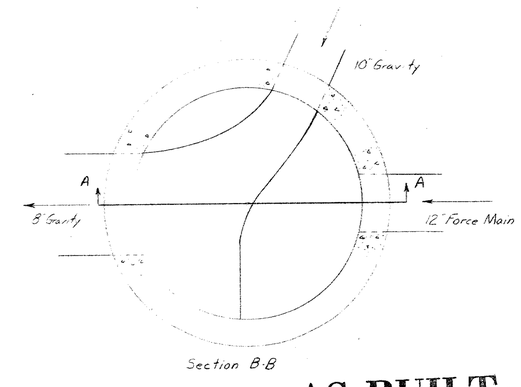

Section B-B

FORCE MAIN DISCHARGE DETAIL

AS BUILT

PRITCHARD AND ALTMAN
Engineers and Surveyors
Hopewell, Virginia

Profile Scale: 1" = 50' Horz.
1" = 10' Vert.

NO.	DATE	APPR.	REVISION	NO.	DATE	APPR.	REVISION

COMMONWEALTH OF VIRGINIA
JOHN L. COMBS
CERTIFICATE No. 6442
REGISTERED PROFESSIONAL ENGINEER

		DATE
CHECKED	M.H.E.	8-76
REC. ENG.		8-76
PROJ. ENG.		8-76
PROJ. MGR.		8-76
APPROVED		8-76
COMPANY		8-76

SUB-1 Contract-1
PRINCE GEORGE COUNTY, VIRGINIA
UPPER BLACKWATER WASTEWATER COLLECTION SYSTEM
Blackwater Sanitary Sewer M.H. 26-27

ROY F. WESTON
ENVIRONMENTAL SCIENTISTS AND ENGINEERS
LEWIS LANE • WEST CHESTER • PENNSYLVANIA • 19380

PREPARED BY				DWG. NO.
VIRGINIA OFFICE				8 of 22
DRAWN	DATE	SCALE	W. O. NO.	
RLM	8-76	As Noted	1535-01	

SHEET NO.