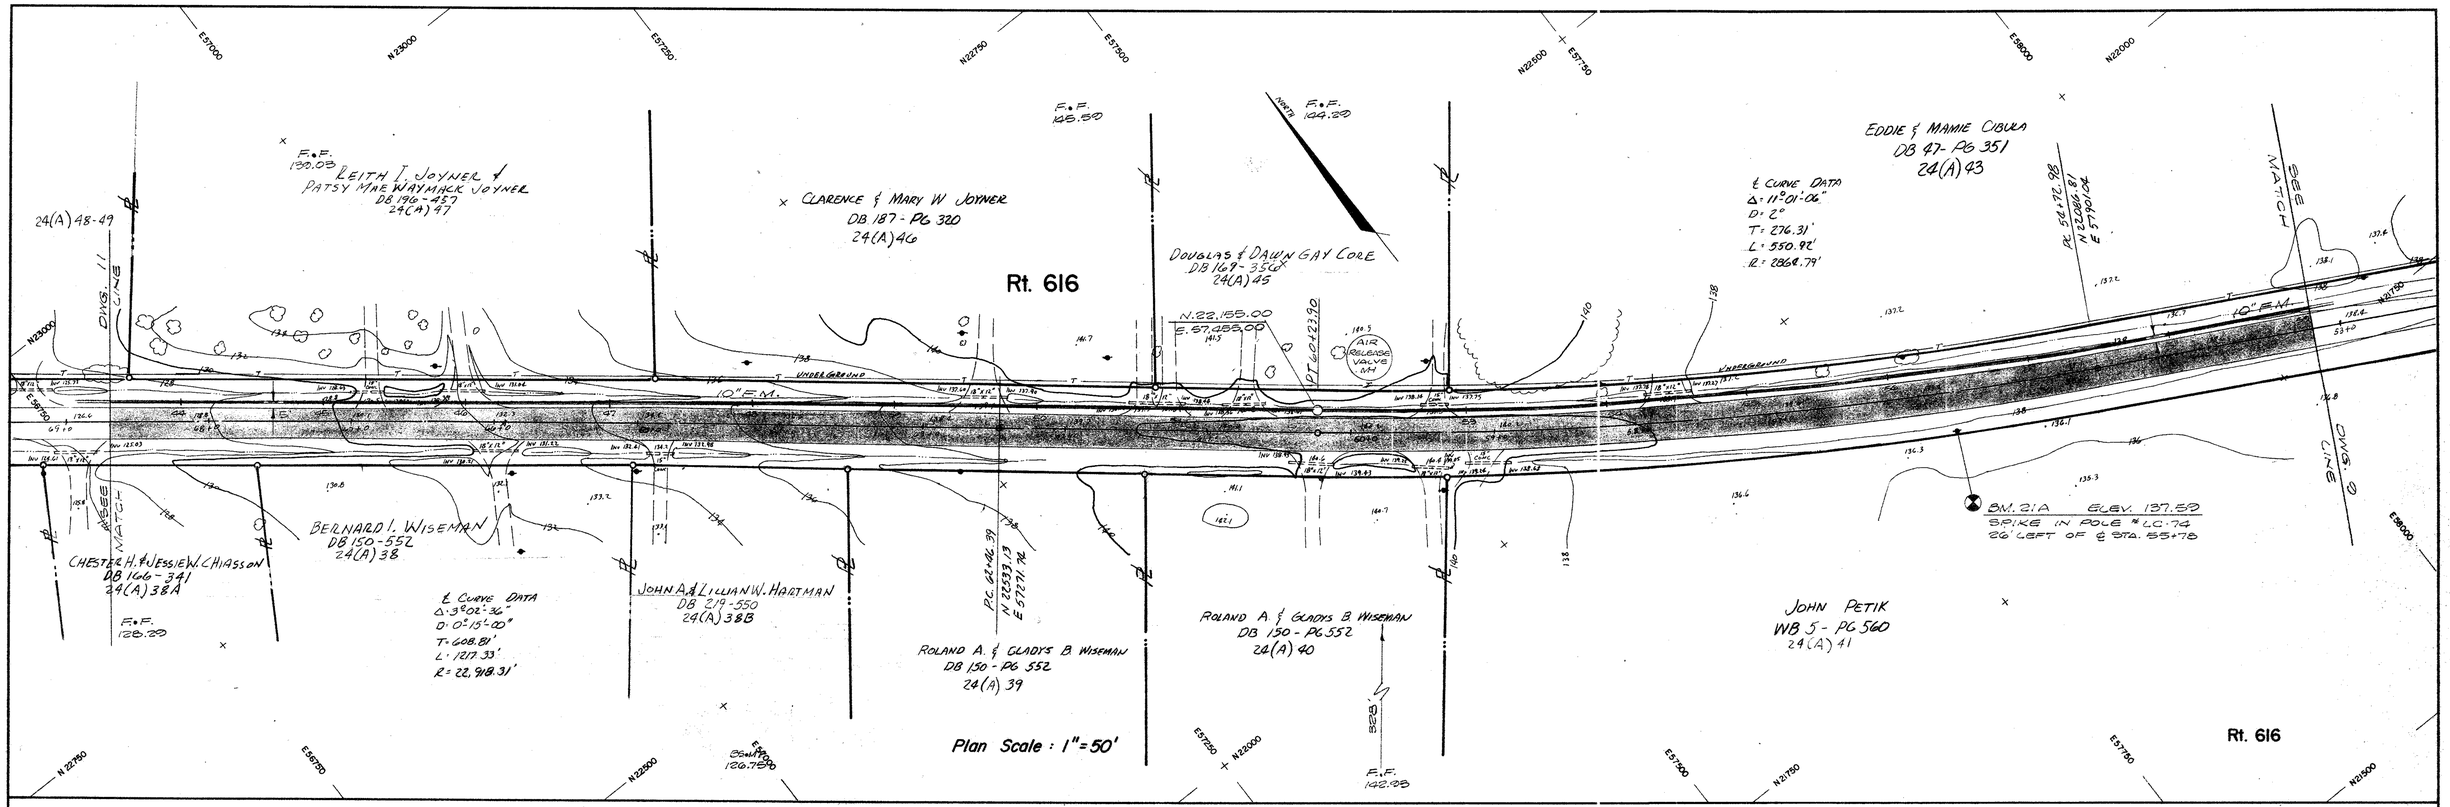

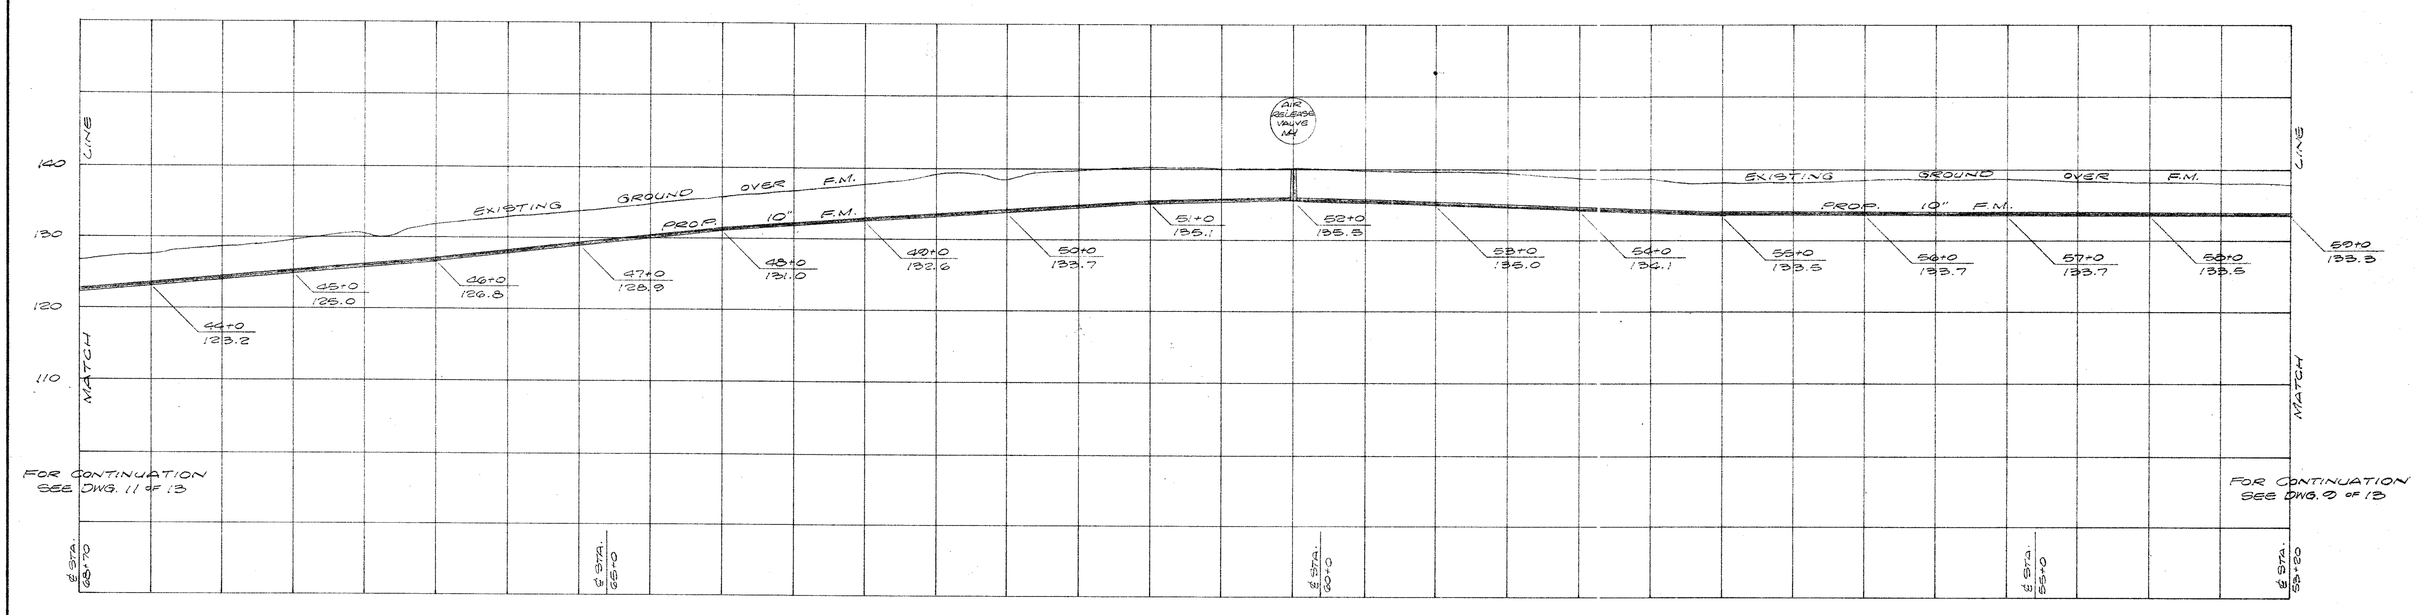

PROFILE SCALES
HOR. 1" = 50'
VERT. 1" = 10'

AS BUILT

PRITCHARD AND ALTMAN
Engineers and Surveyors
Hopewell, Virginia

NO.	DATE	APPR.	REVISION	NO.	DATE	APPR.	REVISION
1	11-15-76		ADD FL. ELEV., CO-ORD.				

COMMONWEALTH OF VIRGINIA
JOHN L. COMBS
CERTIFICATE No. 6442
REGISTERED PROFESSIONAL ENGINEER

CHECKED		DATE
DES. ENG.	LFA	
PROJ. ENG.		
PROJ. MGR.	RYK	
APPROVED		
APPROVED		

SUB-1 Contract-2
PRINCE GEORGE COUNTY, VIRGINIA
UPPER BLACKWATER WASTEWATER COLLECTION SYSTEM
Route 616 – 10" Force Main Sta. 43+50 to Sta. 59+00

ROY F. WESTON
ENVIRONMENTAL SCIENTISTS AND ENGINEERS
LEWIS LANE ▪ WEST CHESTER ▪ PENNSYLVANIA ▪ 19380

PREPARED BY	DATE	SCALE	W. O. NO.	DWG. NO.
MARYLAND OFFICE				10 OF 13
DRAWN	AUG. 1976	AS NOTED	1535-01	

N3259

SHEET NO.