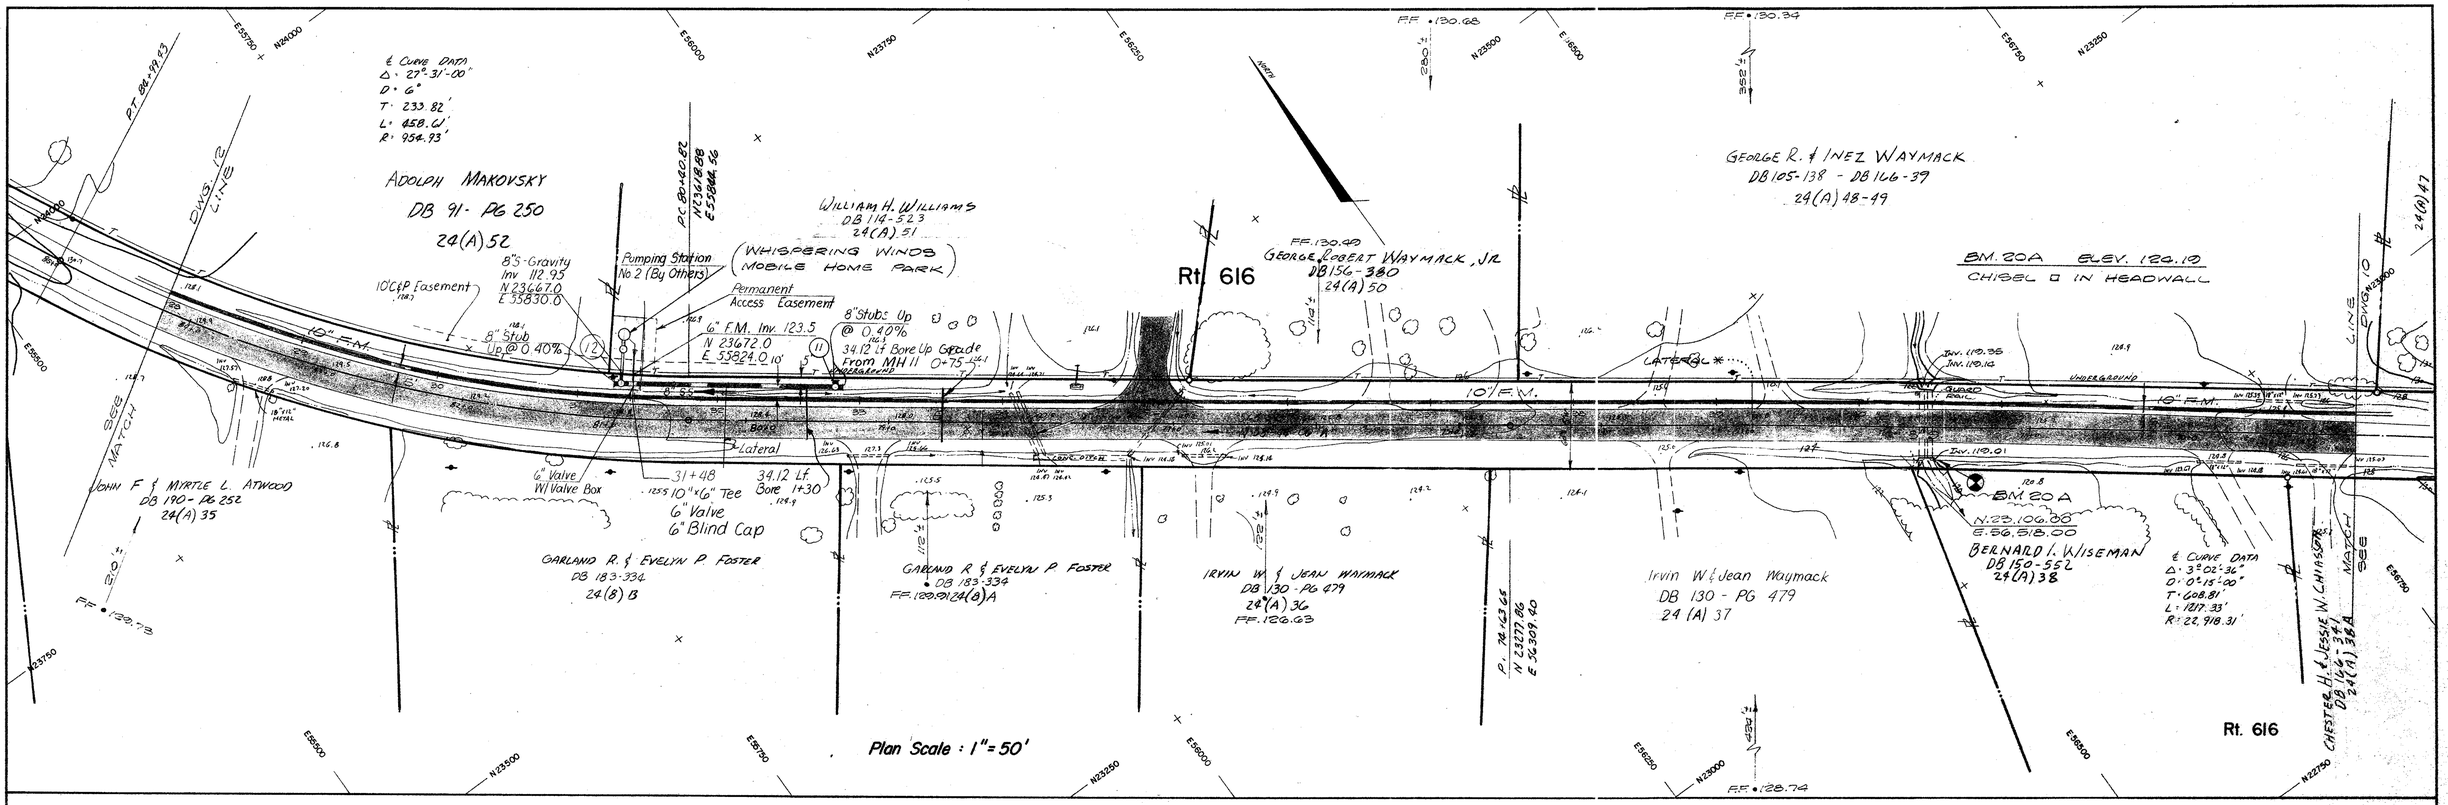

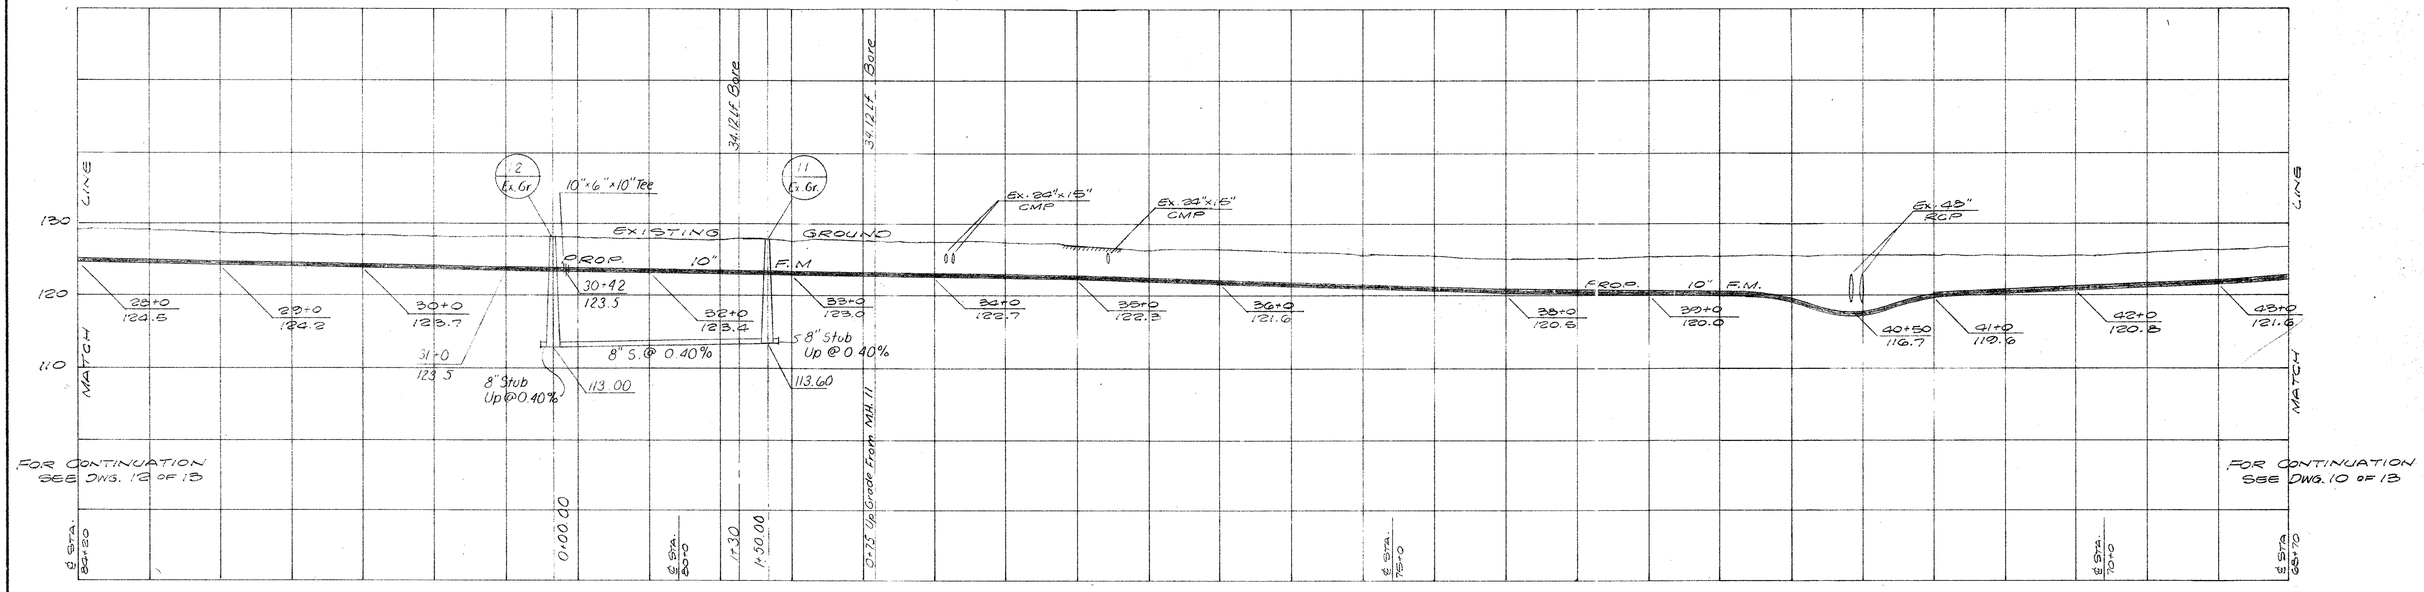

PROFILE SCALES
HOR. 1" = 50'
VERT. 1" = 10'

AS BUILT

PRITCHARD AND ALTMAN
Engineers and Surveyors
Hopewell, Virginia

NO.	DATE	APPR.	REVISION	NO.	DATE	APPR.	REVISION
1	9-15-76		Extend 8' Stub (Sh. 2-26) across Rt 616				
2	9-20-76		Revise 8" Inv. El N 23,140.0 E 55,845.5 to 112.05				
3	11-15-76		ADD. CO-ORD.				
4	12-20-76		Revise Location Of 8" Sanitary Sewer				
5	12-20-76		Relocate Pump Station				

COMMONWEALTH OF VIRGINIA
JOHN L. COMBS
CERTIFICATE No. 6442
REGISTERED PROFESSIONAL ENGINEER

	CHECKED	DATE
DES. ENG.	GFH	8-76
PROJ. ENG.		
PROJ. MGR.	RPR	8-76
APPROVED		
APPROVED		8-76

SUB-1 Contract-2
PRINCE GEORGE COUNTY, VIRGINIA
UPPER BLACKWATER WASTEWATER COLLECTION SYSTEM
Route 616 - 10" Force Main Sta. 28+00 to 43+50

ROY F. WESTON
ENVIRONMENTAL SCIENTISTS AND ENGINEERS
LEWIS LANE • WEST CHESTER • PENNSYLVANIA • 19380

PREPARED BY				DWG. NO.
MARYLAND OFFICE				11 OF 13
DRAWN	DATE	SCALE	W. O. NO.	
	AUG. 1976	AS NOTED	1535-01	

N2259

SHEET NO.