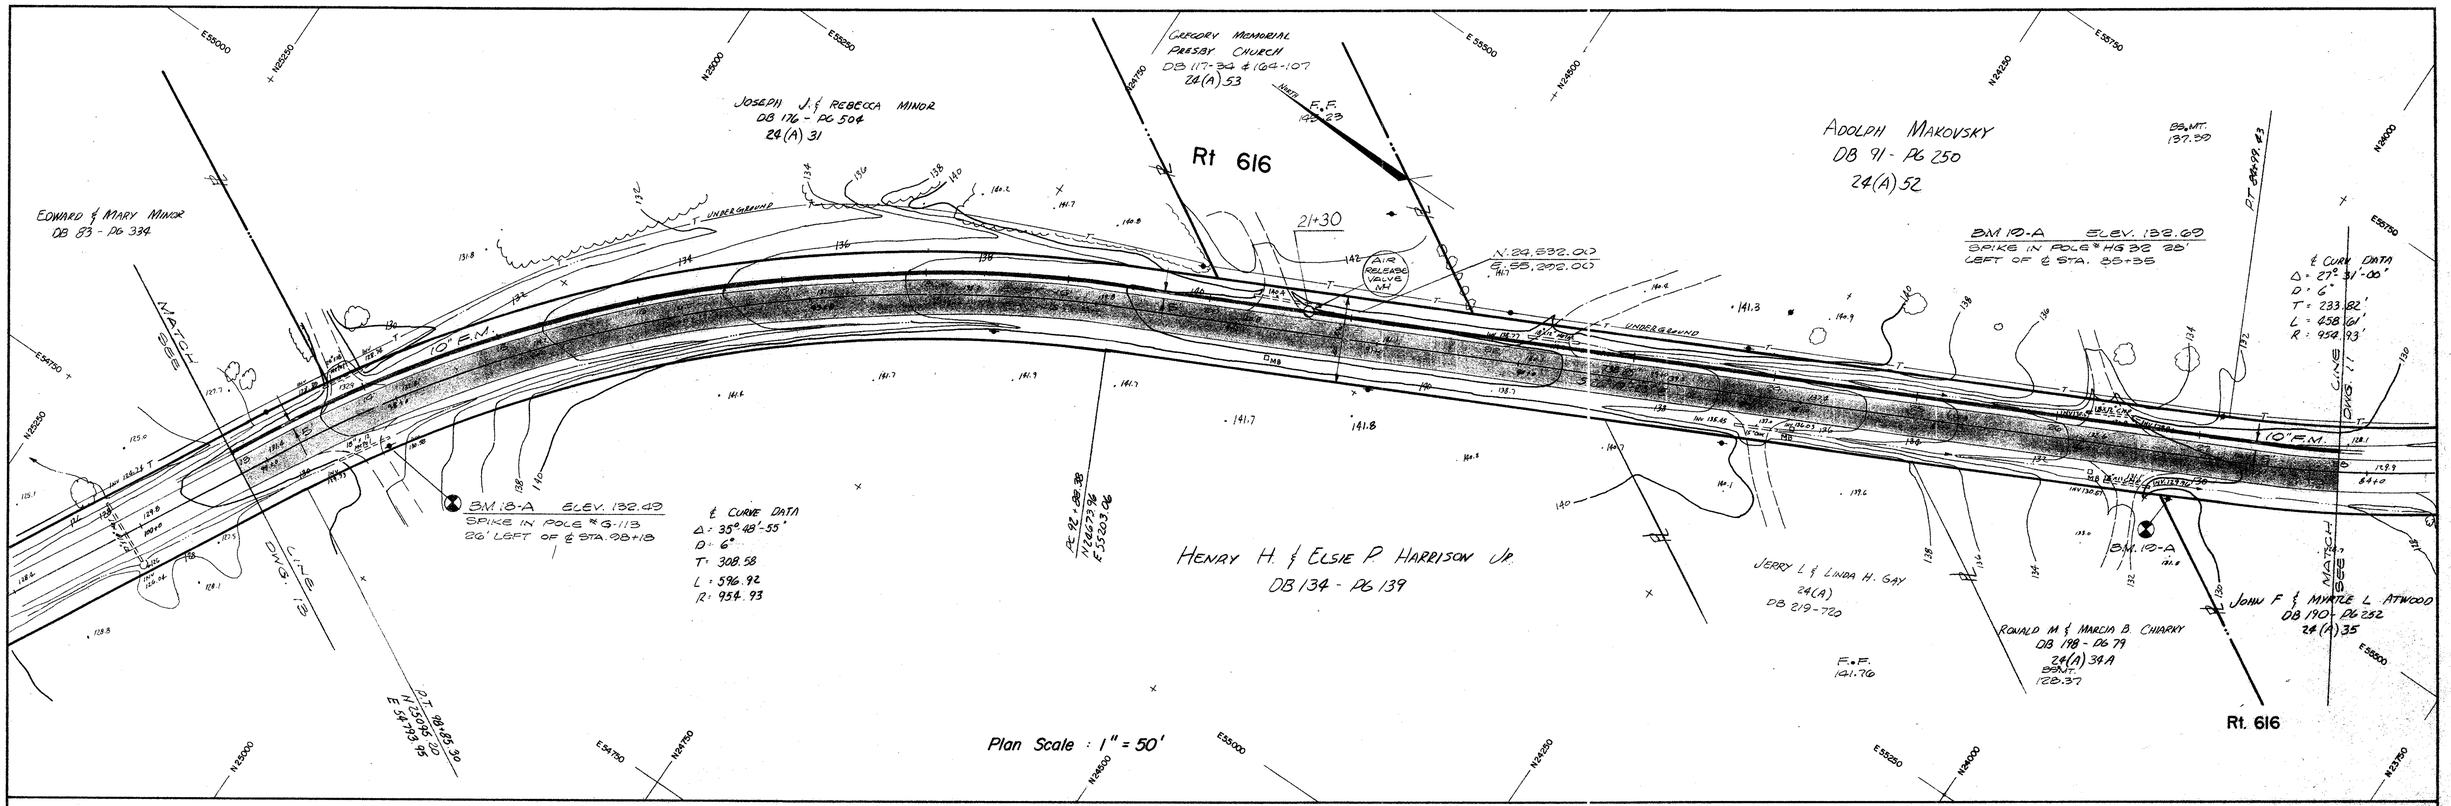

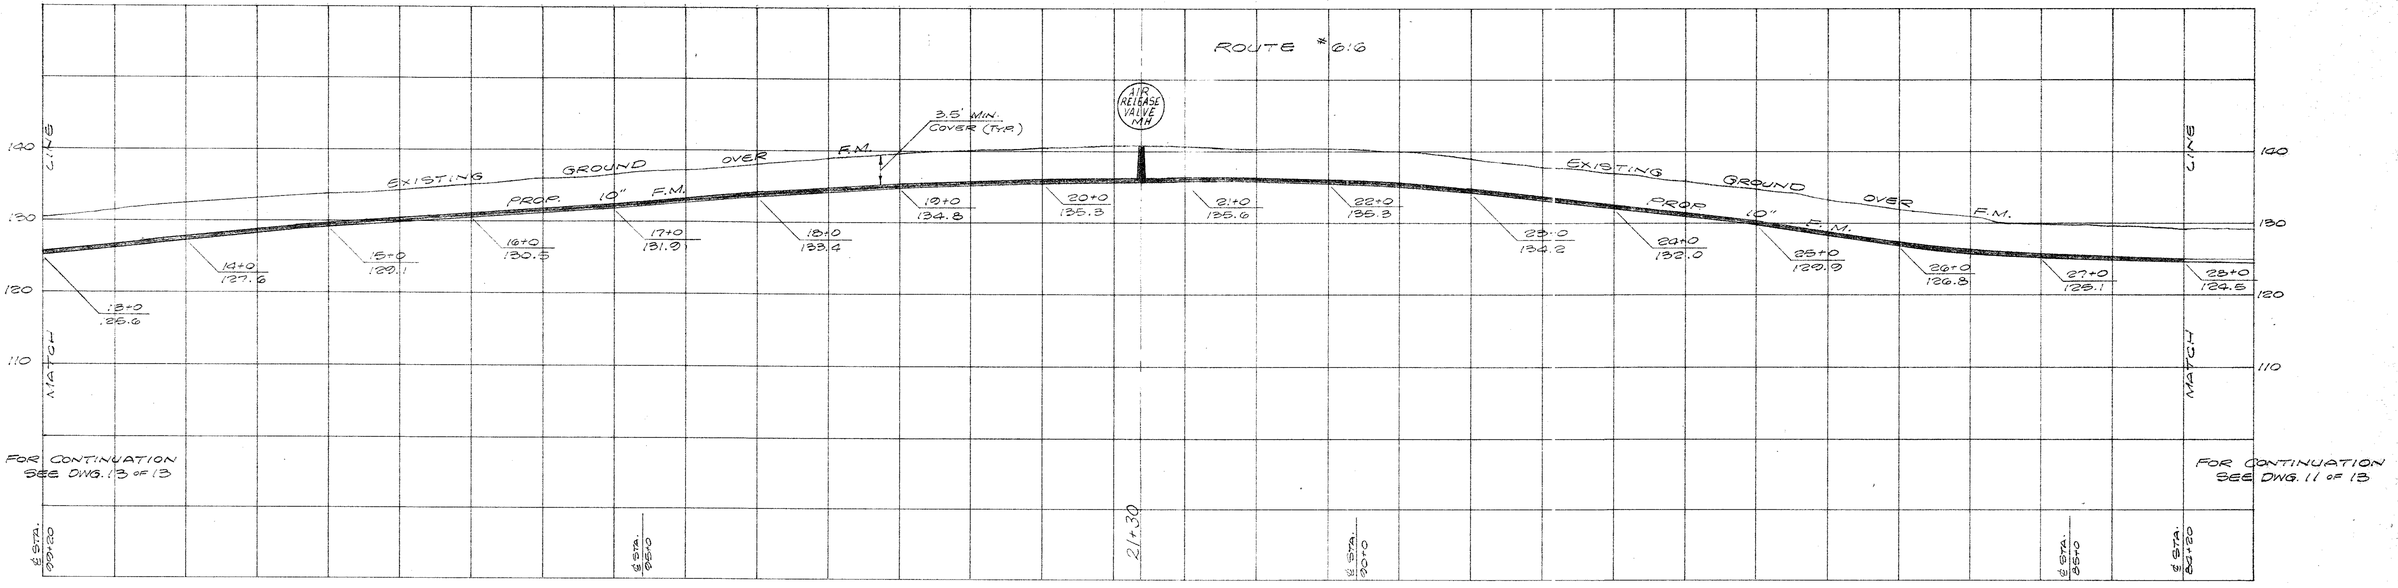

Profile Scales
Hor. 1" = 50'
Vert. 1" = 10'

AS BUILT.

Pritchard and Altman
Engineers and Surveyors
Hopewell, Virginia

No.	Date	Appr.	Revision	No.	Date	Appr.	Revision
1	11-15-76		Add Fl. Elev., Co-ord.				

Commonwealth of Virginia — John L. Combs — Certificate No. 6442 — Certified Professional Engineer

Checked	Date
Des. Eng.	
Proj. Eng.	
Proj. Mgr.	
Approved	
Approved	

SUB-1 Contract-2
PRINCE GEORGE COUNTY, VIRGINIA
UPPER BLACKWATER WASTEWATER COLLECTION SYSTEM
Route 616 - 10" Force Main Sta. 13+00 to Sta. 28+00

ROY F. WESTON
Environmental Scientists and Engineers
Lewis Lane • West Chester • Pennsylvania • 19380

Prepared by	Date	Scale	W. O. No.	Dwg. No.
Maryland Office	Aug. 1976	As Noted	1535-01	12 of 13

Drawn

Sheet No.