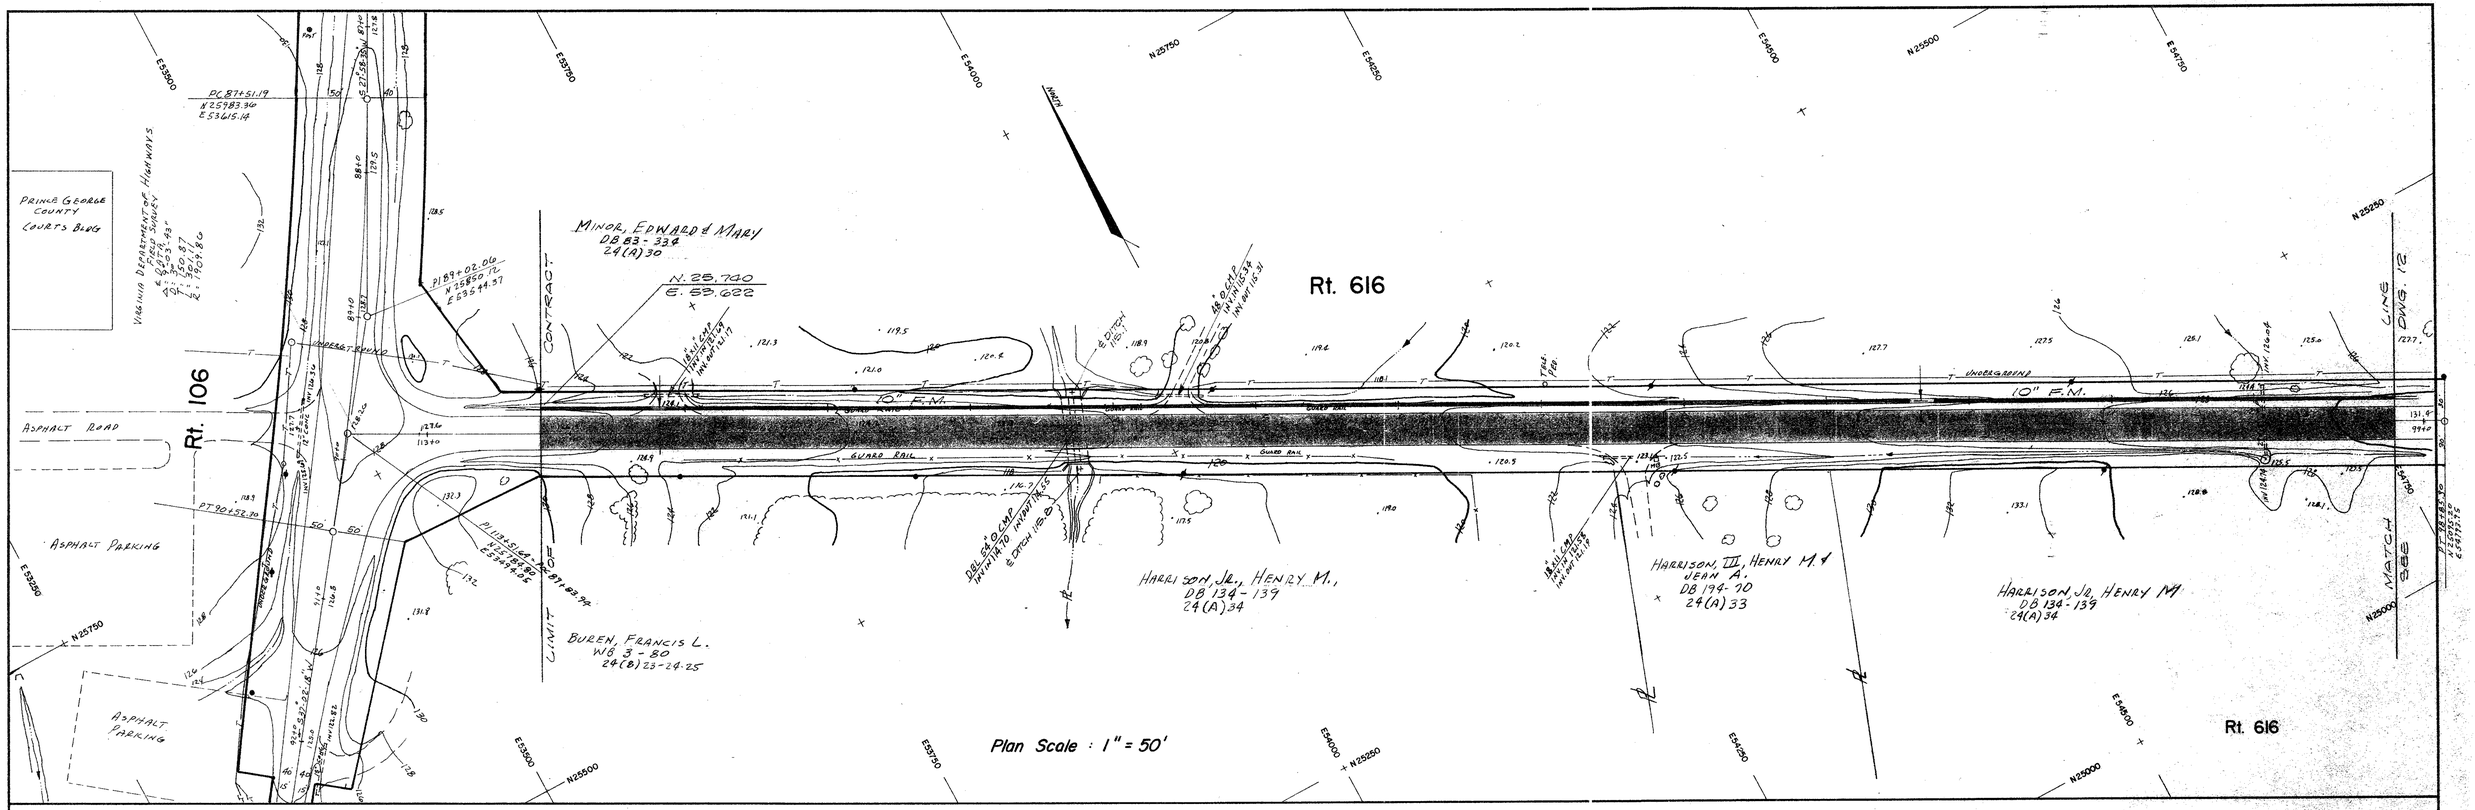

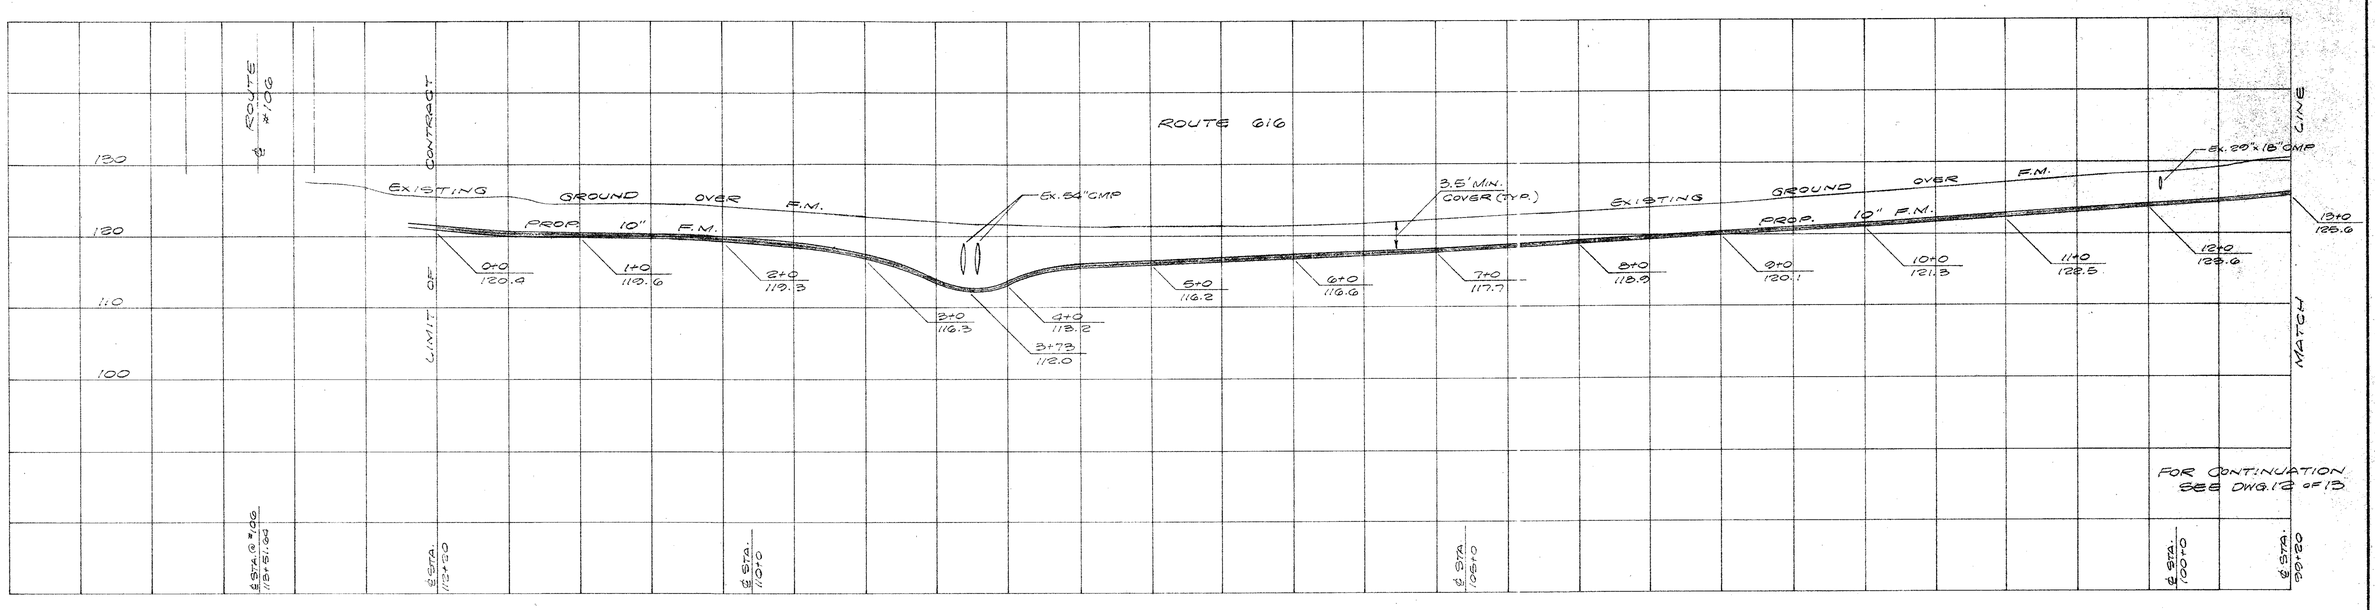

PROFILE SCALES
HOR. 1" = 50'
VERT. 1" = 10'

AS BUILT

PRITCHARD AND ALTMAN
Engineers and Surveyors
Hopewell, Virginia

NO.	DATE	APPR.	REVISION	NO.	DATE	APPR.	REVISION

COMMONWEALTH OF VIRGINIA
JOHN L. COMBS
CERTIFICATE No. 6442
CERTIFIED PROFESSIONAL ENGINEER

	CHECKED	DATE
DES. ENG.	JFA	8-76
PROJ. ENG.		
PROJ. MGR.	KPR	8-76
APPROVED		
APPROVED		

SUB-1 Contract-2
PRINCE GEORGE COUNTY, VIRGINIA
UPPER BLACKWATER WASTEWATER COLLECTION SYSTEM
Route 616 - 10" Force Main Sta. 0+00 to Sta. 13+00

ROY F. WESTON
ENVIRONMENTAL SCIENTISTS AND ENGINEERS
LEWIS LANE ▪ WEST CHESTER ▪ PENNSYLVANIA ▪ 19380

PREPARED BY	DATE	SCALE	W. O. NO.	DWG. NO.
MARYLAND OFFICE				13 OF 13
DRAWN GTR	AUG. 1976	AS NOTED	1535-01	

SHEET NO.