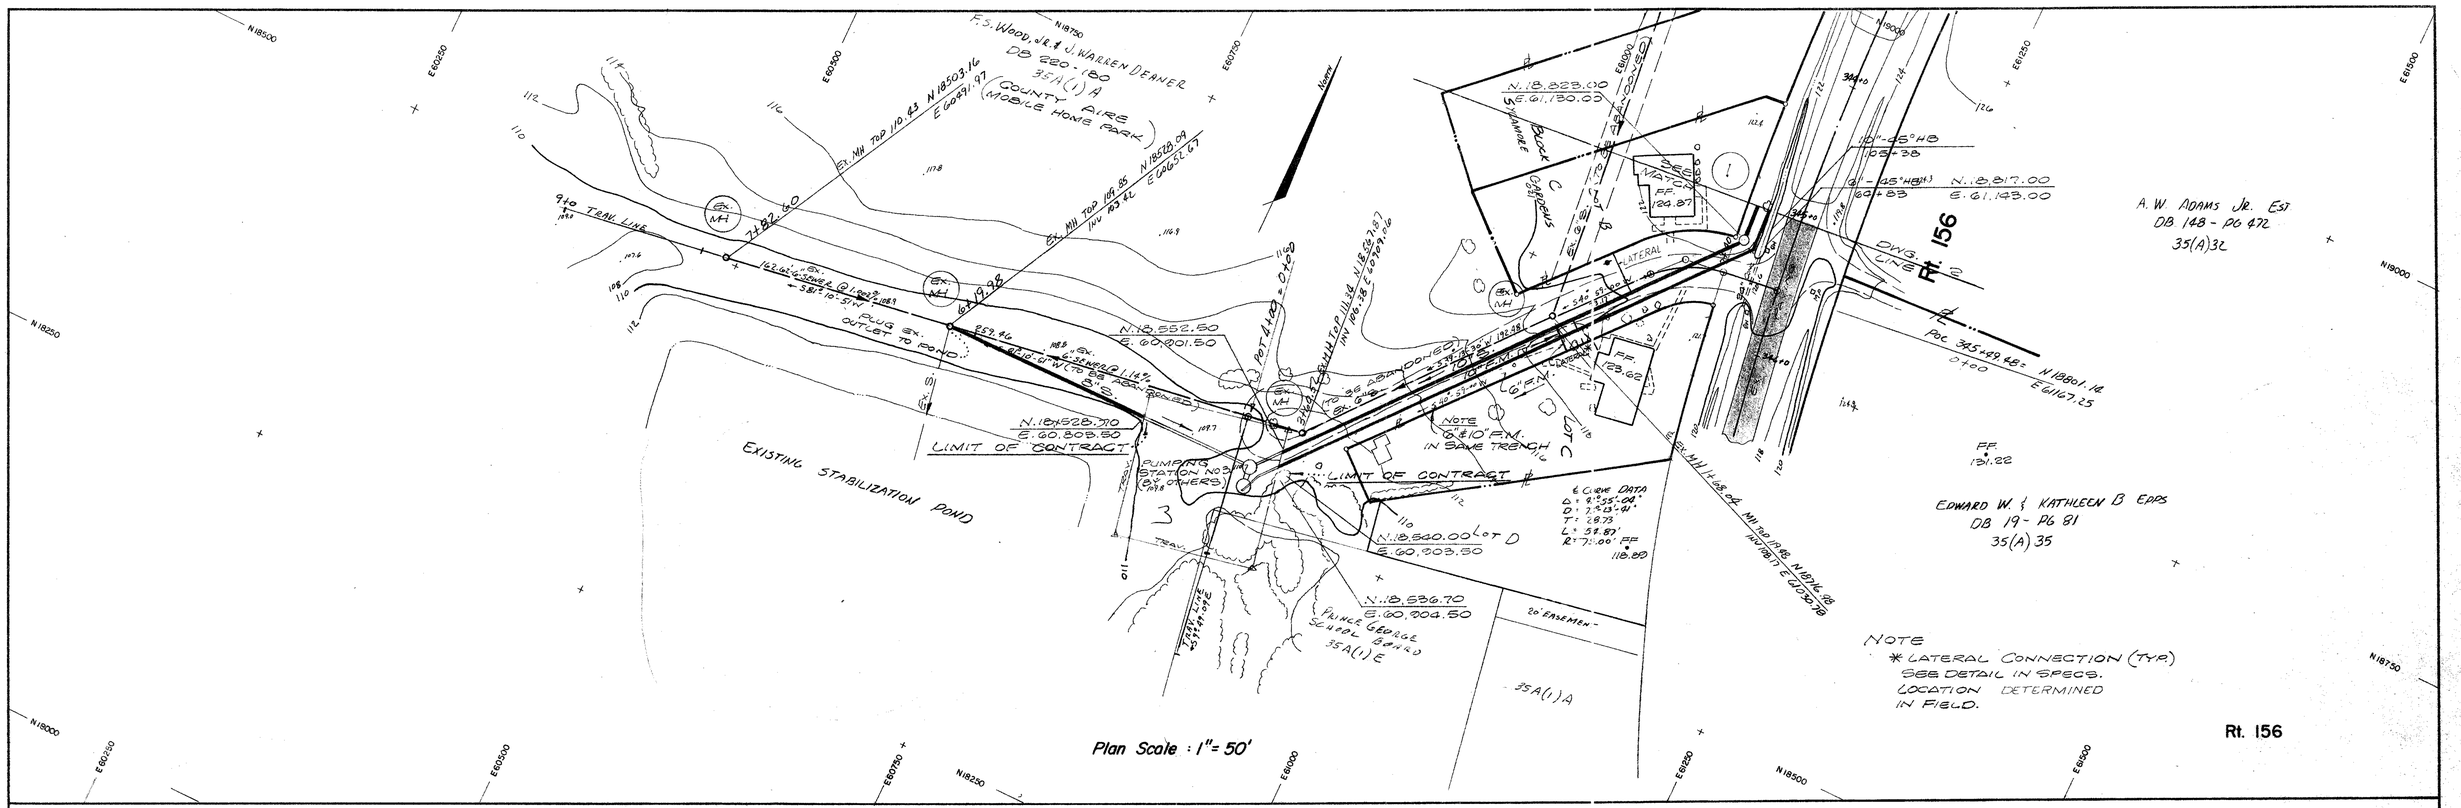

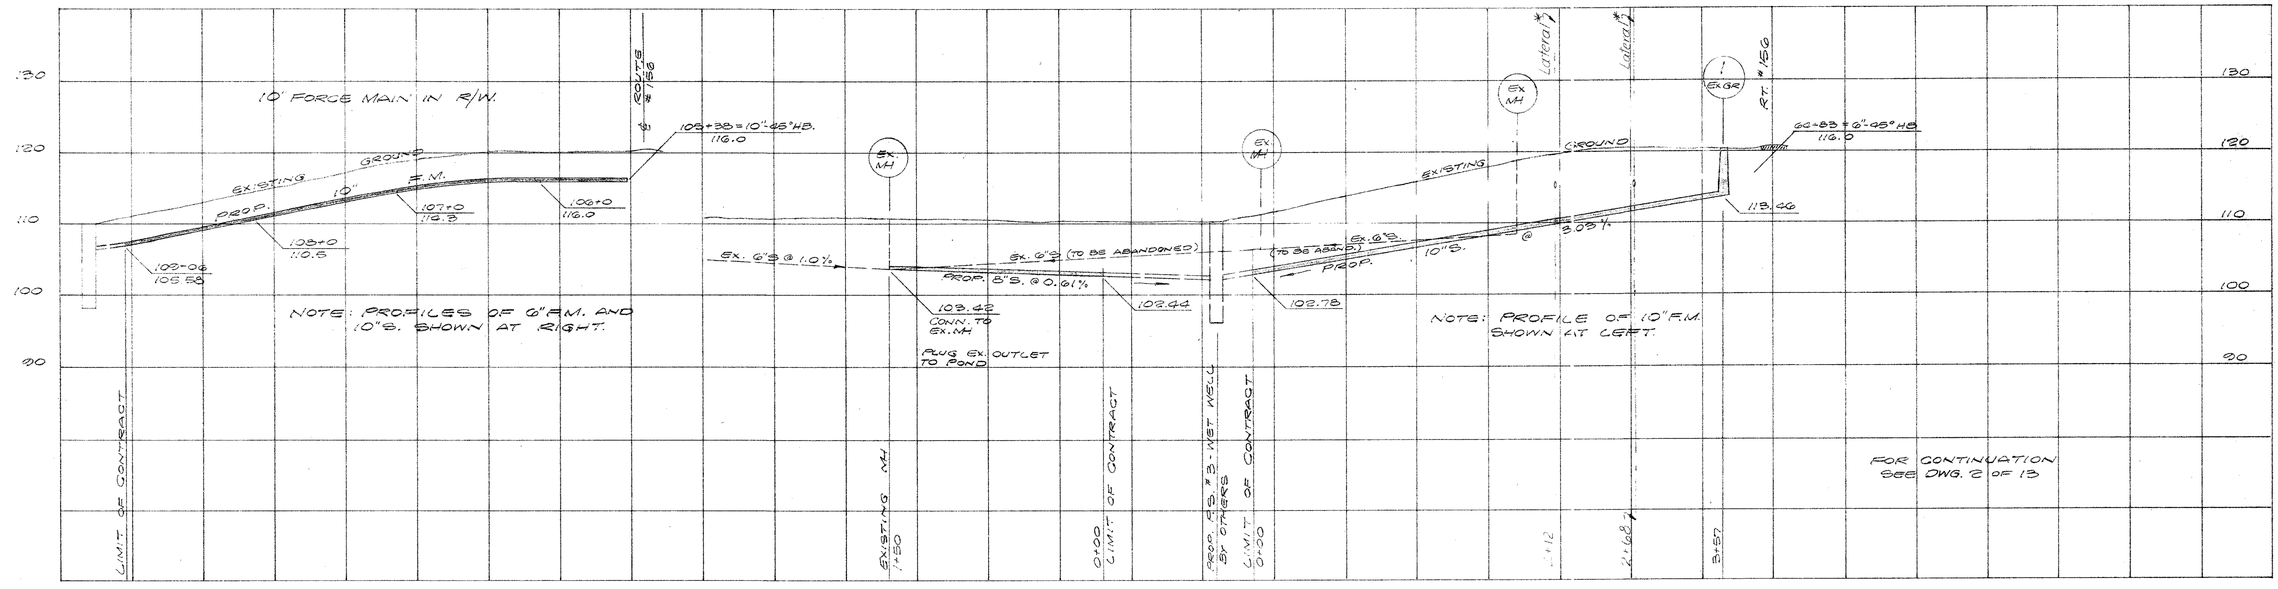

AS BUILT

PRITCHARD AND ALTMAN
Engineers and Surveyors
Hopewell, Virginia

NO.	DATE	APPR.	REVISION	NO.	DATE	APPR.	REVISION
1	9-15-76		Revise Stations Vicinity Pump Station				
2	11-15-76		CO-ORD, FF. ELEV, N.80.				
3	2-15-77		Delete 6" Force Main				

COMMONWEALTH OF VIRGINIA — JOHN L. COMBS — CERTIFICATE No. 6442 — CERTIFIED PROFESSIONAL ENGINEER

	CHECKED	DATE
DES. ENG.		
PROJ. ENG.		
PROJ. MGR.		
APPROVED		
APPROVED		

SUB-1 Contract-2
PRINCE GEORGE COUNTY, VIRGINIA
UPPER BLACKWATER WASTEWATER COLLECTION SYSTEM
Route 156 & Easmt. 6", 10" Force Main - 8", 10" San. Sewer

ROY F. WESTON
ENVIRONMENTAL SCIENTISTS AND ENGINEERS
LEWIS LANE • WEST CHESTER • PENNSYLVANIA • 19380

PREPARED BY	DATE	SCALE	W. O. NO.	DWG. NO.
MARYLAND OFFICE	AUG. 1976	AS NOTED	1535-01	1 OF 13