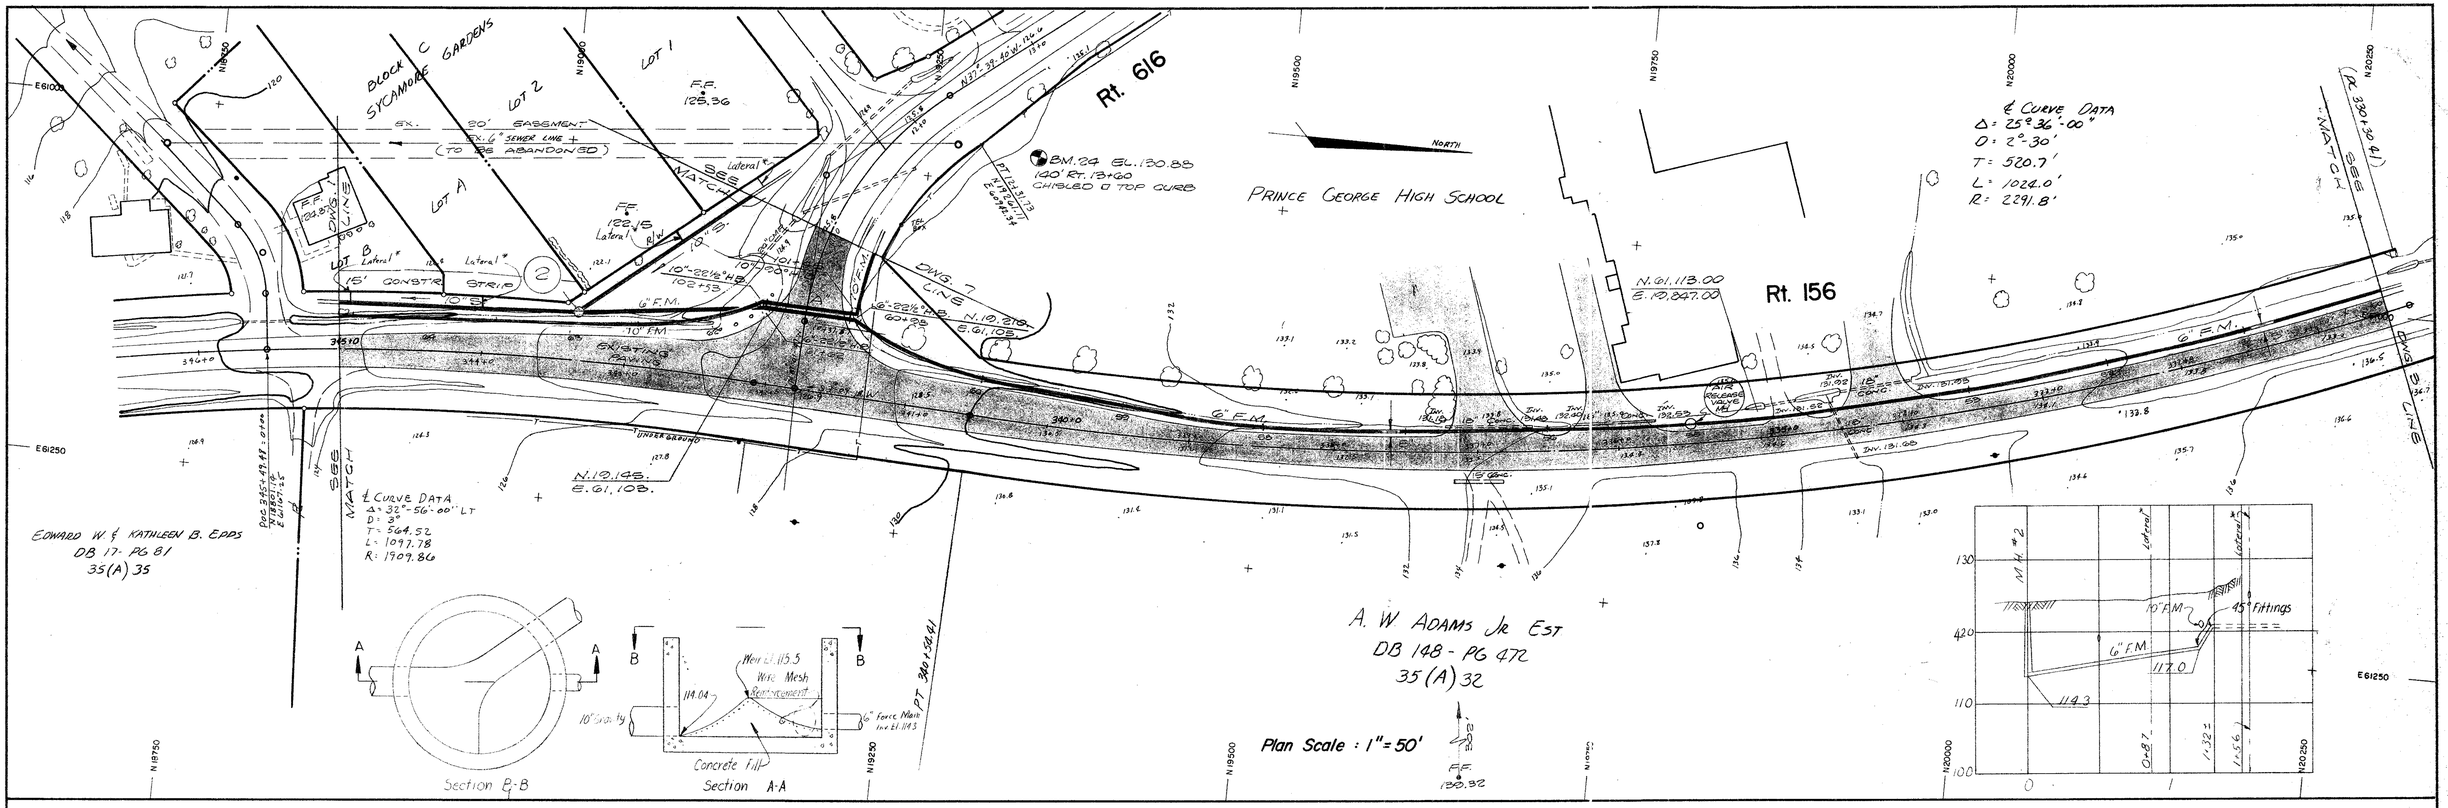

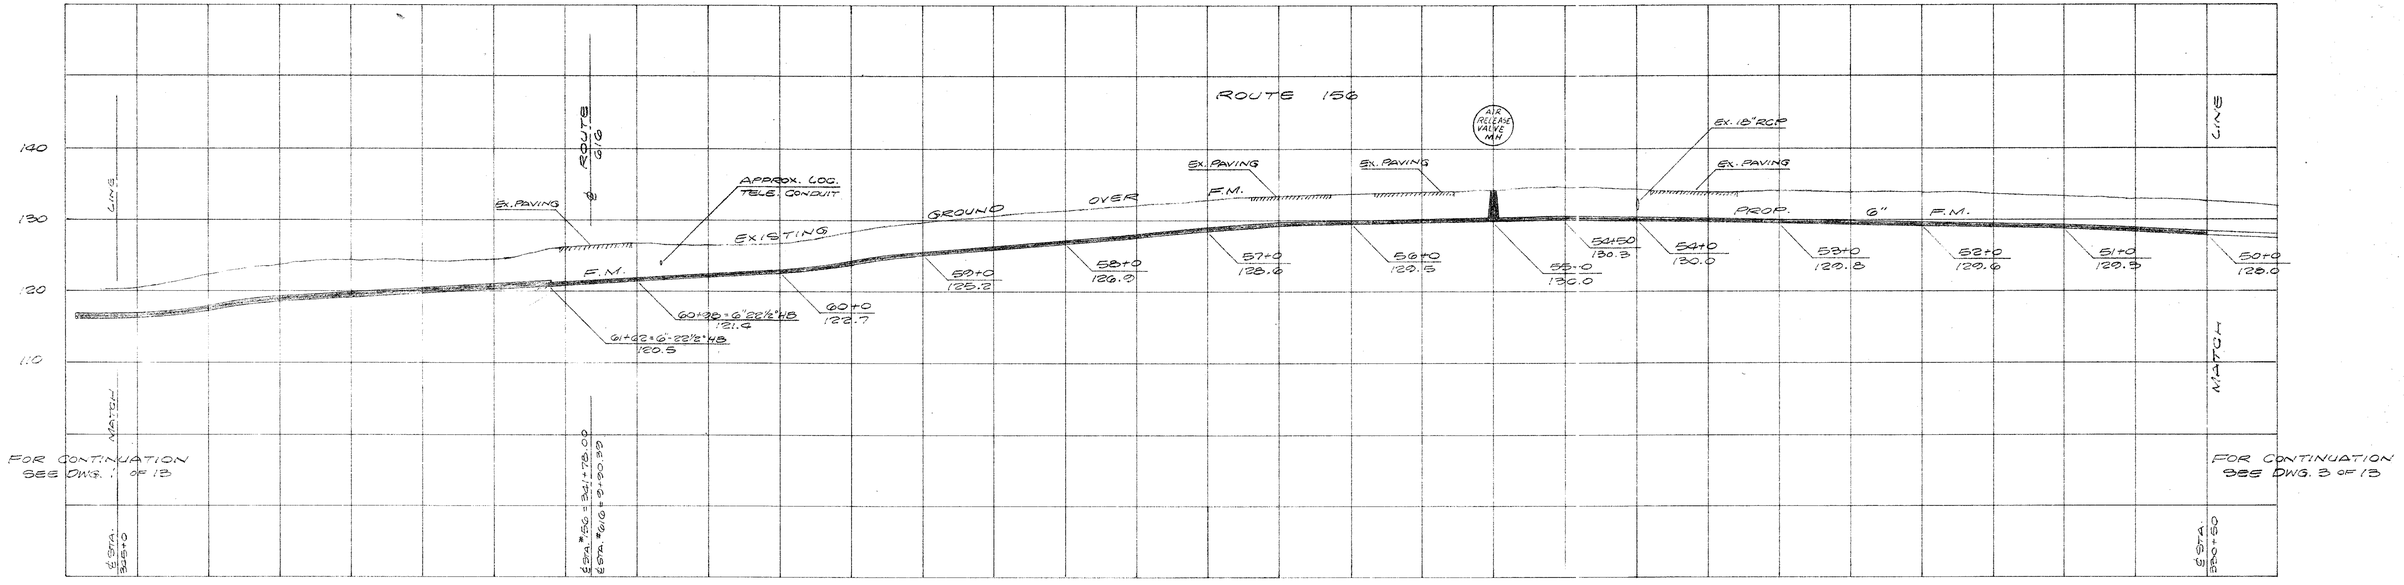

PROFILE SCALES
HOR. 1" = 50'
VERT. 1" = 10'

AS BUILT

PRITCHARD AND ALTMAN
Engineers and Surveyors
Hopewell, Virginia

NO.	DATE	APPR.	REVISION	NO.	DATE	APPR.	REVISION
1	9-15-76		Add laterals Lots 1, 2, A, and B				
2	11-15-76		HWY CROSSING, CO-ORD., B.M. #24				
3	2-15-77		Relocate 6" Force Main, Modify M.H. #2				

COMMONWEALTH OF VIRGINIA
JOHN L. COMBS
CERTIFICATE No. 6442
CERTIFIED PROFESSIONAL ENGINEER

CHECKED	DATE
DES. ENG.	
PROJ. ENG.	
PROJ. MGR.	
APPROVED	
APPROVED	

SUB-1 Contract-2
PRINCE GEORGE COUNTY, VIRGINIA
UPPER BLACKWATER WASTEWATER COLLECTION SYSTEM
Route 156 - 6" Force Main Sta. 50+00 to Sta. 64+94

ROY F. WESTON
ENVIRONMENTAL SCIENTISTS AND ENGINEERS
LEWIS LANE • WEST CHESTER • PENNSYLVANIA • 19380

PREPARED BY	DWG. NO.
MARYLAND OFFICE	2 OF 13

DRAWN	DATE	SCALE	W.O. NO.
	AUG. 1976	AS NOTED	1535-01

SHEET NO.