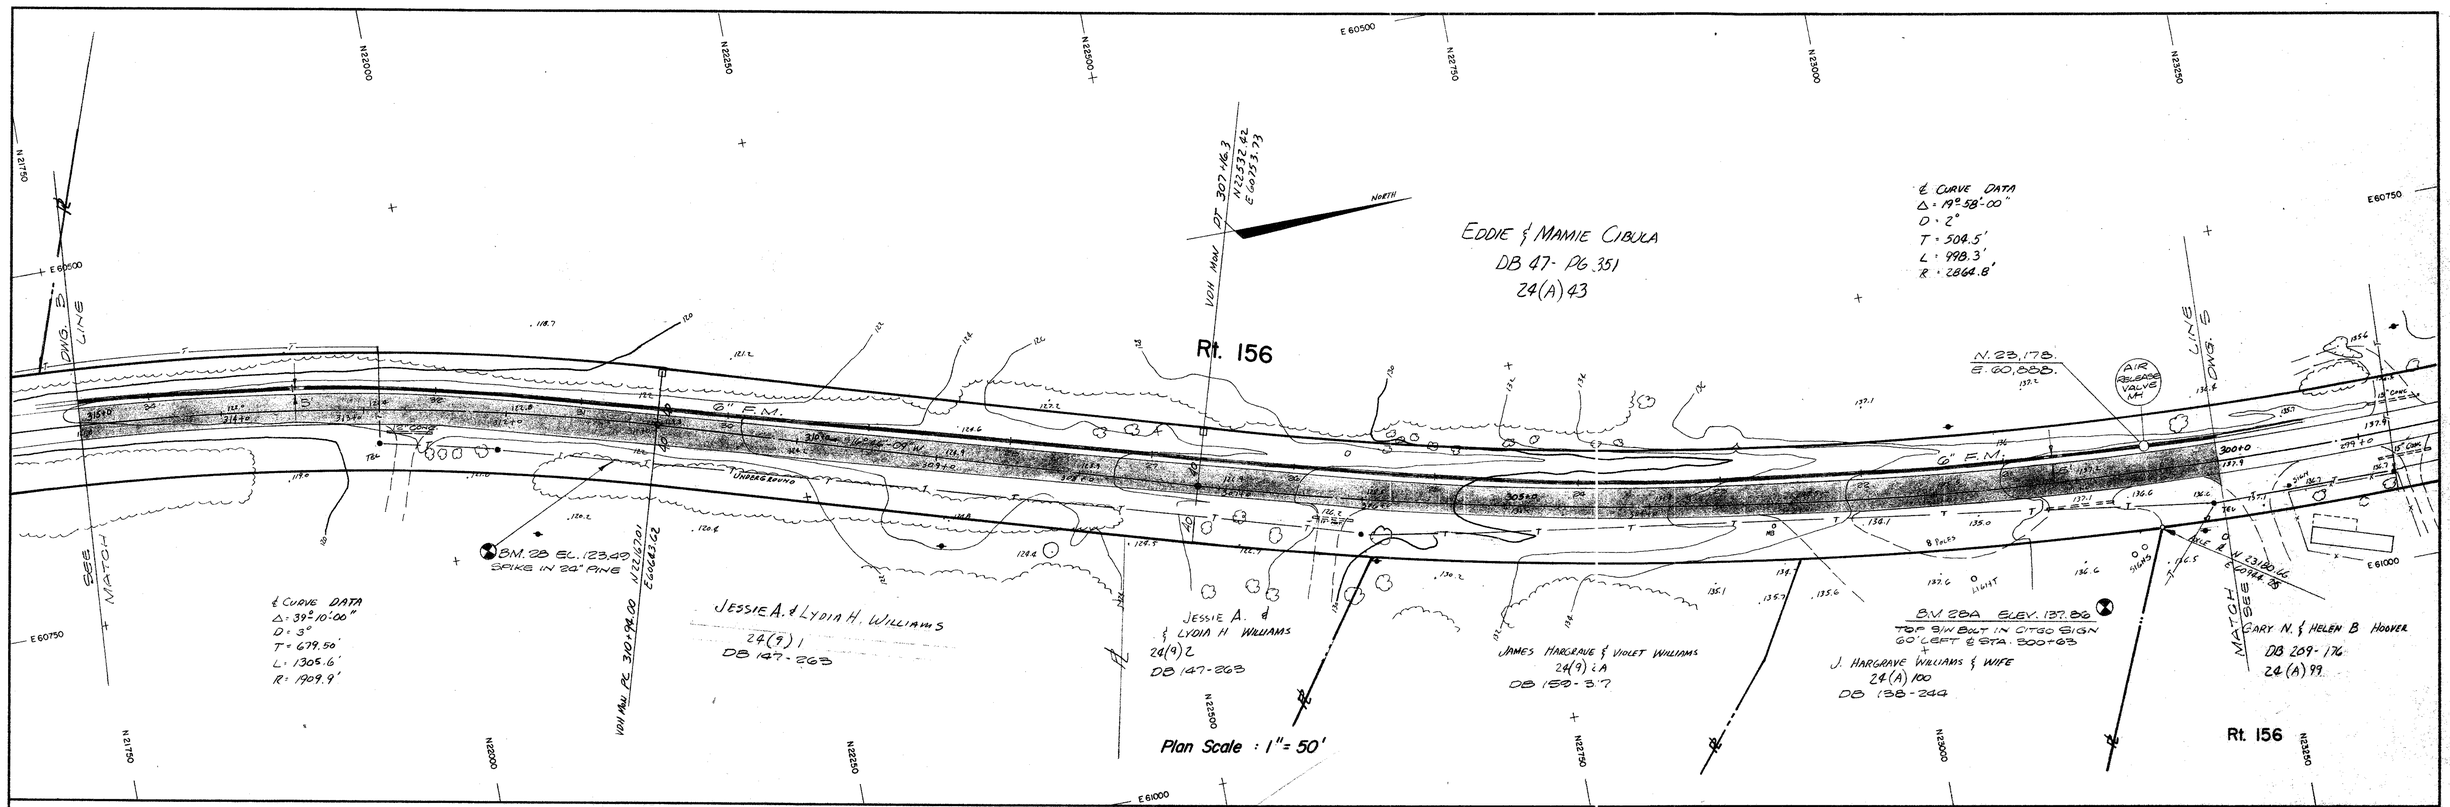

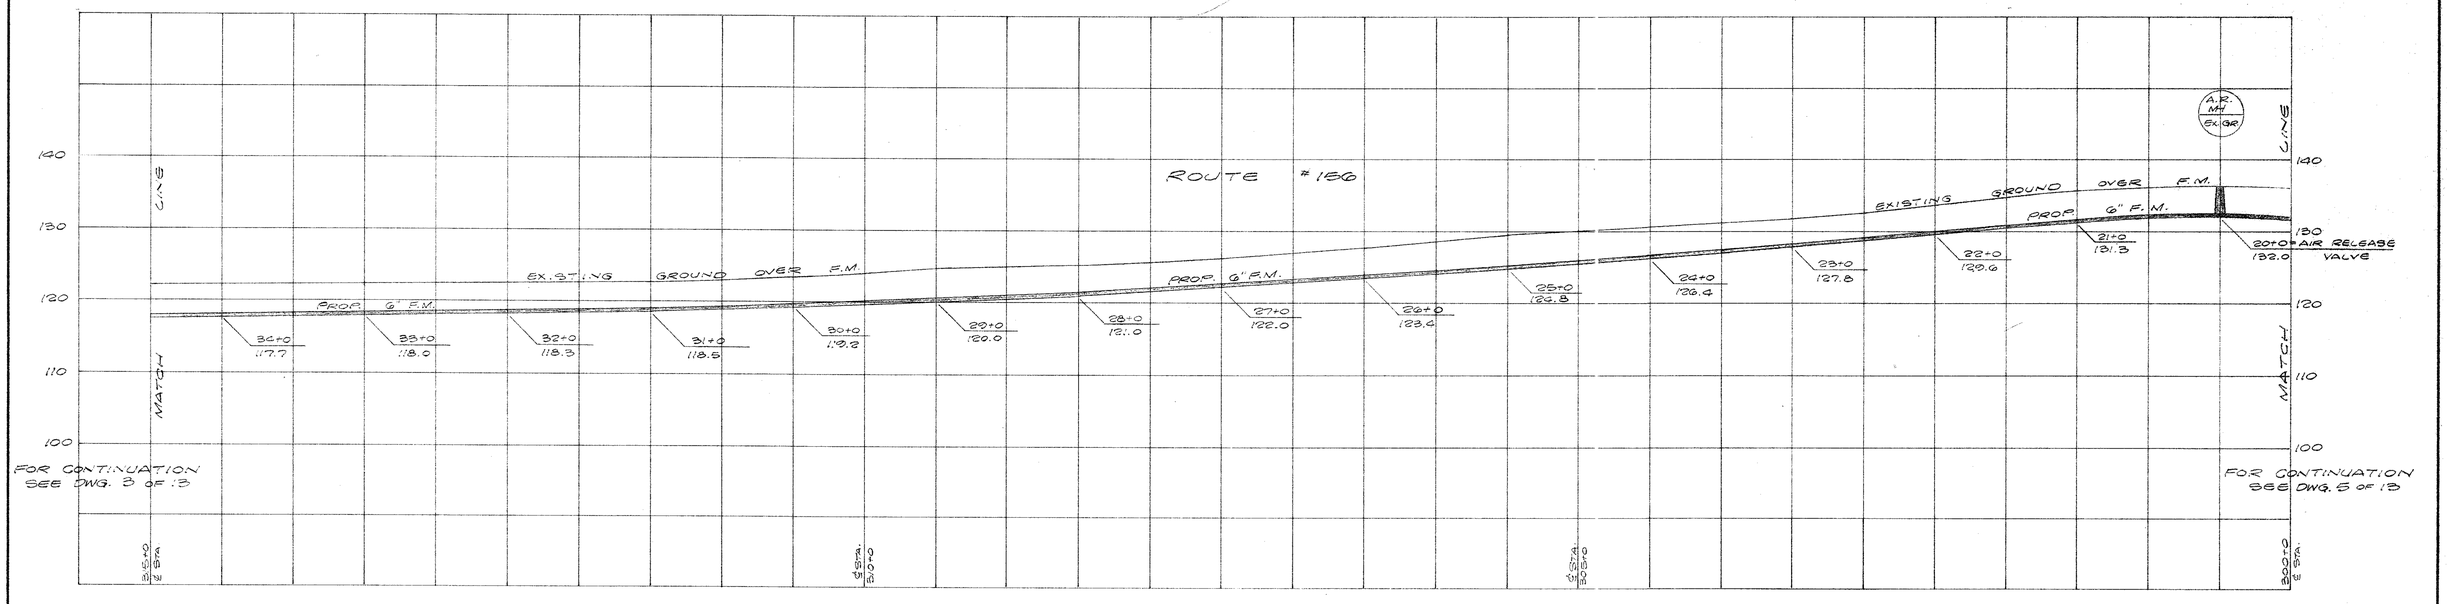

PROFILE SCALES
HOR. 1" = 50'
VERT. 1" = 10'

AS BUILT.

PRITCHARD AND ALTMAN
Engineers and Surveyors
Hopewell, Virginia

NO.	DATE	APPR.	REVISION	NO.	DATE	APPR.	REVISION
1	11-15-76		B.M. 28, Co-ORD.				

COMMONWEALTH OF VIRGINIA
JOHN L. COMBS
CERTIFICATE No. 6442
CERTIFIED PROFESSIONAL ENGINEER

	CHECKED	DATE
DES. ENG.		
PROJ. ENG.		
PROJ. MGR.		
APPROVED		
APPROVED		

SUB-1 Contract-2
PRINCE GEORGE COUNTY, VIRGINIA
UPPER BLACKWATER WASTEWATER COLLECTION SYSTEM
Route 156 - 6" Force Main Sta. 19+50 to Sta. 34+50

ROY F. WESTON
ENVIRONMENTAL SCIENTISTS AND ENGINEERS
LEWIS LANE • WEST CHESTER • PENNSYLVANIA • 19380

PREPARED BY	DATE	SCALE	W. O. NO.	DWG. NO.
MARYLAND OFFICE	AUG. 1976	AS NOTED	1535-01	4 OF 13

DRAWN

SHEET NO.