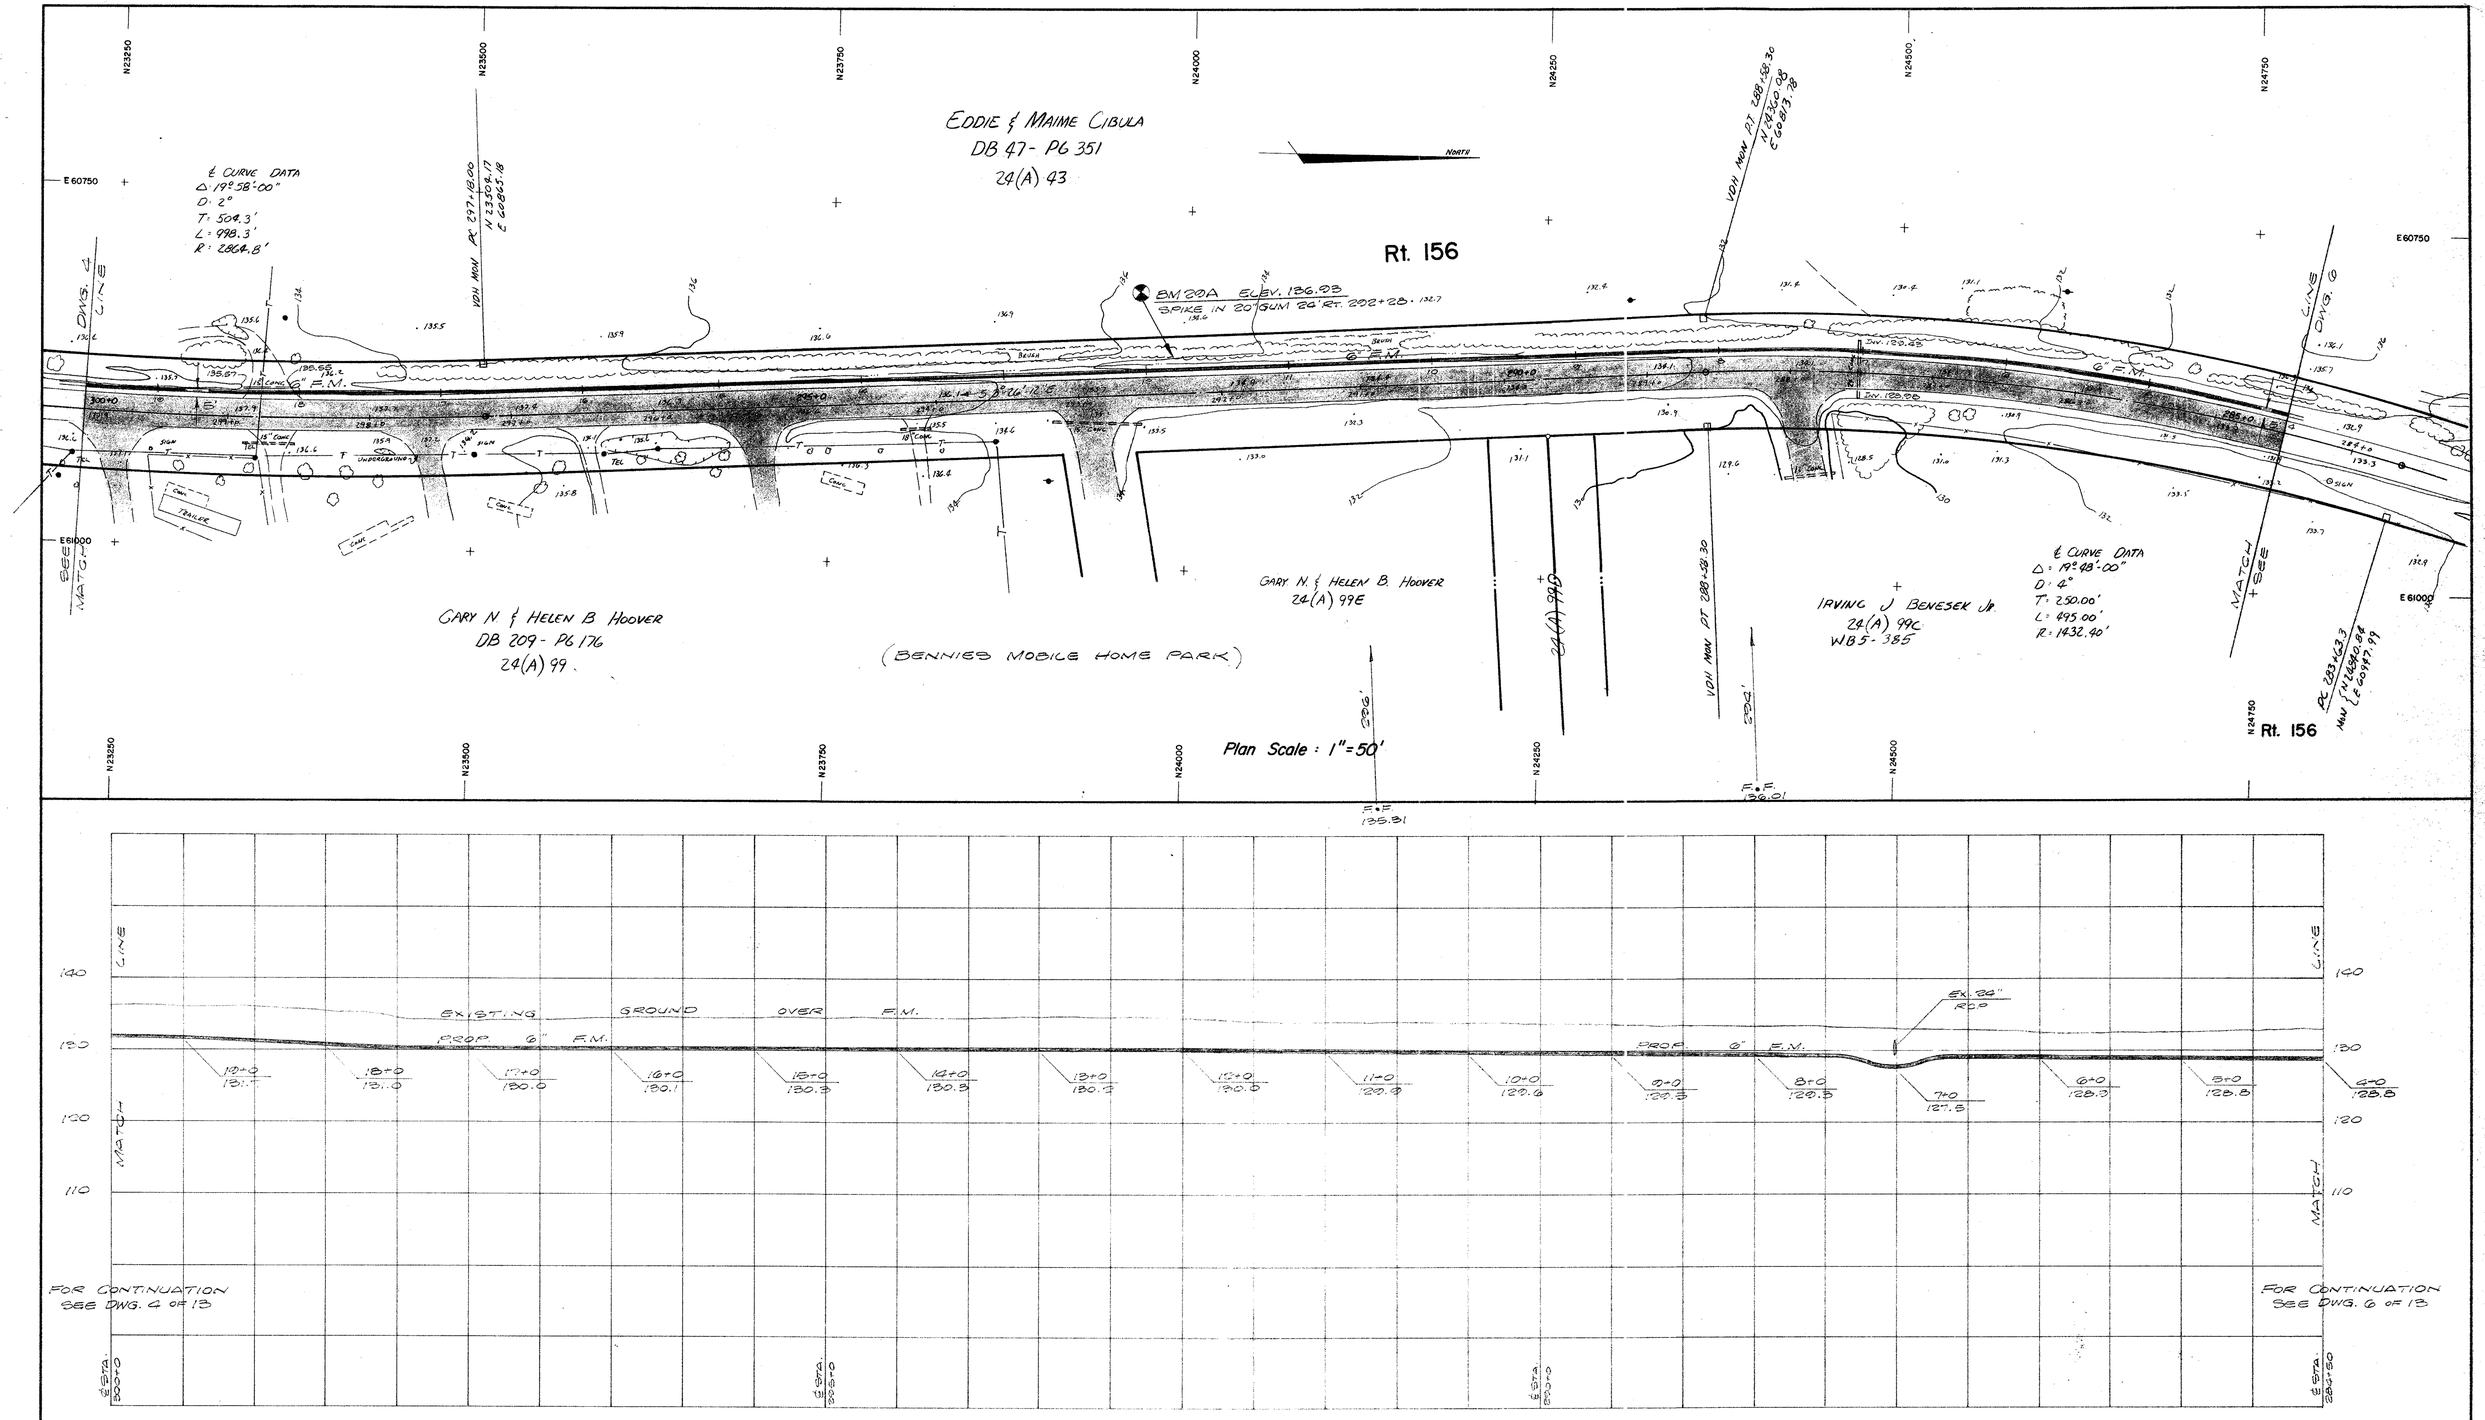

PROFILE SCALE
HOR. 1"=50'
VERT. 1"=5'

AS BUILT

PRITCHARD AND ALTMAN
Engineers and Surveyors
Hopewell, Virginia

NO.	DATE	APPR.	REVISION	NO.	DATE	APPR.	REVISION
1	11-15-76		ADD F.F. ELEV.				

COMMONWEALTH OF VIRGINIA
JOHN L. COMBS
CERTIFICATE No. 6442
CERTIFIED PROFESSIONAL ENGINEER

CHECKED	DATE
DES. ENG.	
ASST. ENG.	
PROJ. MGR.	
DIVISION	
APPROVED	

SUB-1 Contract-2
PRINCE GEORGE COUNTY, VIRGINIA
UPPER BLACKWATER WASTEWATER COLLECTION SYSTEM
Route 156 - 6" Force Main Sta. 4+00 to Sta. 19+50

ROY F. WESTON
ENVIRONMENTAL SCIENTISTS AND ENGINEERS
LEWIS LANE • WEST CHESTER • PENNSYLVANIA • 19380

PREPARED BY				DWG. NO.
MARYLAND OFFICE				5 OF 13
DRAWN	DATE	SCALE	W. O. NO.	
GZ	AUG. 1976	AS NOTED	1535-01	

SHEET NO.