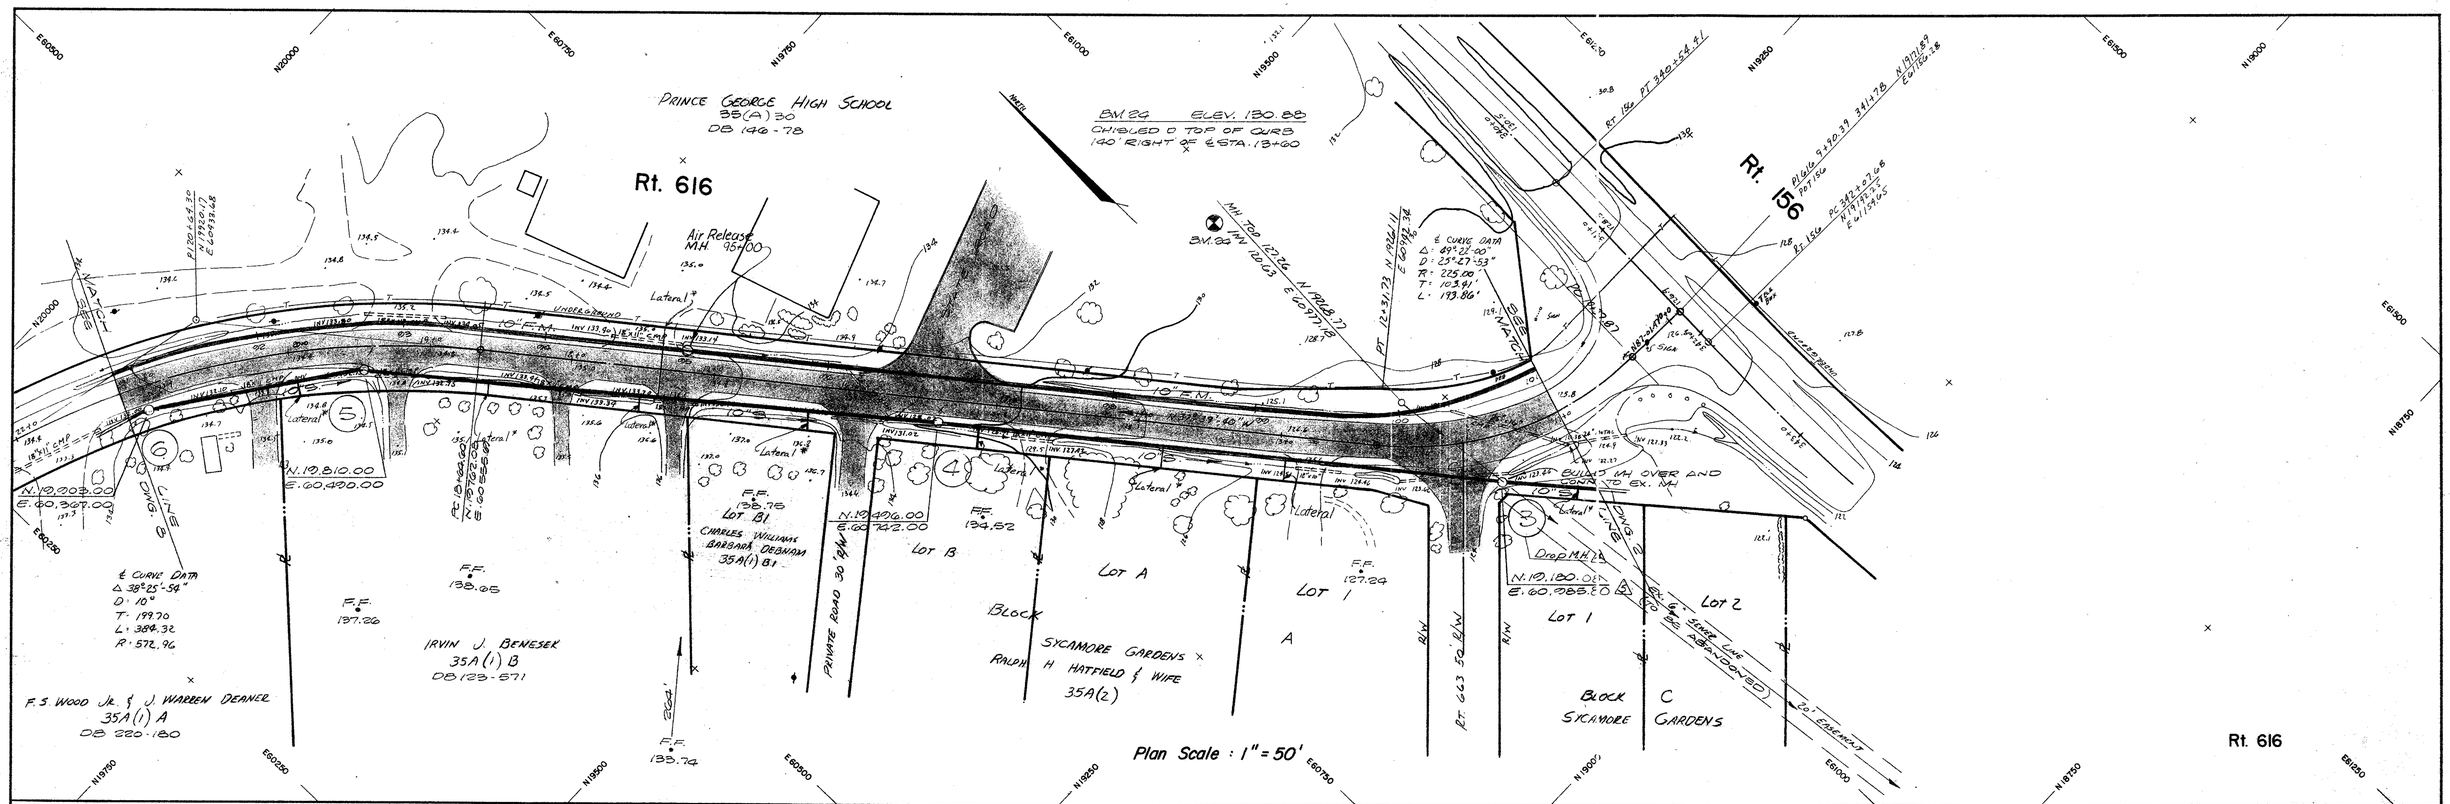

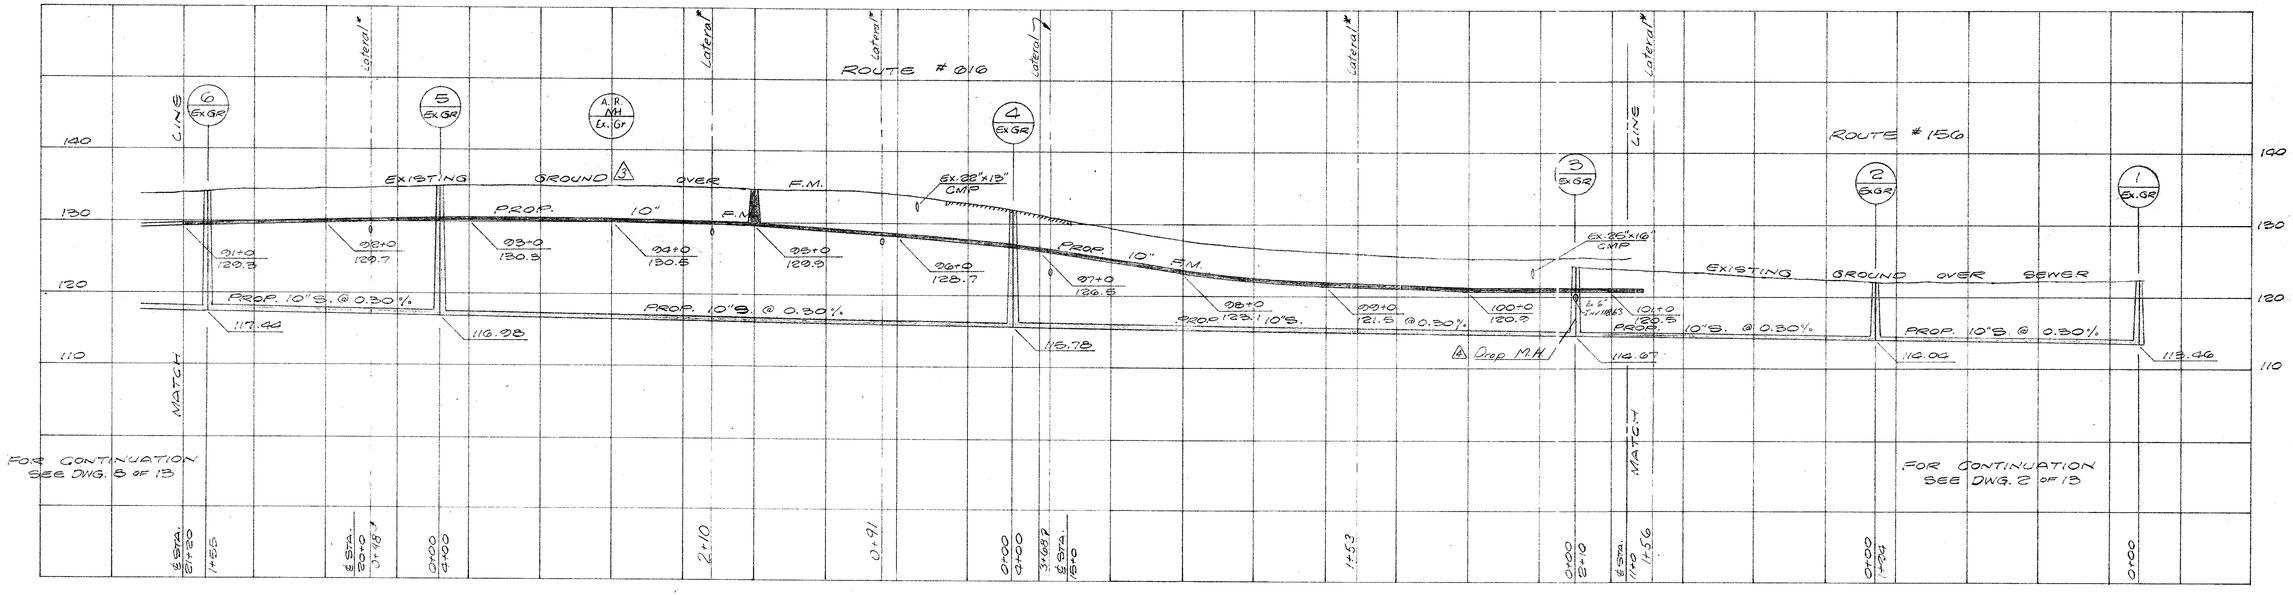

PROFILE SCALES
HOR. 1" = 50'
VERT. 1" = 10'

AS BUILT

PRITCHARD AND ALTMAN
Engineers and Surveyors
Hopewell, Virginia

NO.	DATE	APPR.	REVISION	NO.	DATE	APPR.	REVISION
1	9-15-76		Add laterals to all properties				
2	11-15-76		ADD FF. EL., CO-020.				
3	12-21-76		Add Air Release M.H.				
4	1-7-77		Drop M.H. in lieu Regular M.H. 3				
5	1-7-77		Revised coordinates of M.H. 3				

COMMONWEALTH OF VIRGINIA
JOHN L. COMBS
CERTIFICATE No. 6442
CERTIFIED PROFESSIONAL ENGINEER

		DATE
CHECKED		
DES. ENG.		
PROJ. ENG.		
PROJ. MGR.		
APPROVED		
APPROVED		

SUE-1 Contract-2
PRINCE GEORGE COUNTY, VIRGINIA
UPPER BLACKWATER WASTEWATER COLLECTION SYSTEM
Route 616 - 10" Force Main Sta. 91+00 to Sta. 101+00
10" San. Sewer M.H. 1 to M.H. 6

ROY F. WESTON
ENVIRONMENTAL SCIENTISTS AND ENGINEERS
LEWIS LANE ▪ WEST CHESTER ▪ PENNSYLVANIA ▪ 19380

PREPARED BY: MARYLAND OFFICE
DRAWN: GFA
DATE: AUG. 1976
SCALE: AS NOTED
W. O. NO.: 1535-01
DWG. NO.: 7 OF 13

SHEET NO.