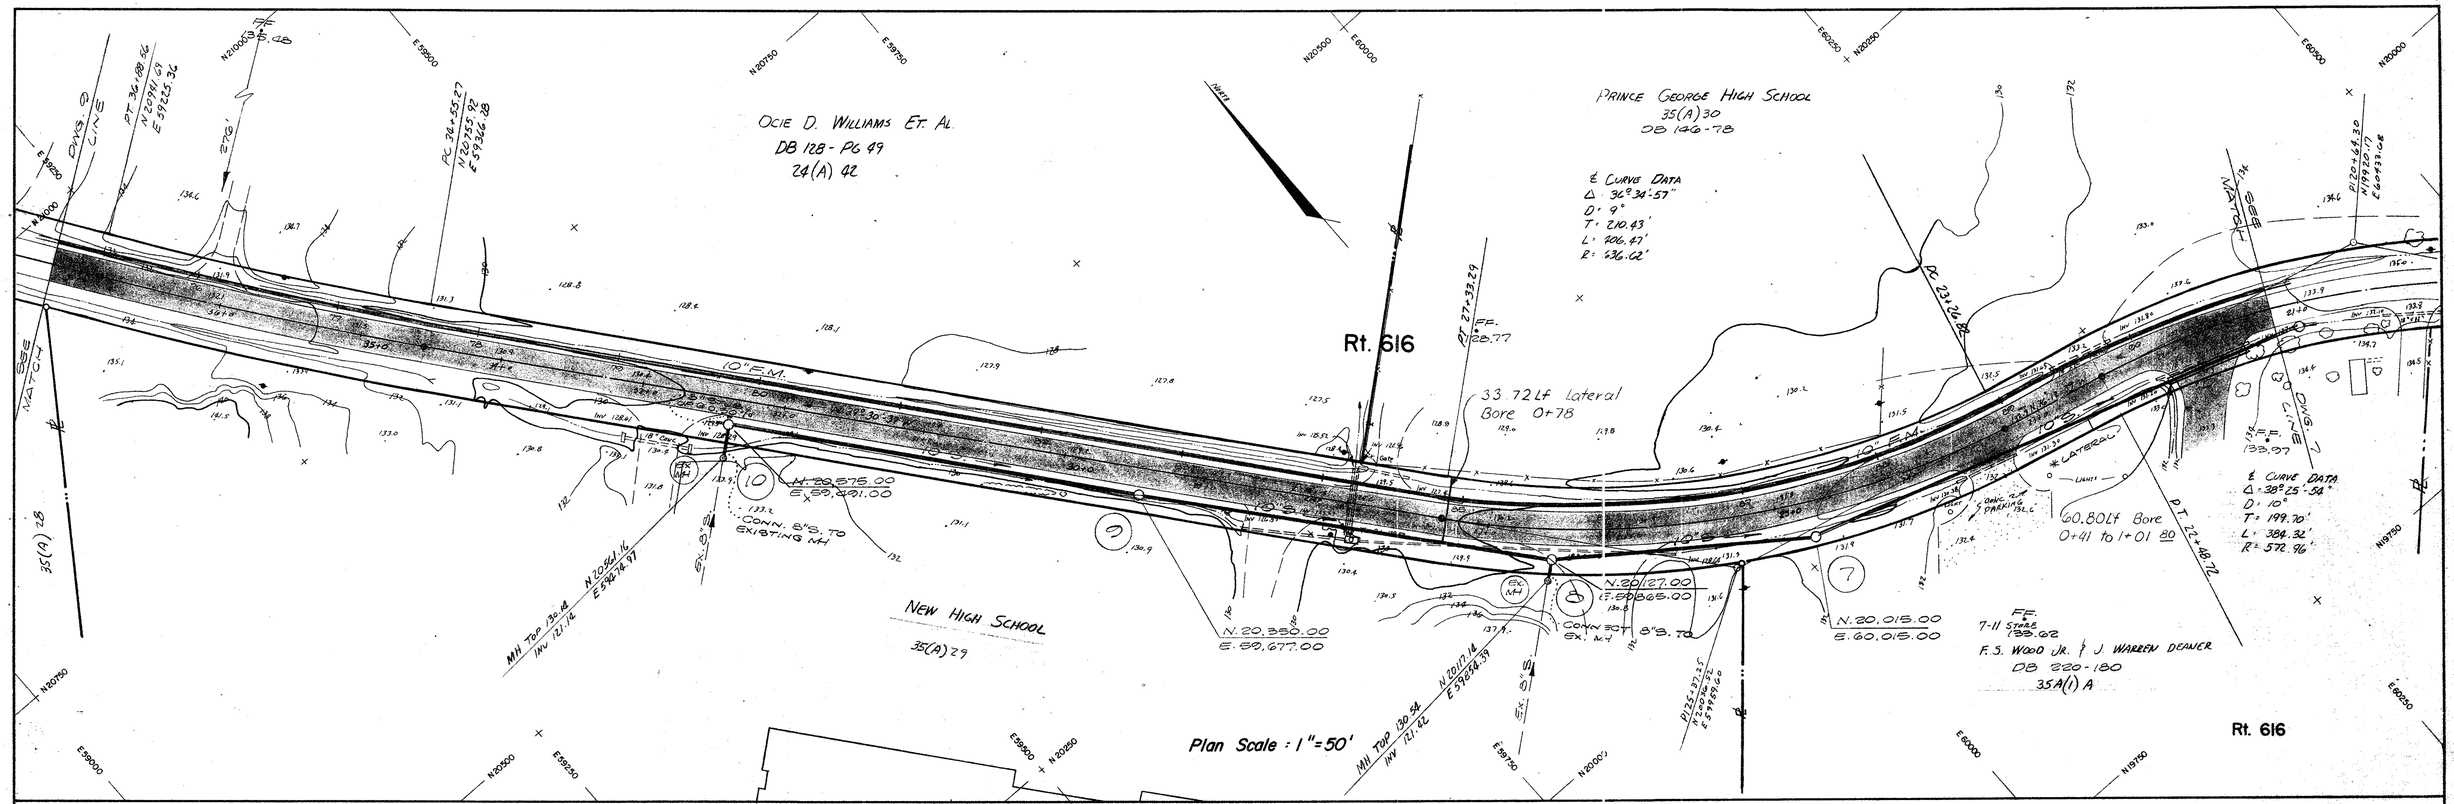

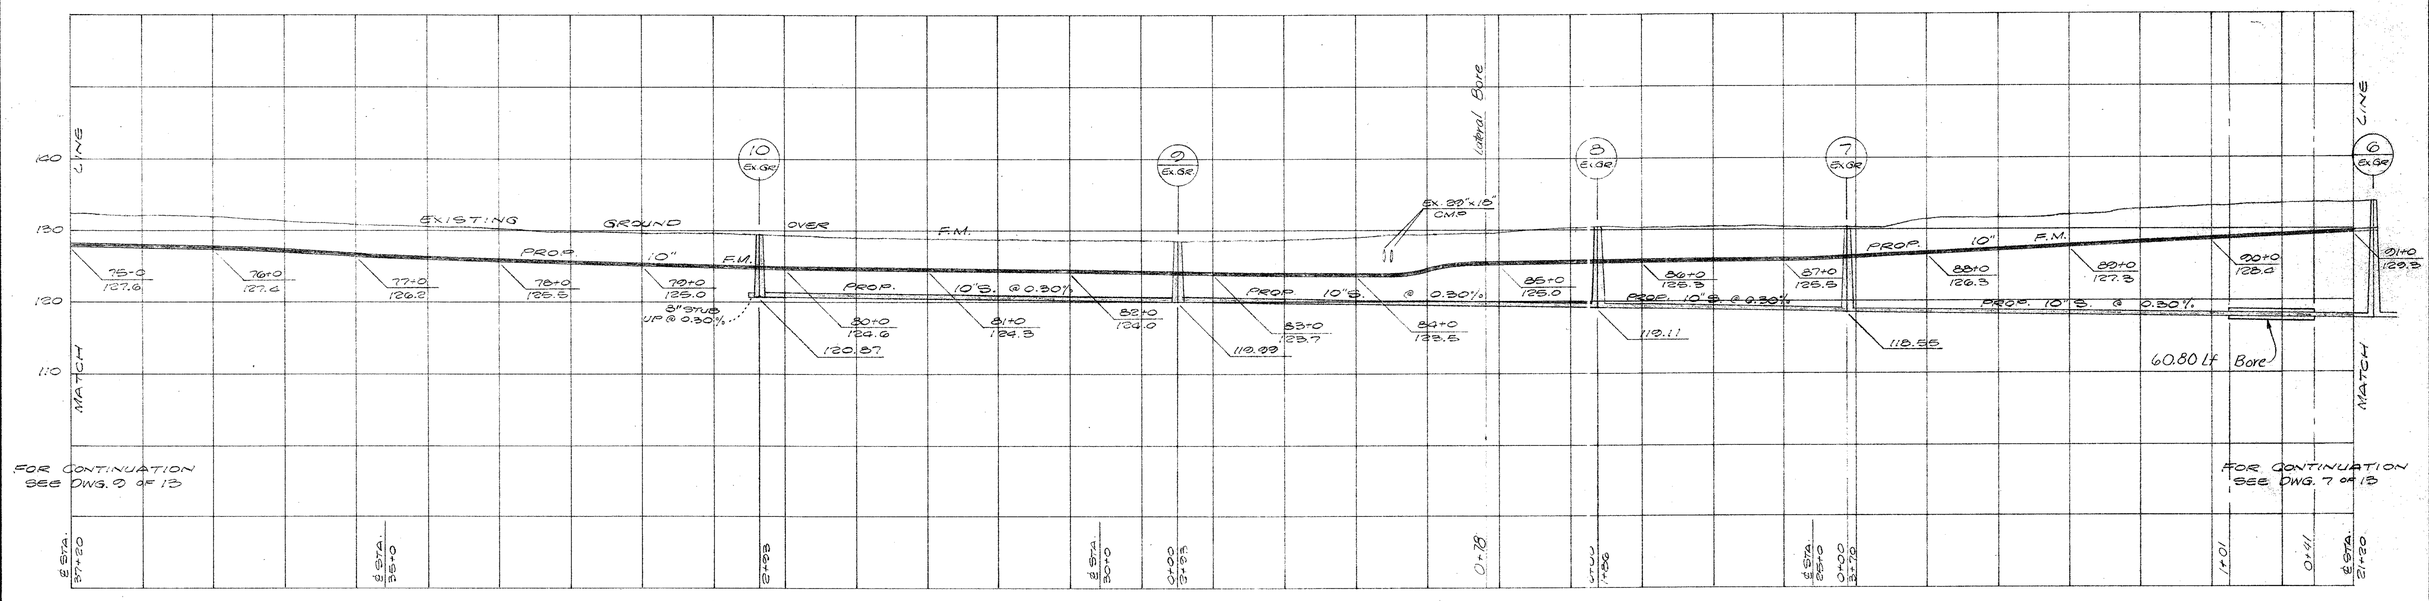

PROFILE SCALES
HOR. 1" = 50'
VERT. 1" = 10'

AS BUILT

PRITCHARD AND ALTMAN
Engineers and Surveyors
Hopewell, Virginia

NO.	DATE	APPR.	REVISION	NO.	DATE	APPR.	REVISION
1	11-15-76		ADD F.F. EL. CO-ORD.				

COMMONWEALTH OF VIRGINIA
JOHN L. COMBS
CERTIFICATE No. 6442
REGISTERED PROFESSIONAL ENGINEER

		DATE
CHECKED		
DES. ENG.		
PROJ. ENG.		
PROJ. MGR.		
APPROVED		
APPROVED		

SUBI-1 Contract-2
PRINCE GEORGE COUNTY, VIRGINIA
UPPER BLACKWATER WASTEWATER
COLLECTION SYSTEM
Route 616 - 10" Force Main Sta. 75+00 to Sta. 91+00
San. Sewer MH 6 to MH 10

ROY F. WESTON
ENVIRONMENTAL SCIENTISTS AND ENGINEERS
LEWIS LANE ▪ WEST CHESTER ▪ PENNSYLVANIA ▪ 19380

PREPARED BY				DWG. NO.
MARYLAND OFFICE				8 OF 13
DRAWN	DATE	SCALE	W. O. NO.	
	AUG. 1976	AS NOTED	1535-01	

SHEET NO.