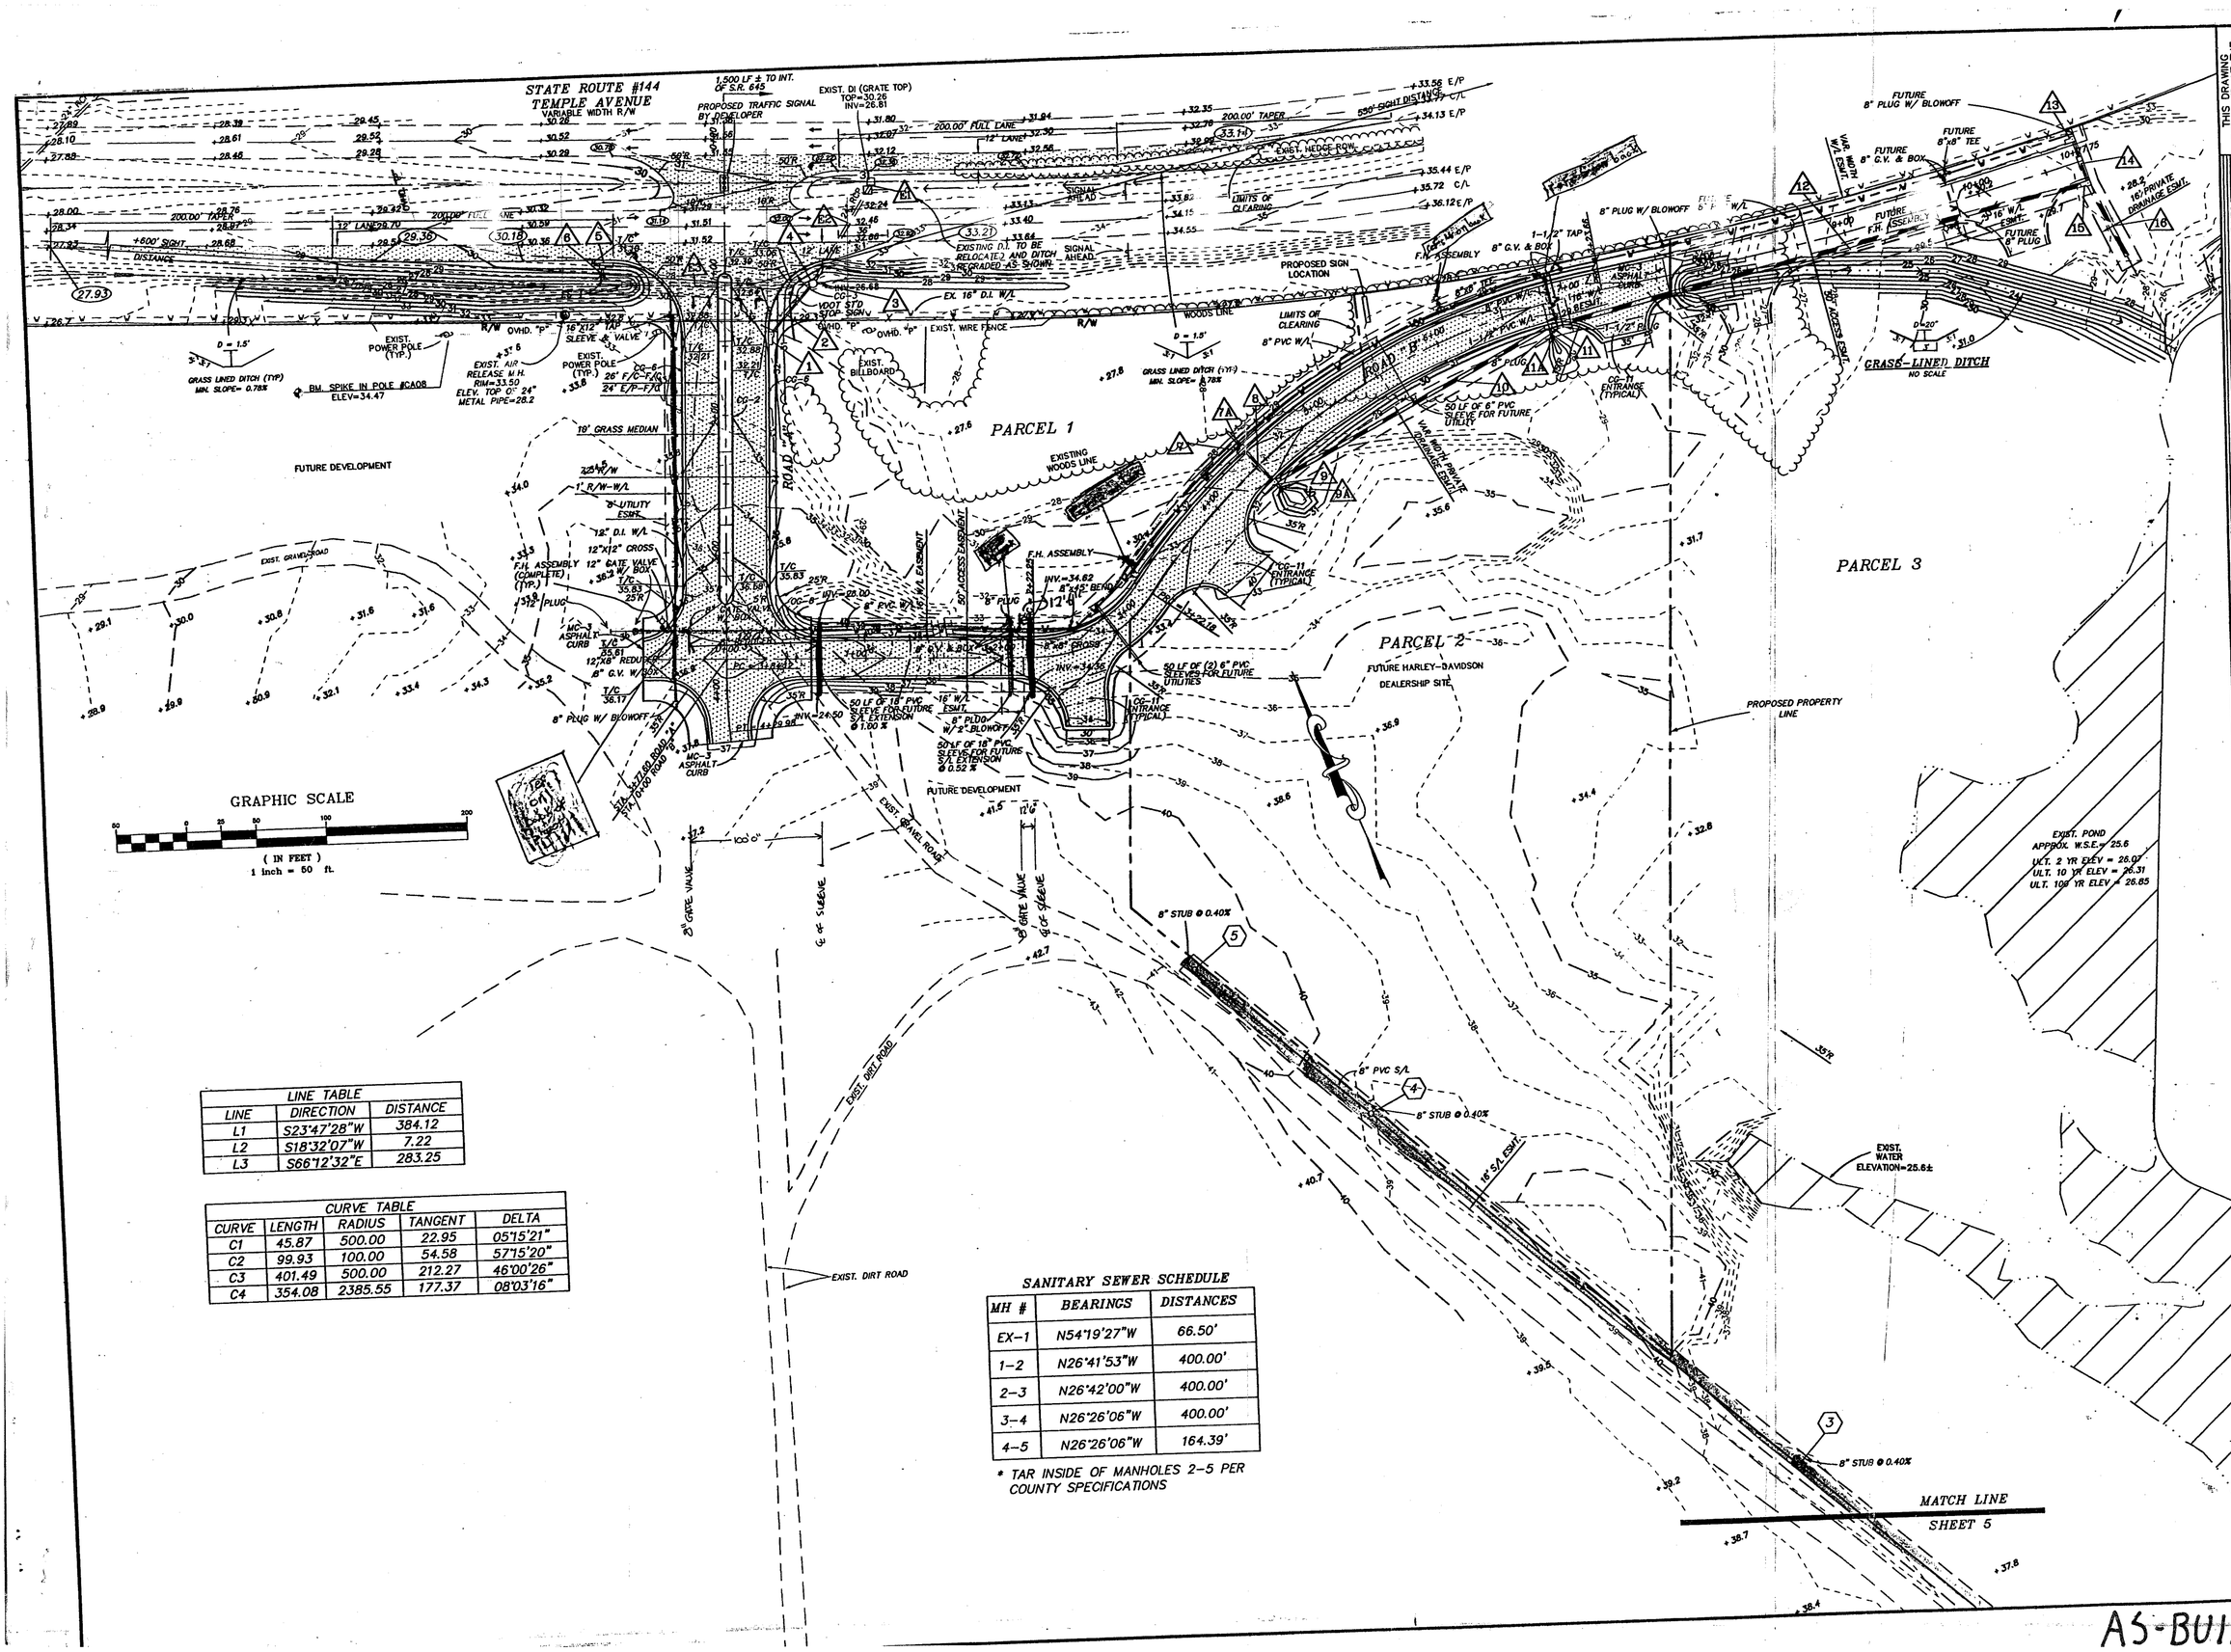

LINE TABLE		
LINE	DIRECTION	DISTANCE
L1	S23°47'28"W	384.12
L2	S18°32'07"W	7.22
L3	S66°12'32"E	283.25

CURVE TABLE				
CURVE	LENGTH	RADIUS	TANGENT	DELTA
C1	45.87	500.00	22.95	05°15'21"
C2	99.93	100.00	54.58	57°15'20"
C3	401.49	500.00	212.27	46°00'26"
C4	354.08	2385.55	177.37	08°03'16"

SANITARY SEWER SCHEDULE

MH #	BEARINGS	DISTANCES
EX-1	N54°19'27"W	66.50'
1-2	N26°41'53"W	400.00'
2-3	N26°42'00"W	400.00'
3-4	N26°26'06"W	400.00'
4-5	N26°26'06"W	164.39'

* TAR INSIDE OF MANHOLES 2-5 PER COUNTY SPECIFICATIONS

THIS DRAWING PREPARED AT THE PRINCE GEORGE COUNTY OFFICE

COMMONWEALTH OF VIRGINIA
DERRICK A. JOHNSON
No. 24761
PROFESSIONAL ENGINEER

OTHER BRANCH OFFICES
Henrico County, VA • 804-262-7386
Hanover County, VA • 804-801-4010
Chesapeake, VA • 757-366-4000
Greensboro, NC • 336-852-0411

CORPORATE OFFICE
711 N. COURTHOUSE ROAD
RICHMOND, VA 23236-3009
Telephone: 804-794-7530
Fax: 804-794-7539
Web Site: www.timmons.com
e-mail: timmons@timmons.com

DATE	COUNTY COMMENTS
1-22-02	COUNTY AND OWNER REVISIONS
2-25-02	COUNTY REVISIONS
3-5-02	

DATE 11-19-01
DRAWN BY B CRUTCHFIELD
DESIGNED BY B CRUTCHFIELD
CHECKED BY D. JOHNSON
SCALE 1" = [redacted]

TIMMONS

Founded 1953

ENGINEERS * SURVEYORS * PLANNERS * LANDSCAPE ARCHITECTS * ENVIRONMENTAL SCIENTISTS * GEOGRAPHIC INFORMATION SYSTEMS CONSULTANTS

WHITEHILL TRACT INFRASTRUCTURE PLAN

PRINCE GEORGE, VIRGINIA

SITE AND UTILITY PLAN

JOB NO. 65728

SHEET NO. 4

These plans and copyrighted documents are the exclusive property of TIMMONS and may not be reproduced in whole or in part and shall not be used for any purpose whatsoever, anywhere, but not limited to construction, bidding, or construction staking without the express written consent of TIMMONS.

AS-BUILTS